


5/85

1855.82

109

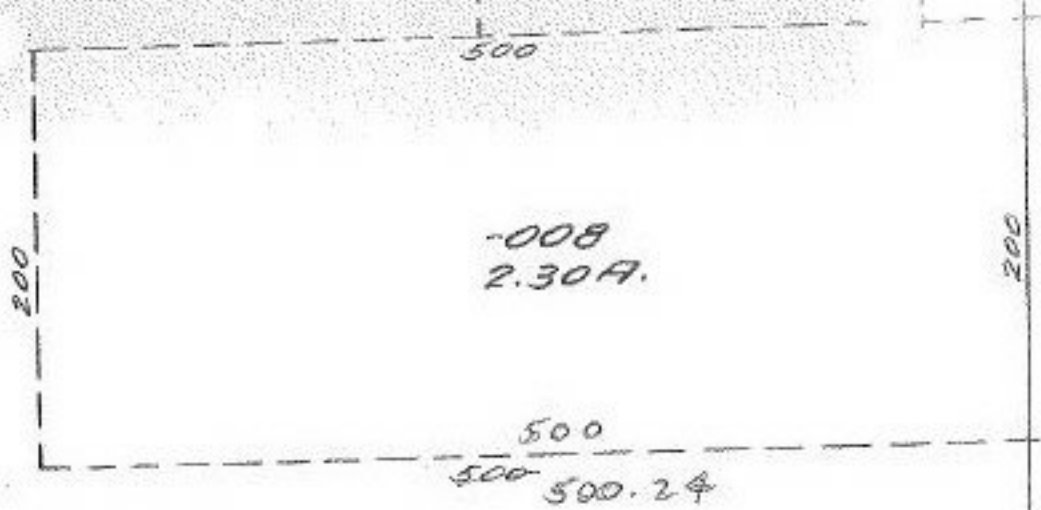

Change No & Acre.
on Page 2-02-005-A.

SEP 9 1970

5185

APPROVED
LORAIN CO.
MAP DEPT.
DATE 8-11-71
2-02-005-B-A.
BY *[Signature]*

-061
Pt. -007
Pt. ~~3738A~~
37.79A.




7-14-55

~~3751~~

104
32
~~102~~

1837.16

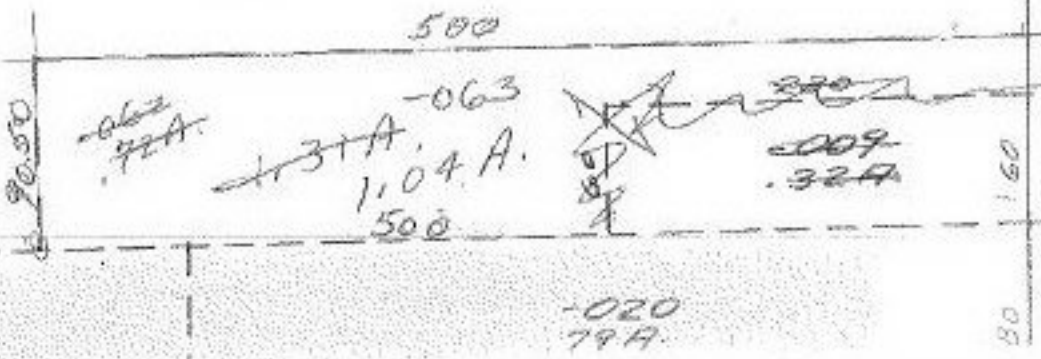

104.90

80