


SEP 9 1970

APPROVED
 LORAIN CO.
 MAP DEPT.
 DATE 8-11-71
 02-01-004D
 By LW Hall 1398

ABLR41N

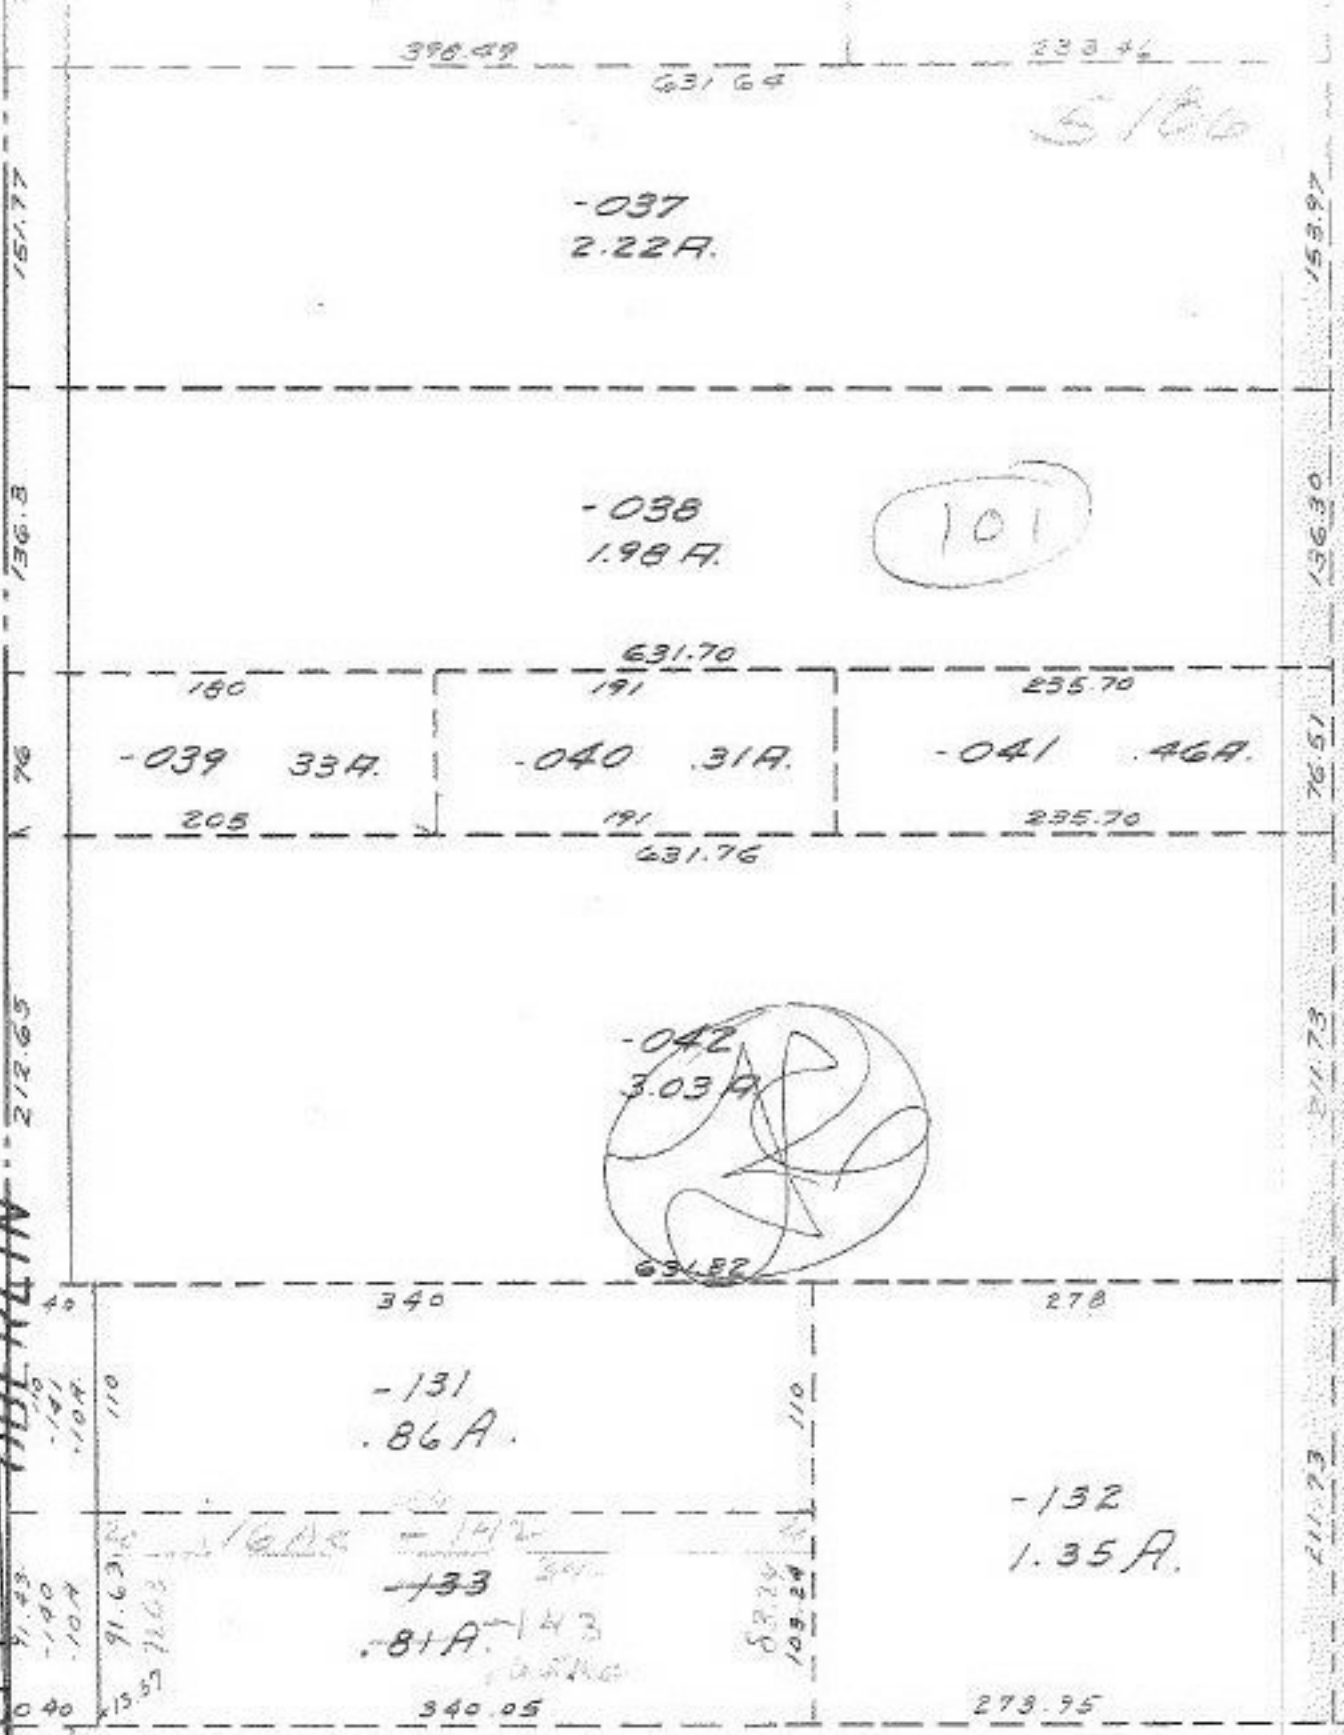

SEE 2-6

BLACK RIVER TWP.

SCALE: 1" = 100'

81
 16
 65

7-18-86
 5.5

81
 16
 65