


SEP 13 1970

5188

APPROVED  
LORAIN CO.  
MAP DEPT.

DATE 8-18-71  
9-00-095-A  
BY *[Signature]*

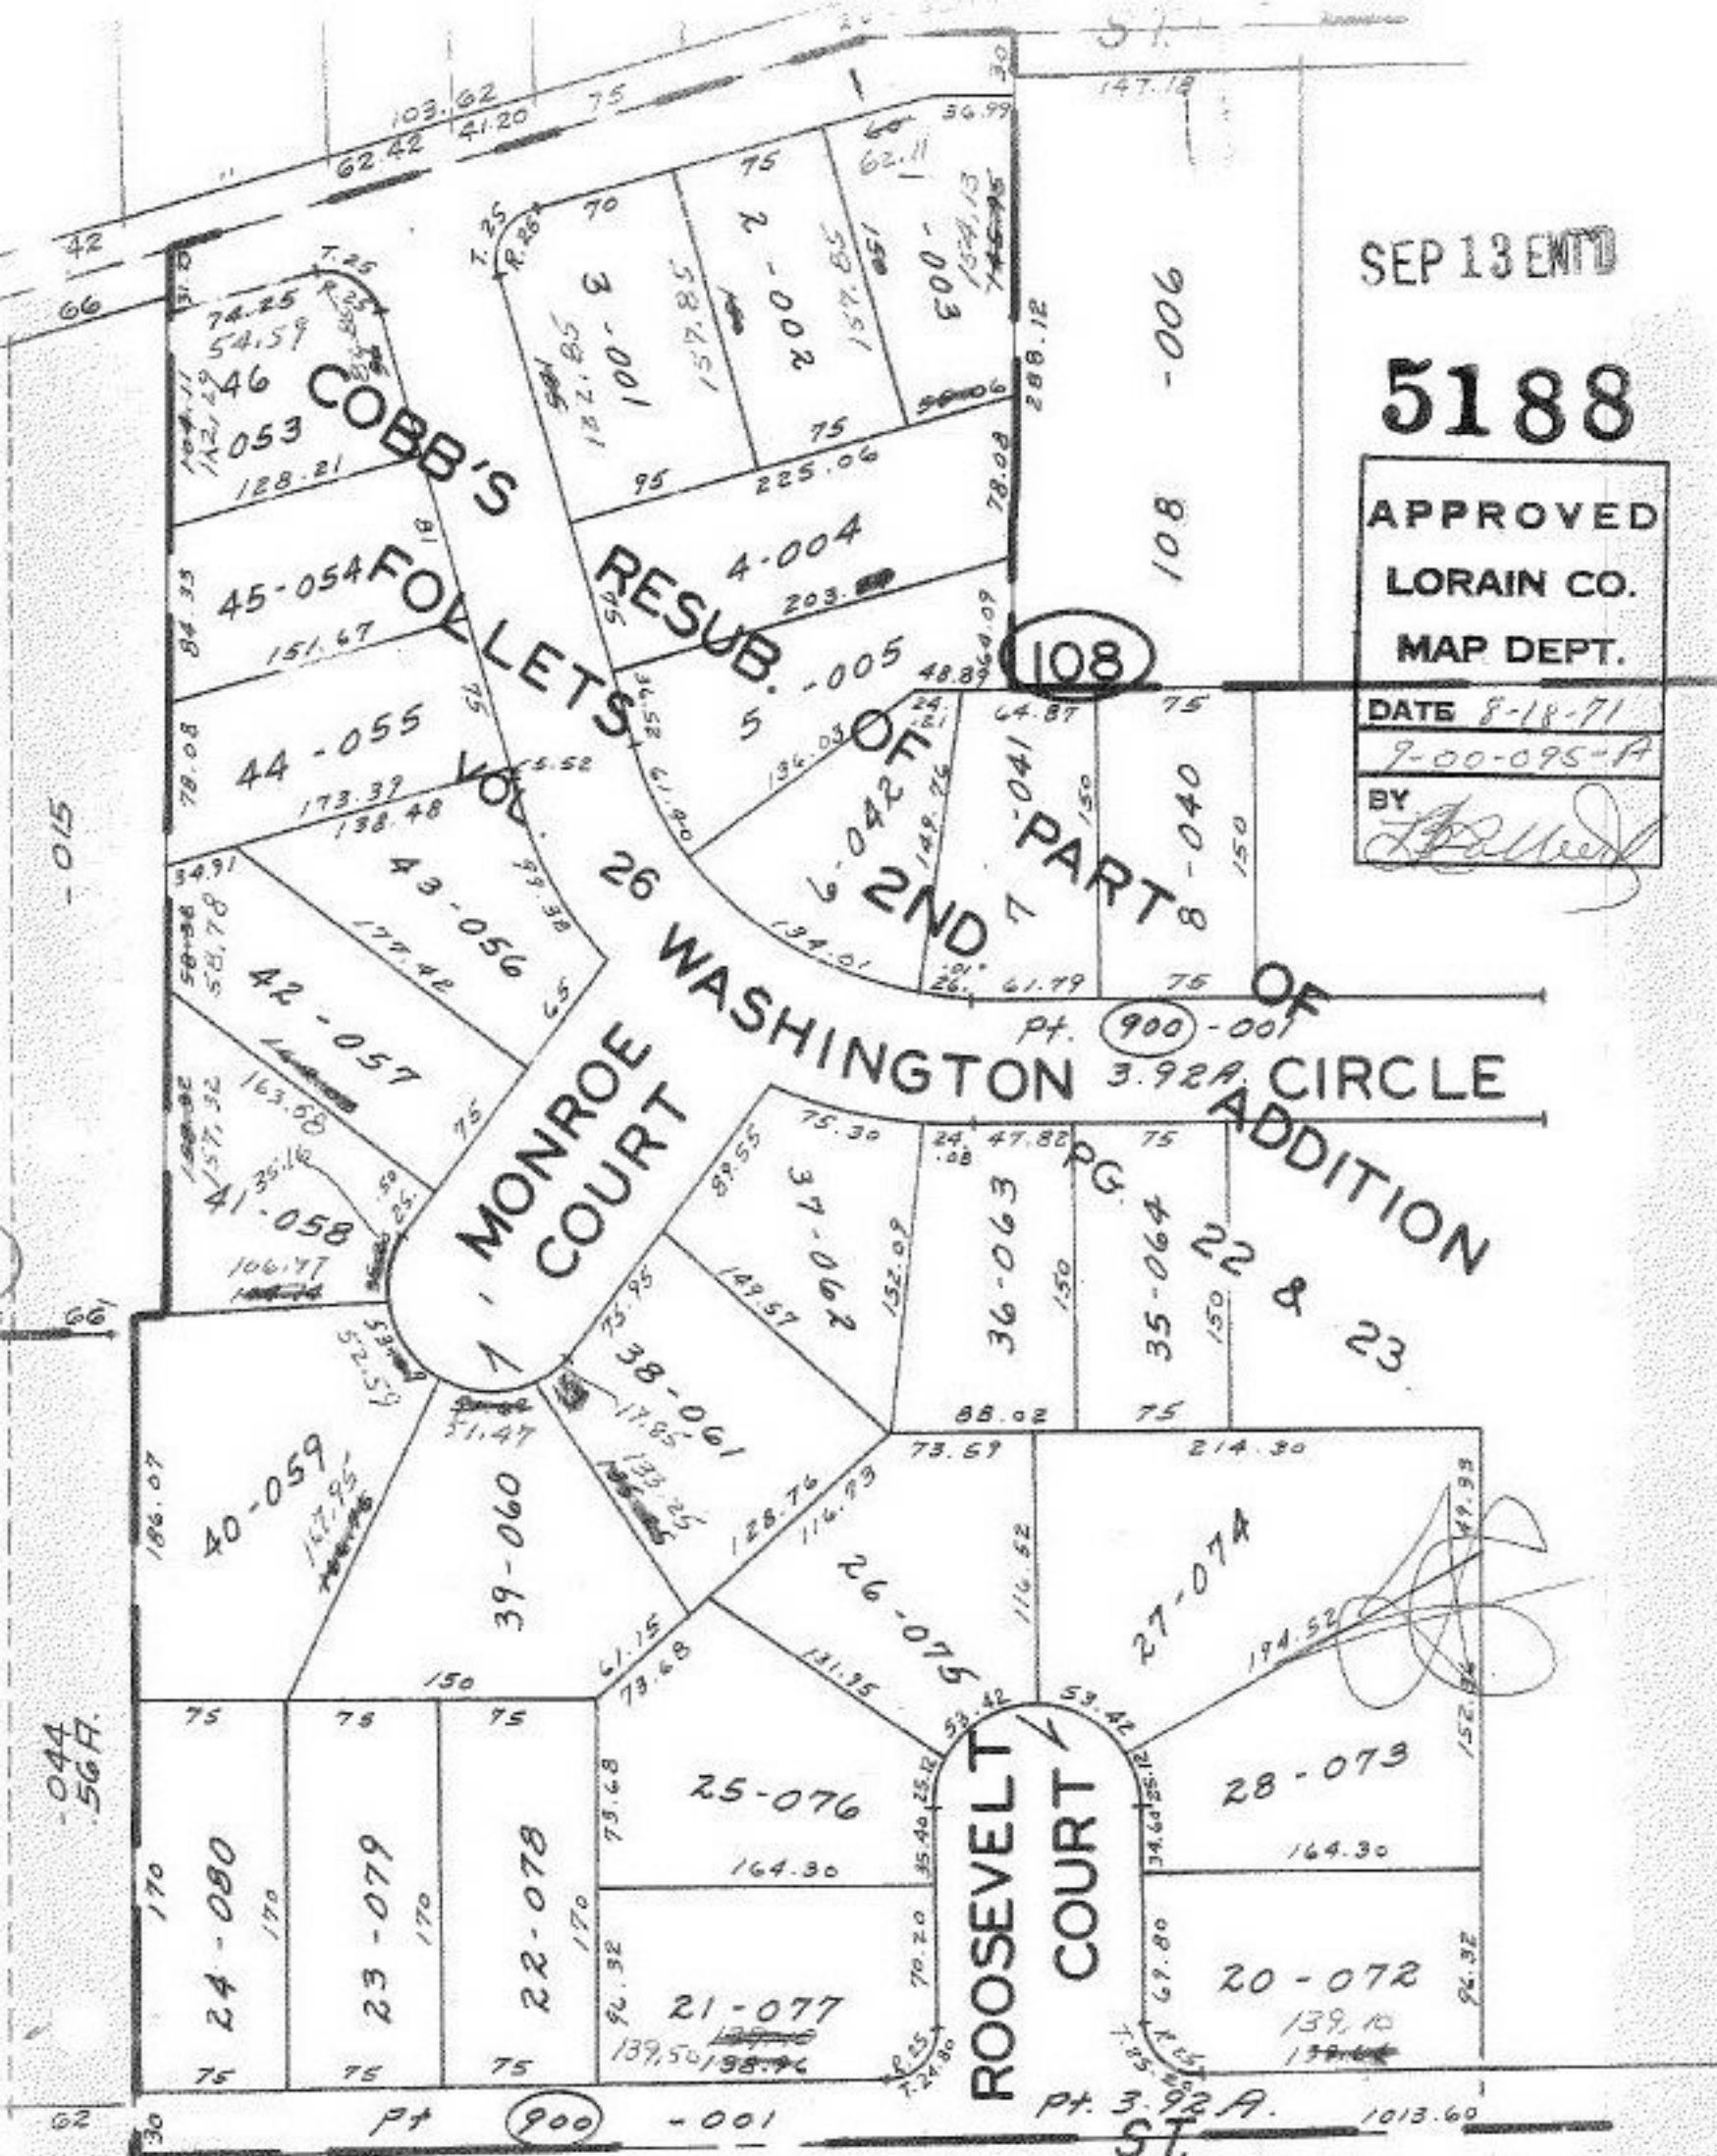

108

108 - 006

pt. 900 - 001

pt. 3.92A

pt. 900 - 001

1013.60

0-105-A