


ADDN.

73.5

10

106

IND. 10

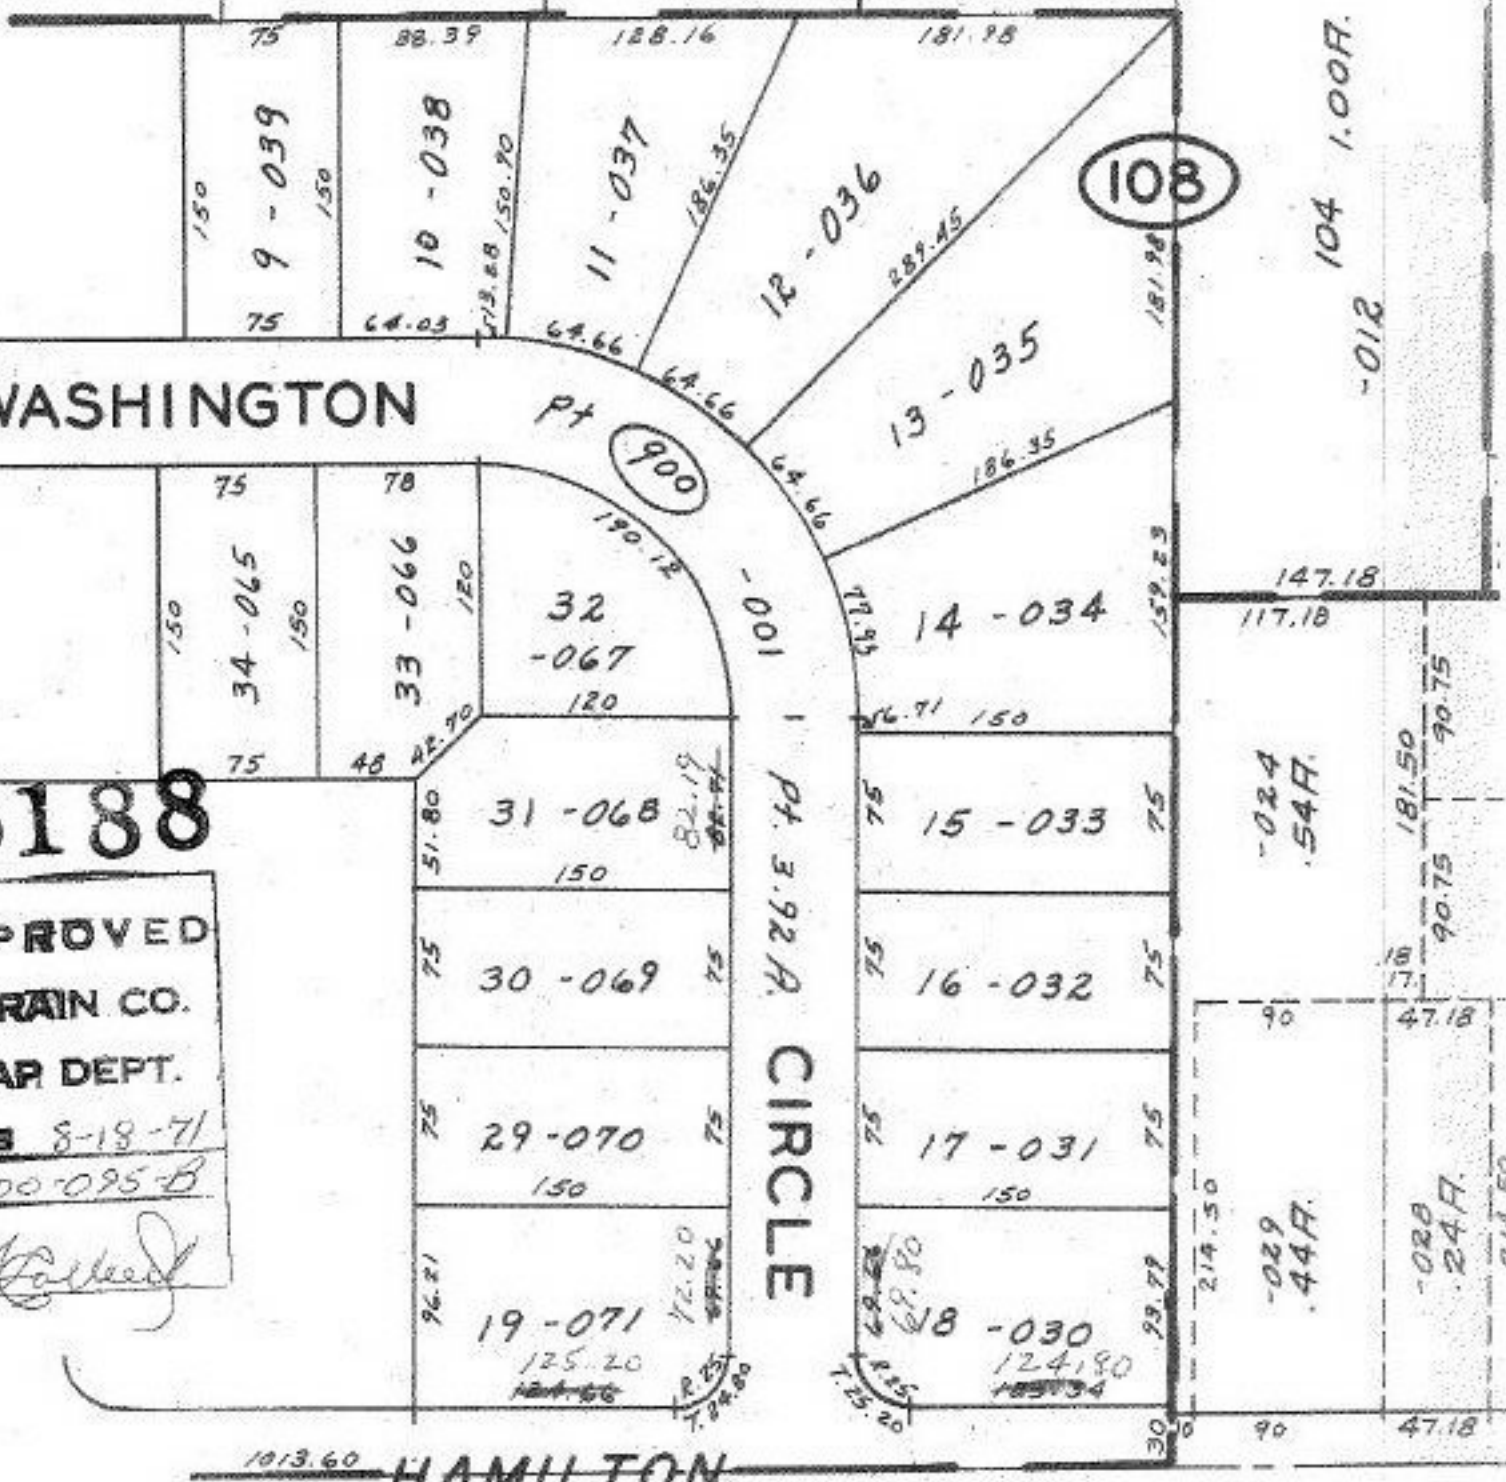

5188

APPROVED  
 ORAIN CO.  
 MAP DEPT.  
 DATE 8-18-71  
 9-00-095-B  
 BY *Kalkeed*

*[Signature]*

RUSSIA TWP.

SCALE: 1" = 100'