


5190

7-17-86 L.L.

APPROVED
LORAIN CO.
MAP DEPT.
DATE 8/12/71
7-00-022-C
BY <i>[Signature]</i>

SEP 10 ENTU

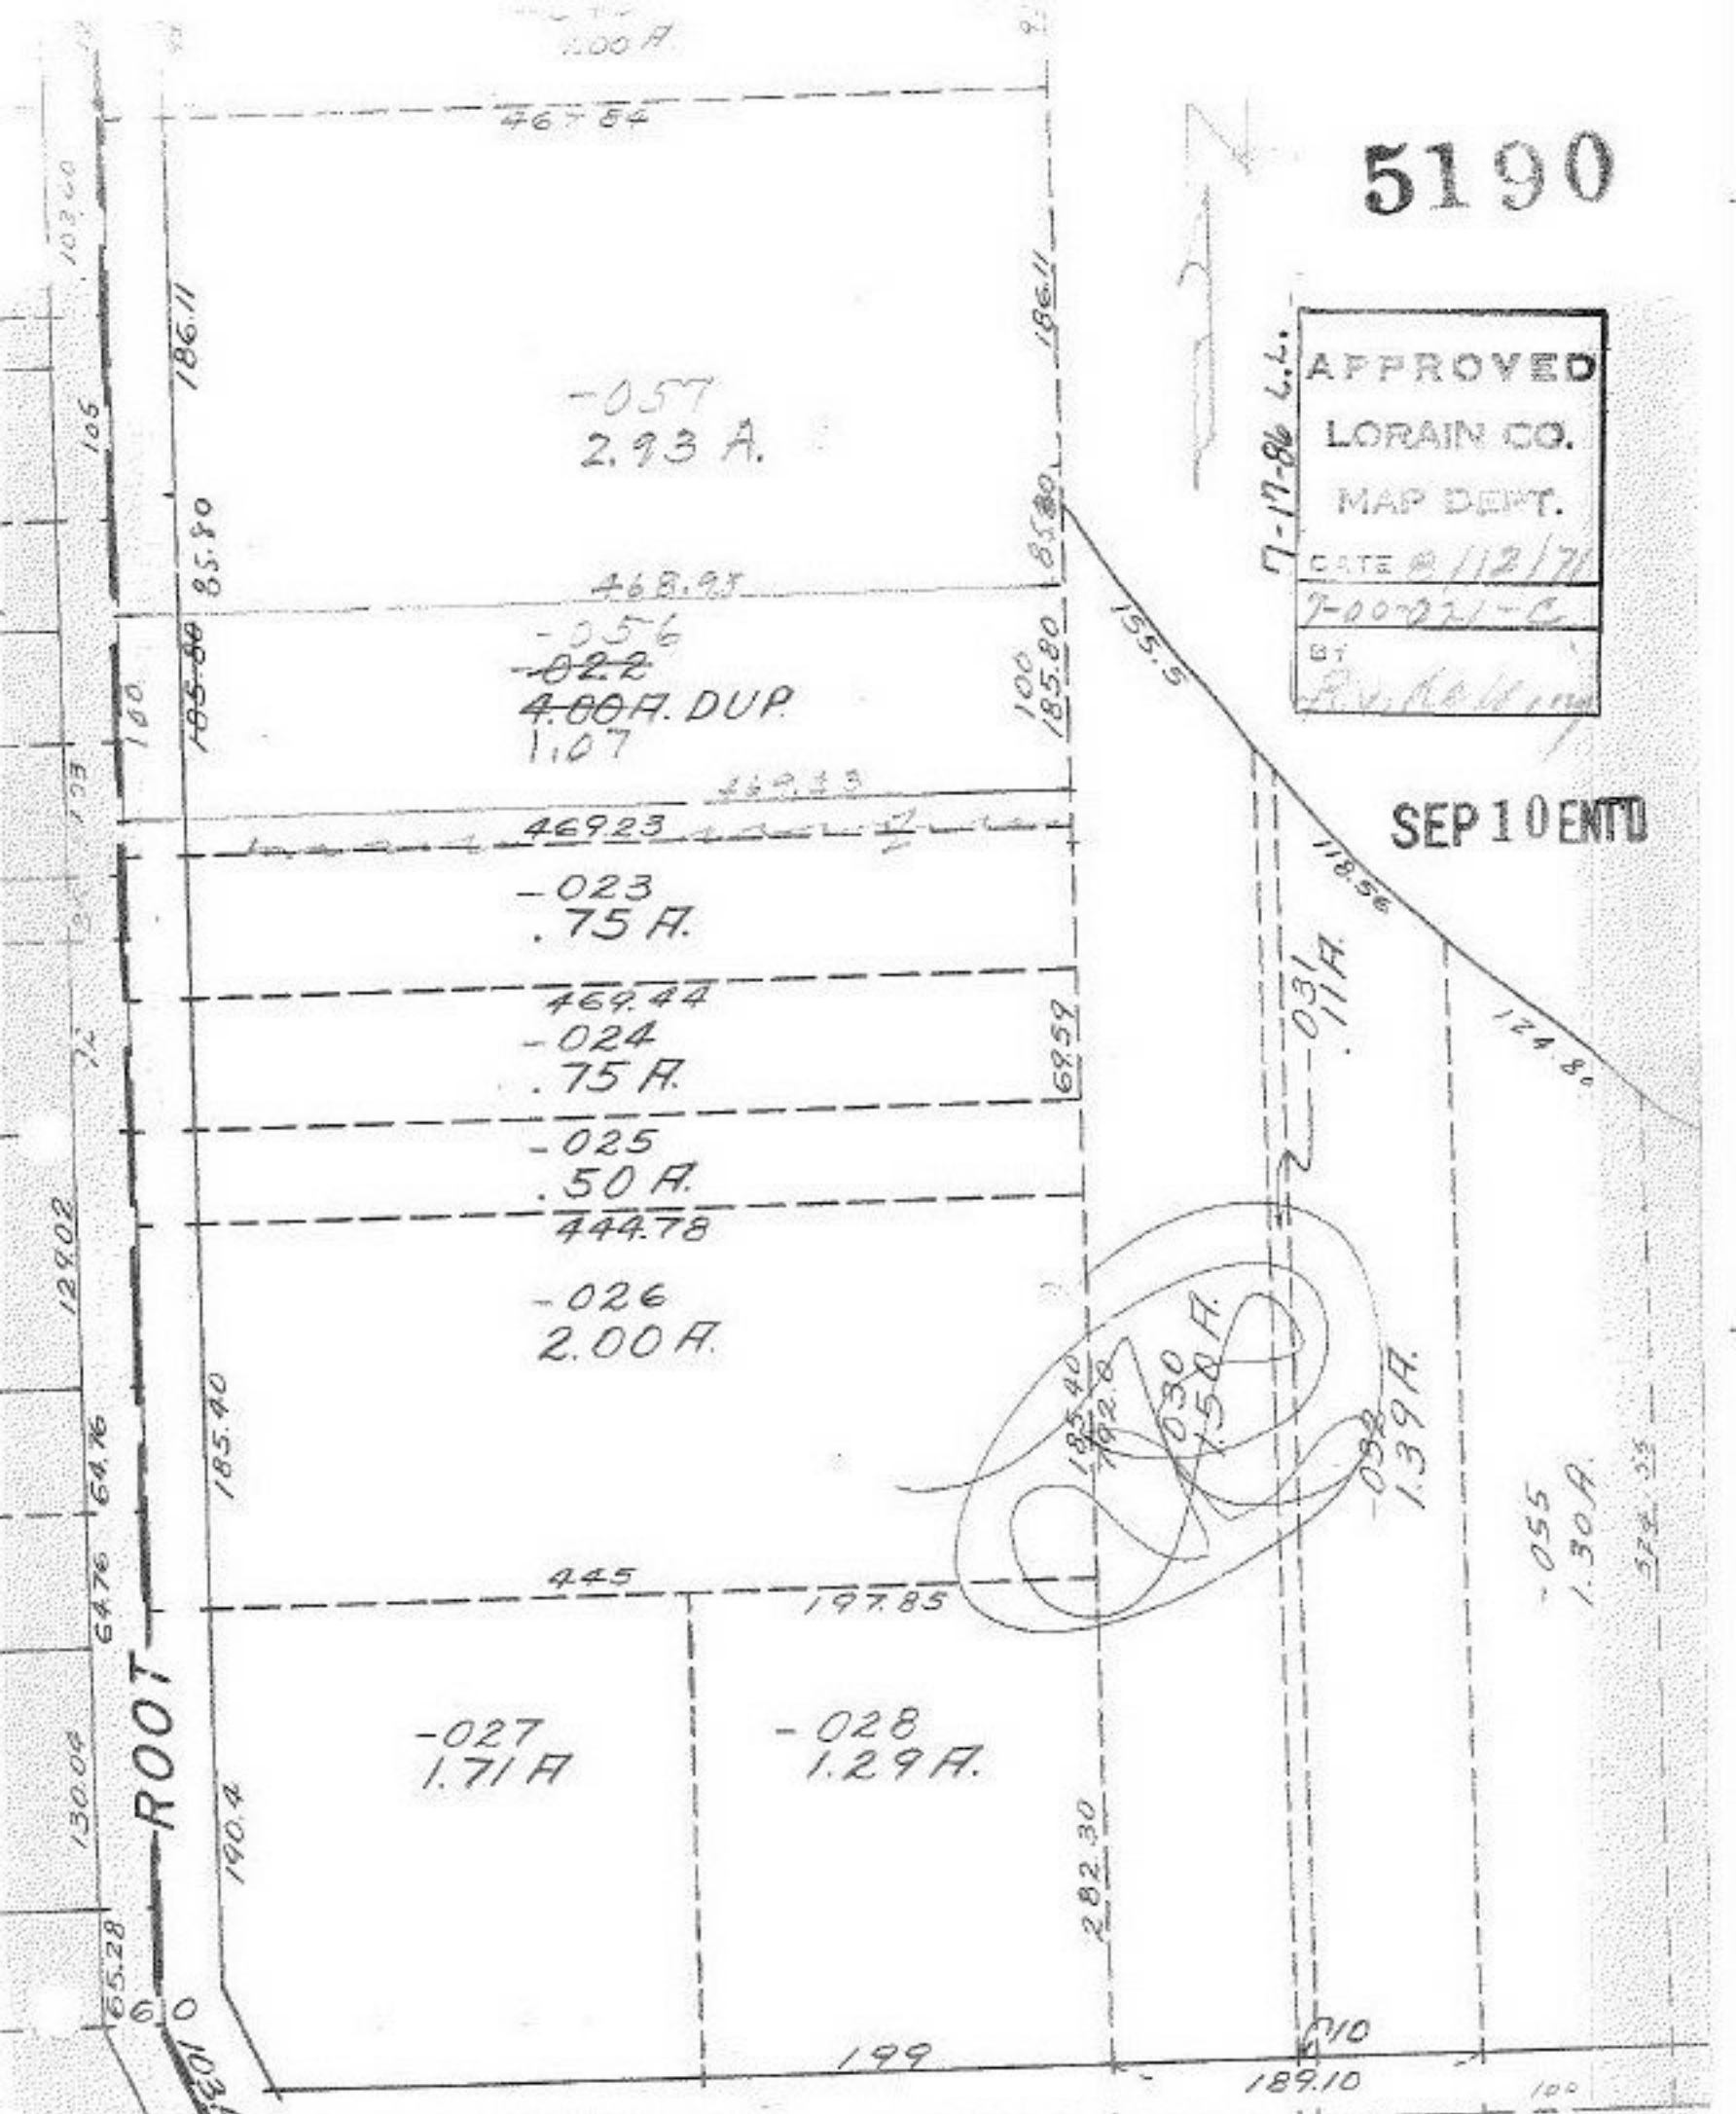

-057  
2.93 A.

468.95  
-056  
~~-022~~  
4.00 A. DUP.  
1.07

469.23  
-023  
.75 A.

469.44  
-024  
.75 A.

-025  
.50 A.  
444.78

-026  
2.00 A.

-027  
1.71 A.

-028  
1.29 A.

185.40  
192.8  
0.30  
1.50 A.  
1.39 A.

-055  
1.30 A.

BAINBRIDGE

SEE 7-00-022-B