


029  
030

5191

Ralph

JOHN  
JOEY  
258-353

Note This Map Needs  
Correction This Area RD.

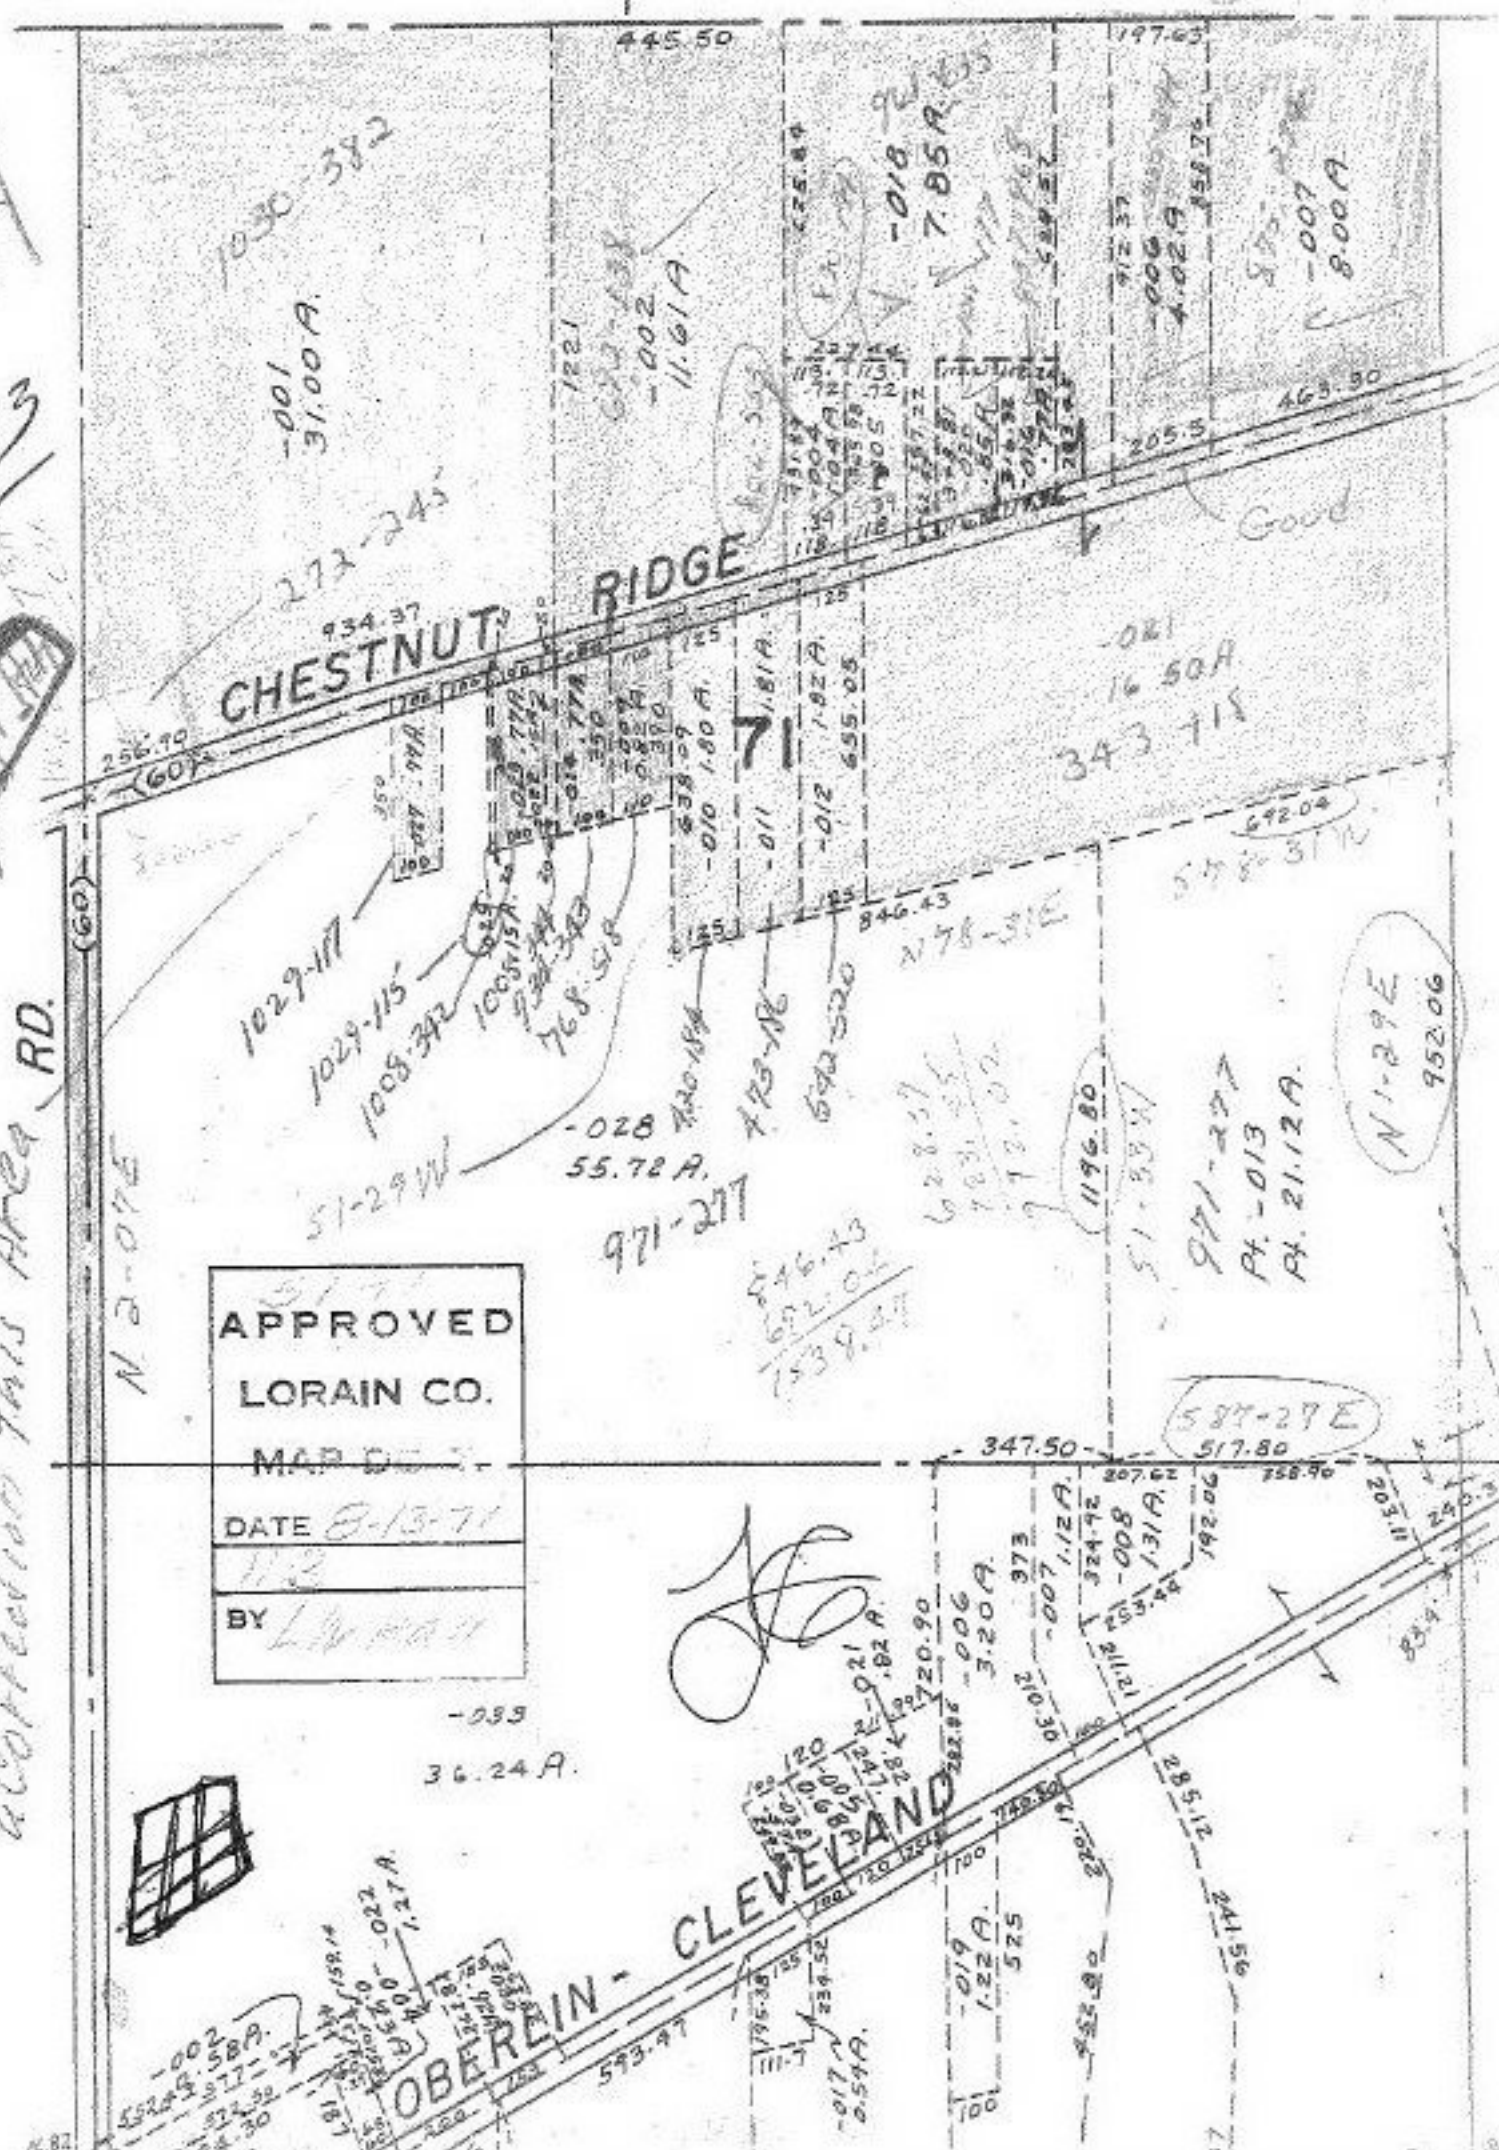

APPROVED  
LORAIN CO.  
MAP DATE 8-13-71  
BY

CLEVELAND

OBERRIN - CLEVELAND

N 1-29 E  
952.06

587-27 E  
517.80

1196.80  
51-55 W

971-227  
R. - 013  
R. 21.12 A.

343 118  
16.50 A  
- 021

971-217  
55.72 A.  
- 028

246.43  
692.01  
1538.87

628.37  
783.25  
772.02

655.25  
1.82 A.  
- 012

7.85 A.  
- 018

272-245

1001-100 A.

1030-382

CHESTNUT RIDGE

Good

N 2-07 E

256.70  
(60)

1221

445.50

197.63

463.90

205.3

620.4

4.02 A

558.76

912.57

625.84

225.84

12.7

12.7

