


5211

SEE 6-1
1386.96

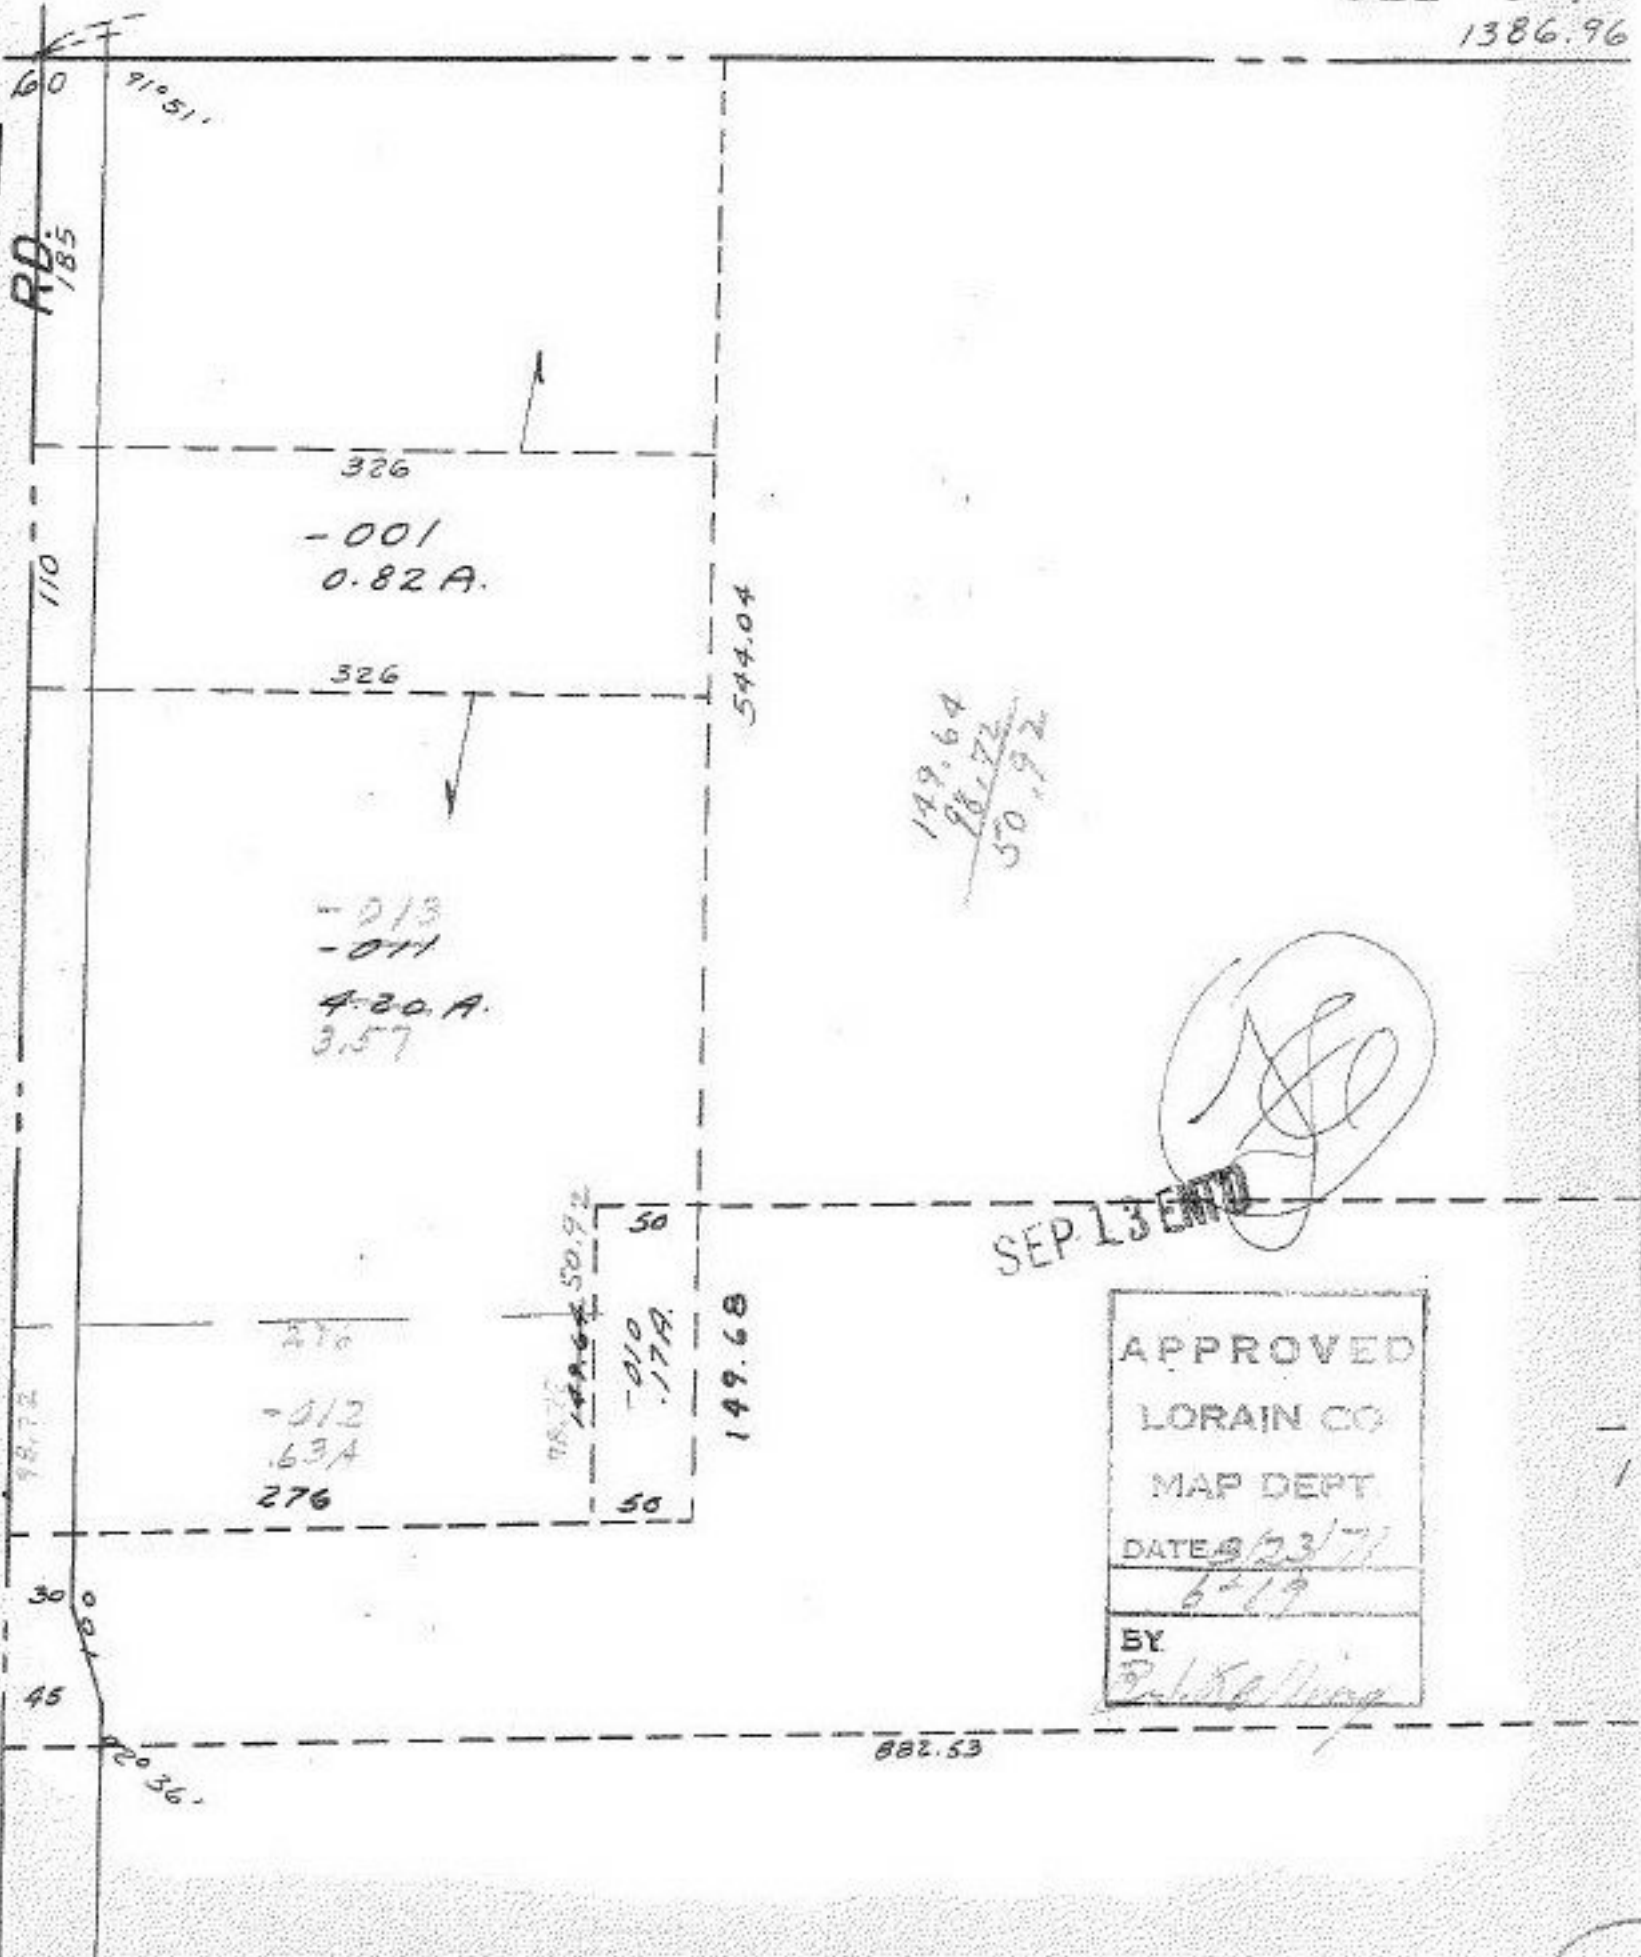

SEE 5 00-082-B