

5218

-027
4.04A


-031
~~0.50~~
~~2.50A~~
2.07

-016
2.31A

-032
~~0.79~~
~~9.46A~~
6.72

-030
2.87A

SEP 23 1971

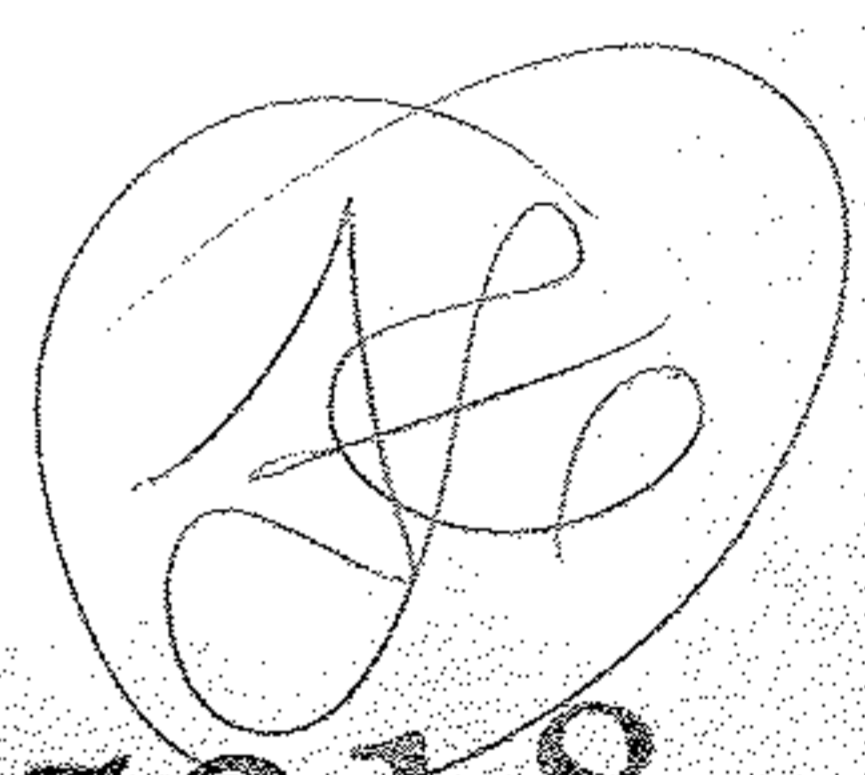

5218

APPROVED
LORAIN CO.
MAP DEPT.
DATE 8/27/71
0100-021-B
BY R. J. Kelly

CLAUS