

5240

BIGGS

(60)

242
-003
200A
360
100
80
242

300

1188

1320

X=0
-004
360
400

~~-004~~ -005
~~-001~~
77.60A.
5.35

-002
40.00A.

-001
65.52

37

5240


SEP 23 1971

7.7
9880

2640

-003
50.00A.

APPROVED
LORAIN CO.
MAP DEPT.
DATE 9/11/71
15-A
BY R. J. Kelling

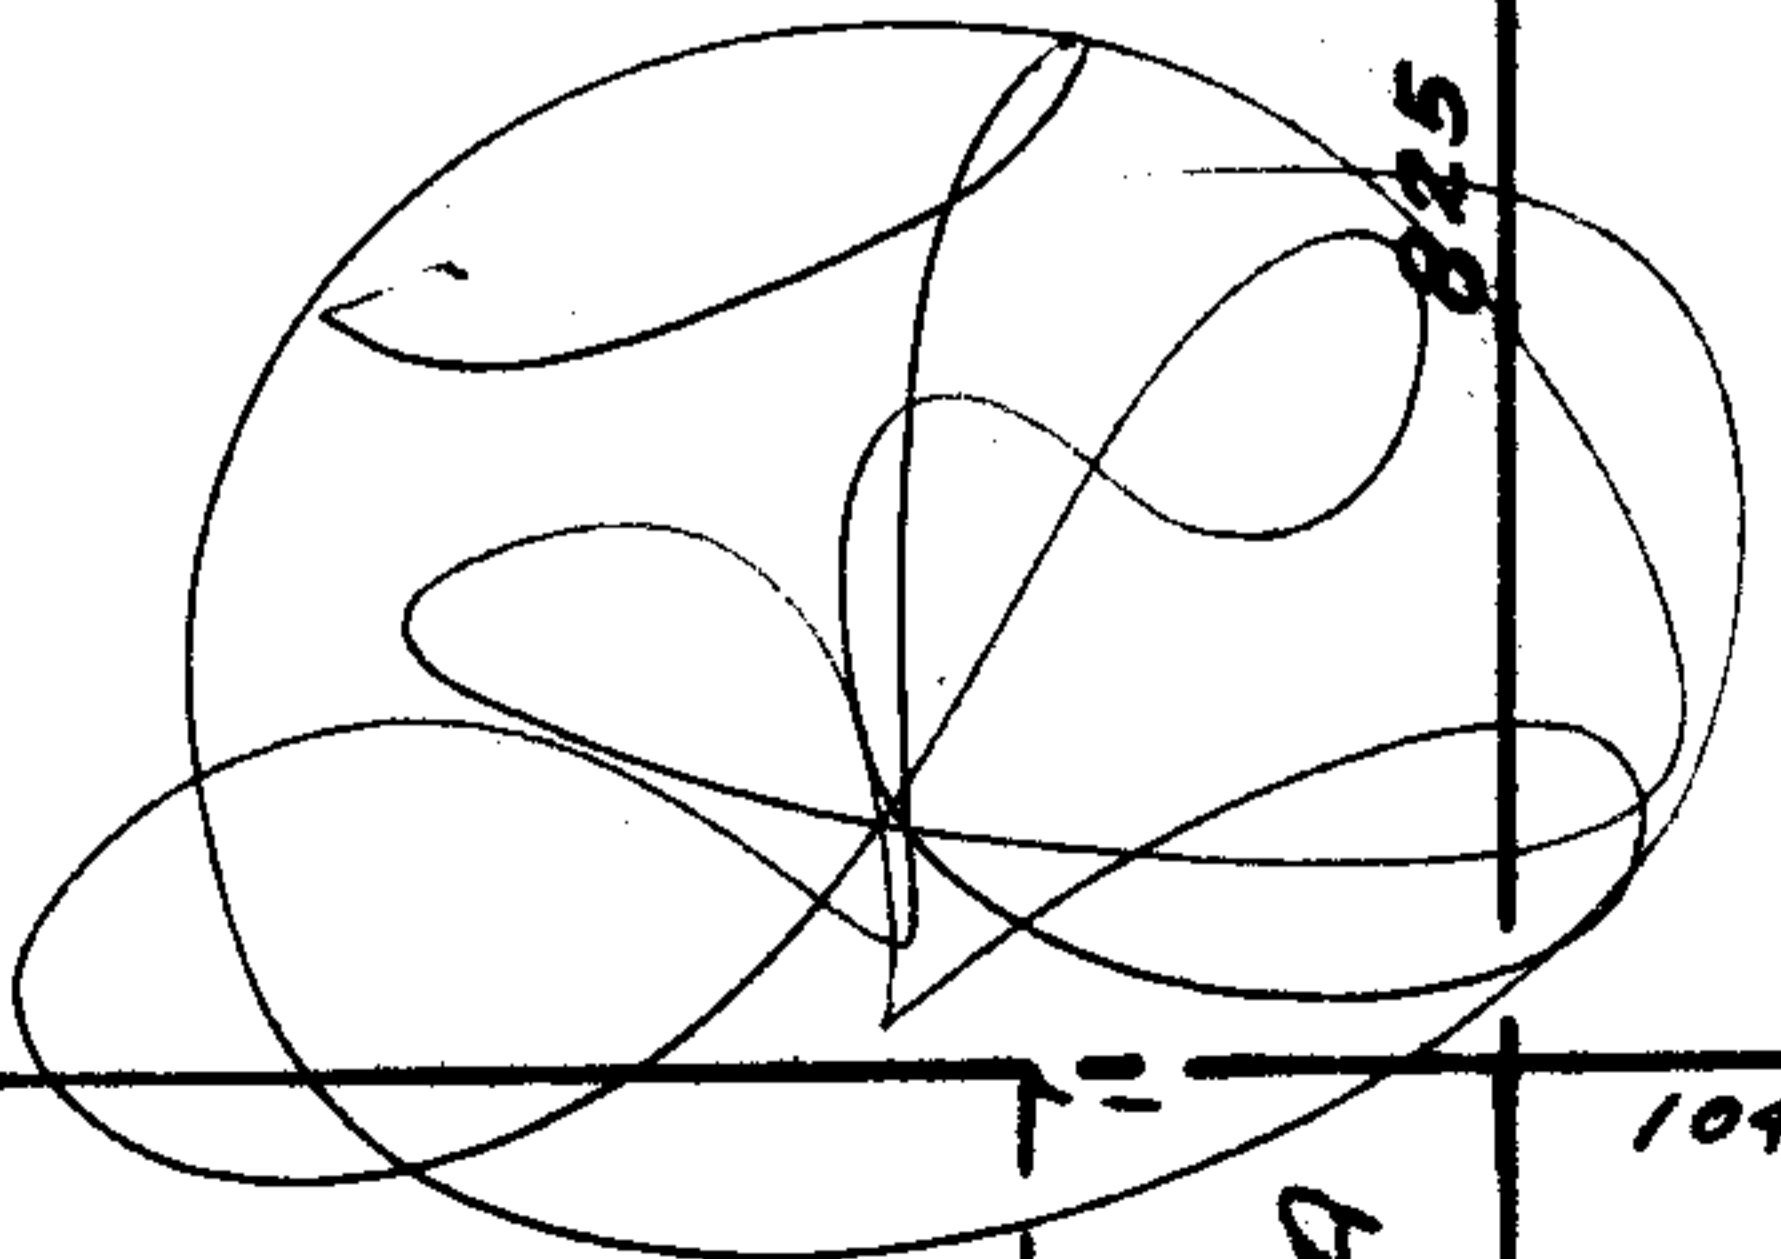

825

825

2640

1043

-006
3.67A