



5242

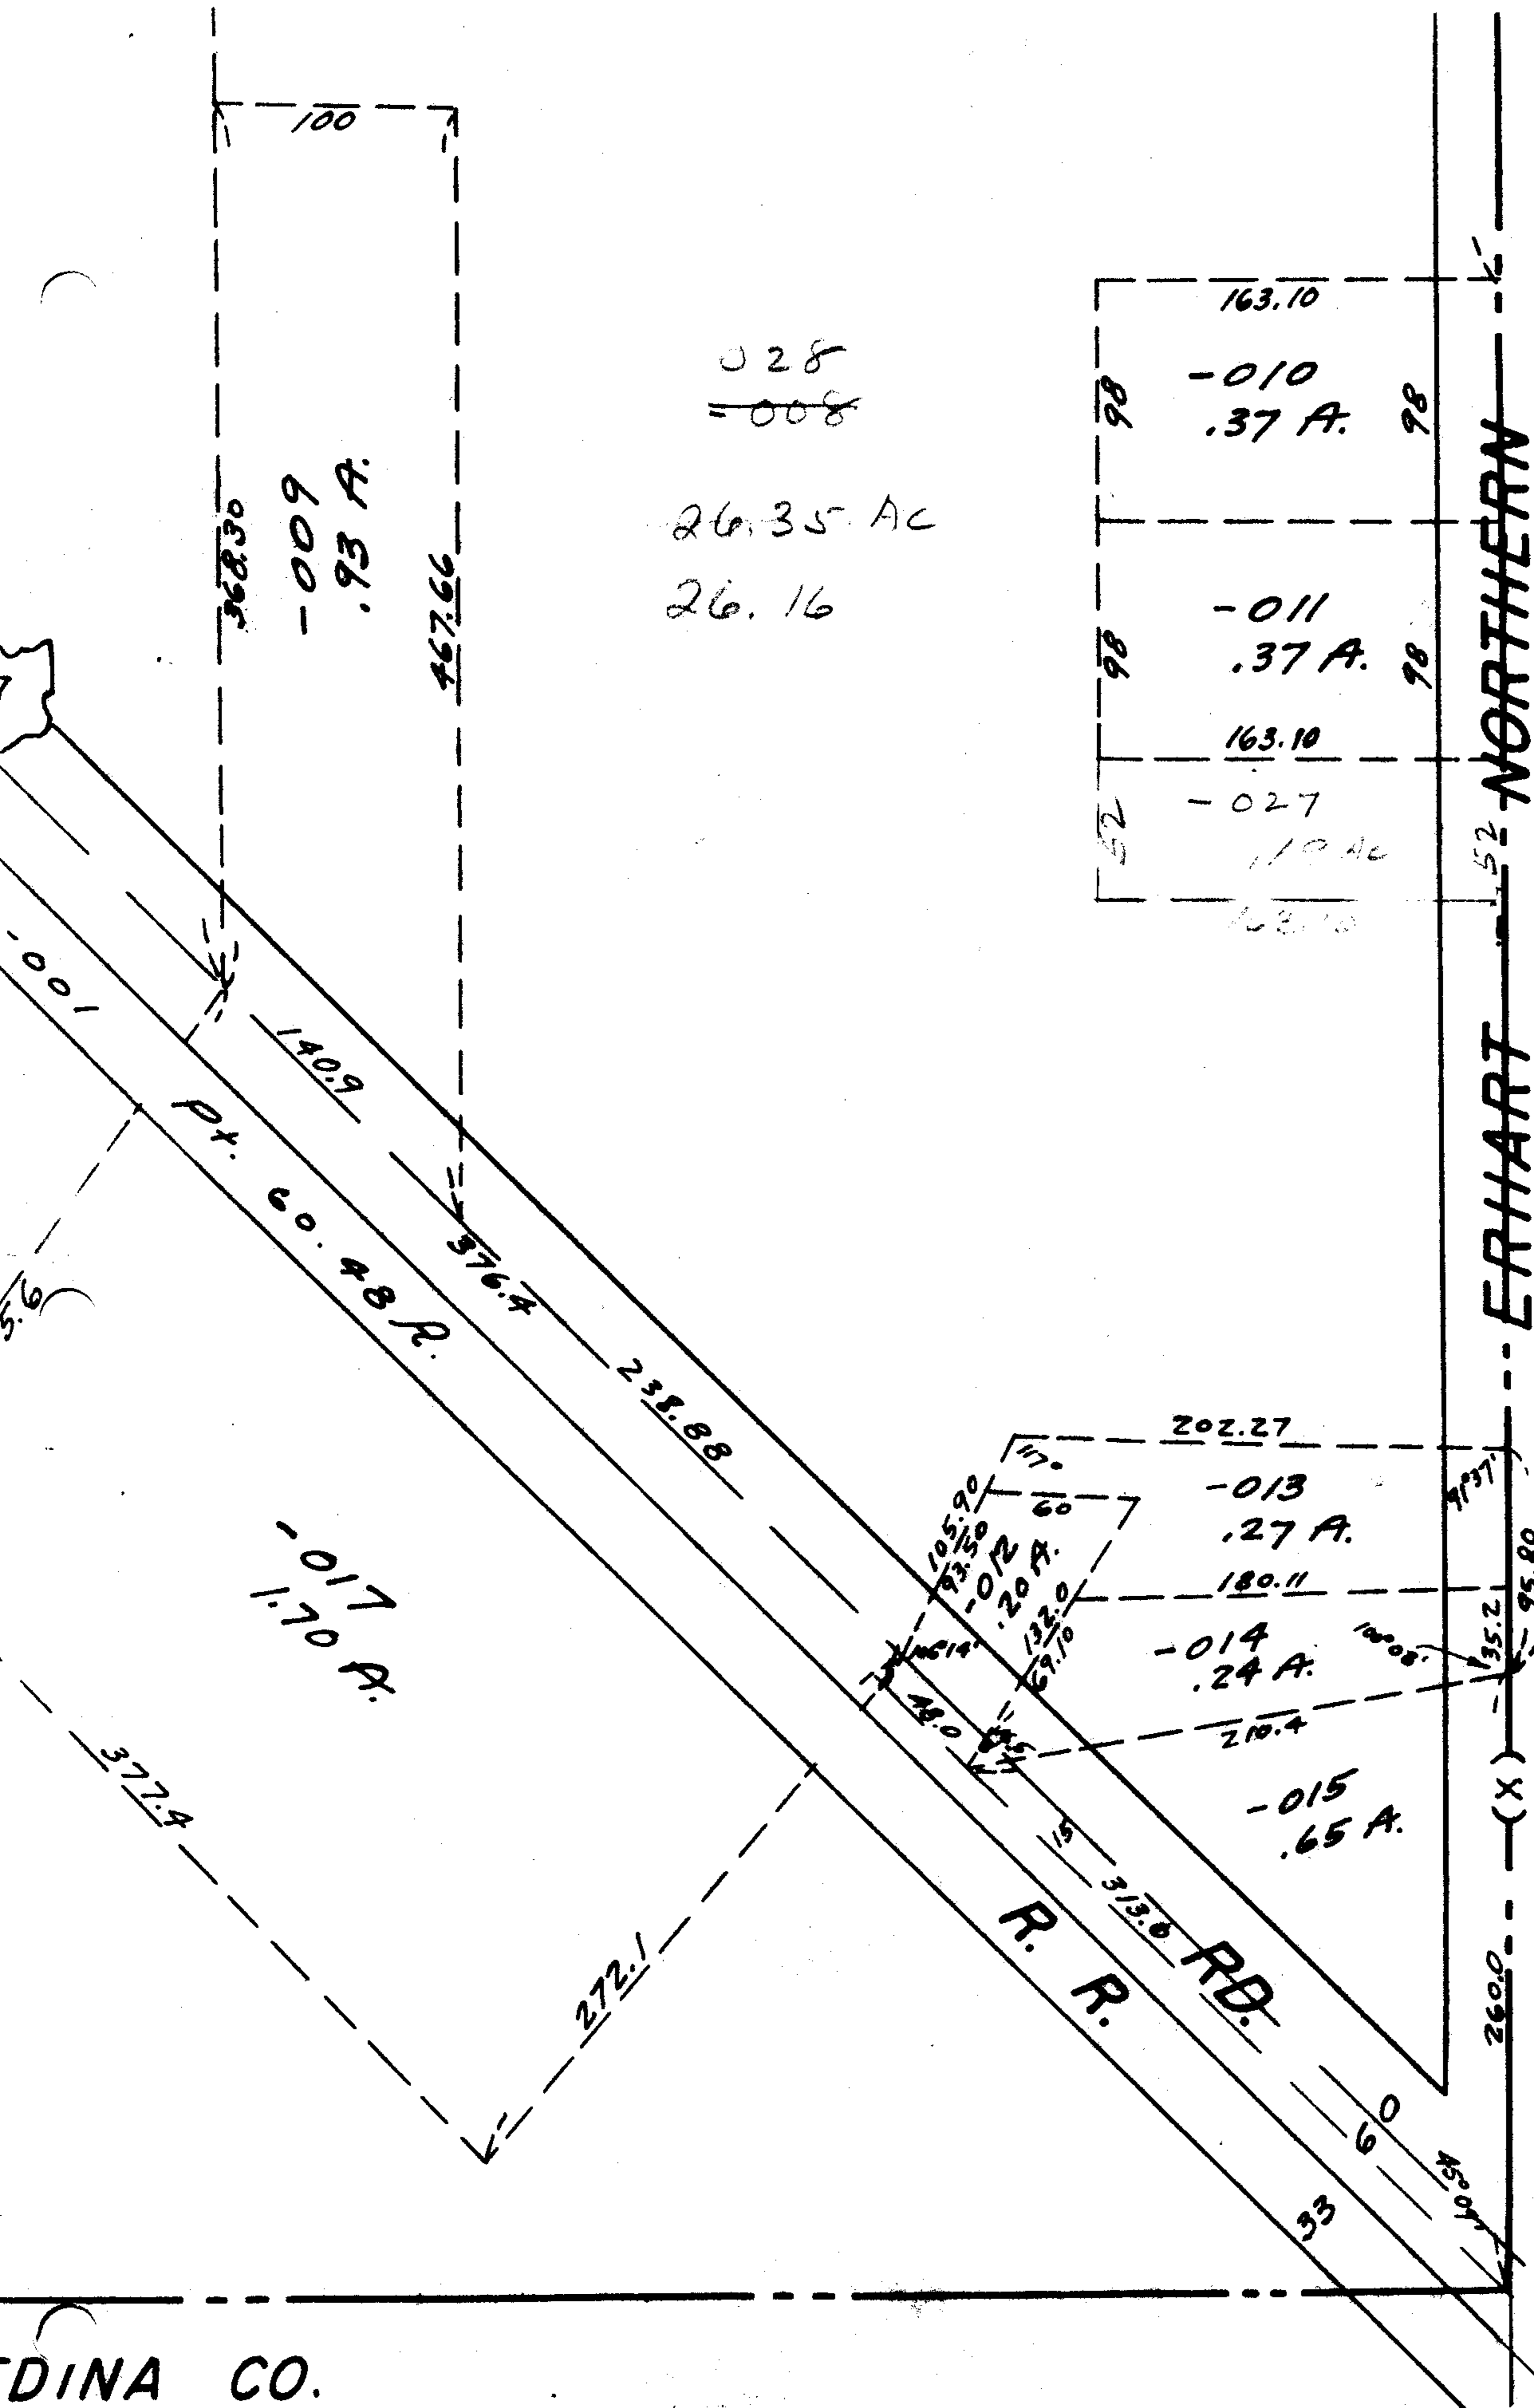

028  
~~008~~  
 26.35 AC  
 26.16

98	163.10	98
	-010	
	.37 A.	
98	163.10	98
	-011	
	.37 A.	
52	163.10	52
	-027	
	1.9 AC	
	163.10	

26.35  
 19  
 26.16

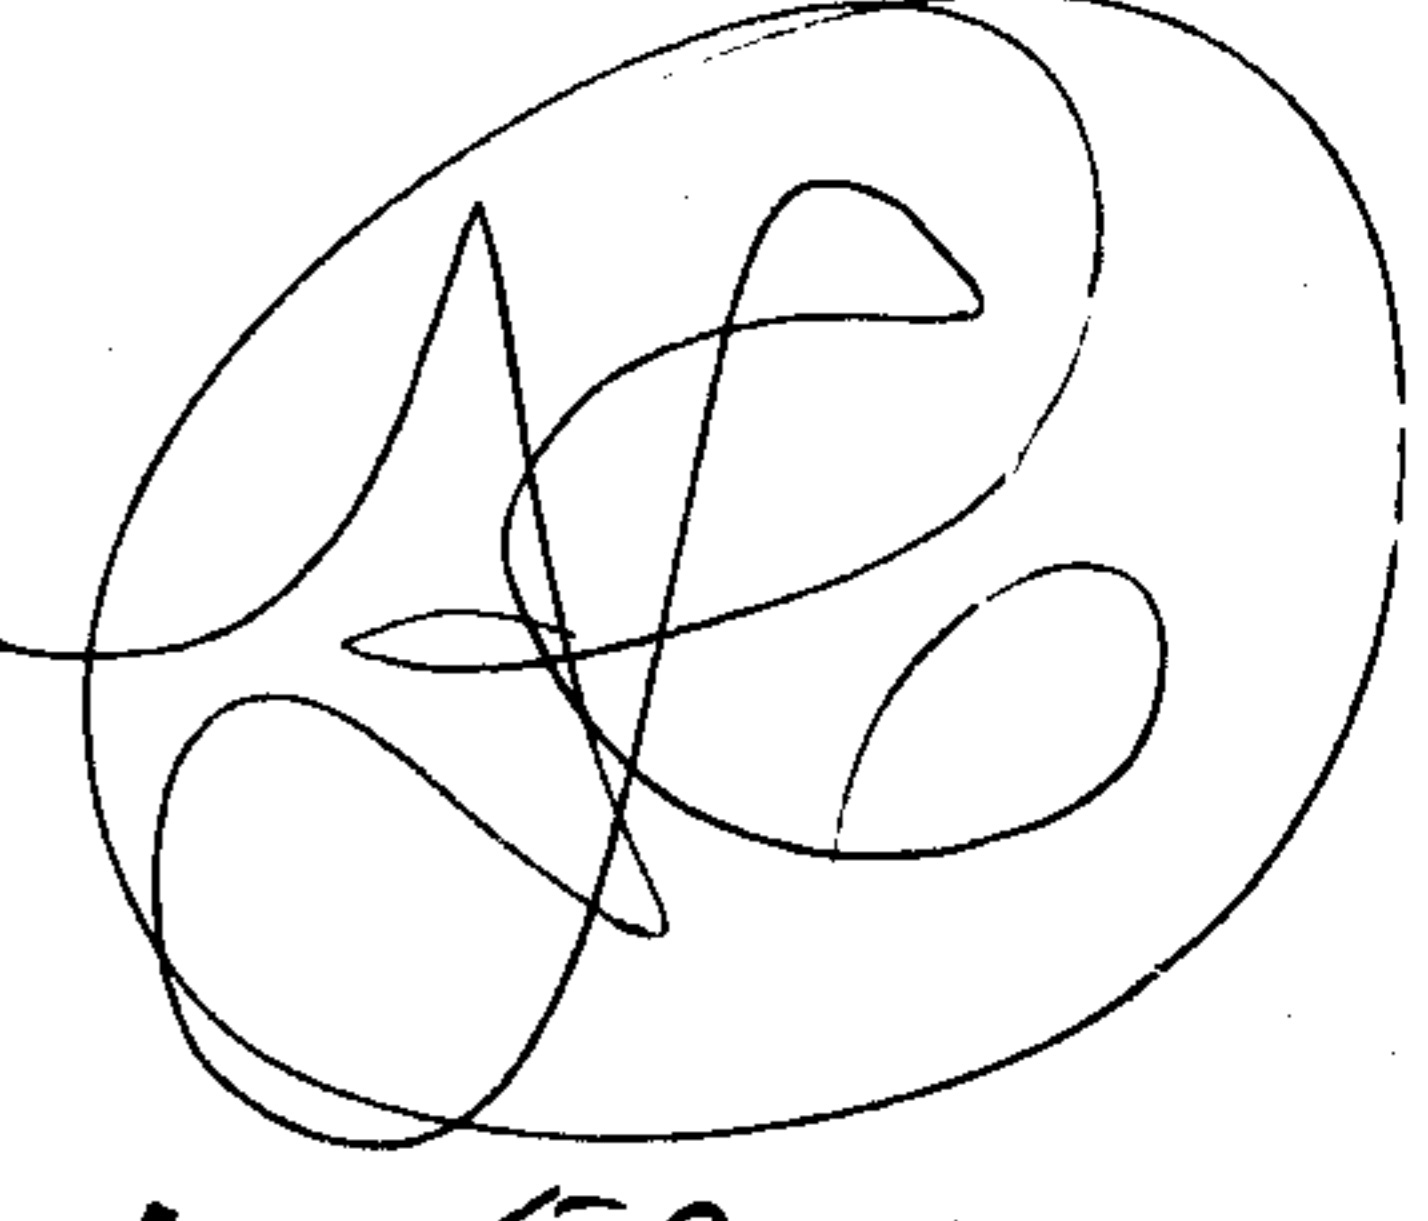

5242  
**APPROVED**  
**LORAIN CO.**  
**MAP DEPT.**  
 DATE 9-2-71  
 16-00-091B  
 BY L.W. Hall

SEP 23 ENT'D

DINA CO.