

ELD

SEE 14-D

RD

(60)

303

5248

351.54
-004
2.00 F.
350.18
245.15

RD

(60)

1691.26

More detail
line will have
to be moved
see

2600

81

~~-003~~
-001
133.00 F.
101.02
-002


1695.67

-003
31.78 A.

2599.86

5248

7-7 78-80-6

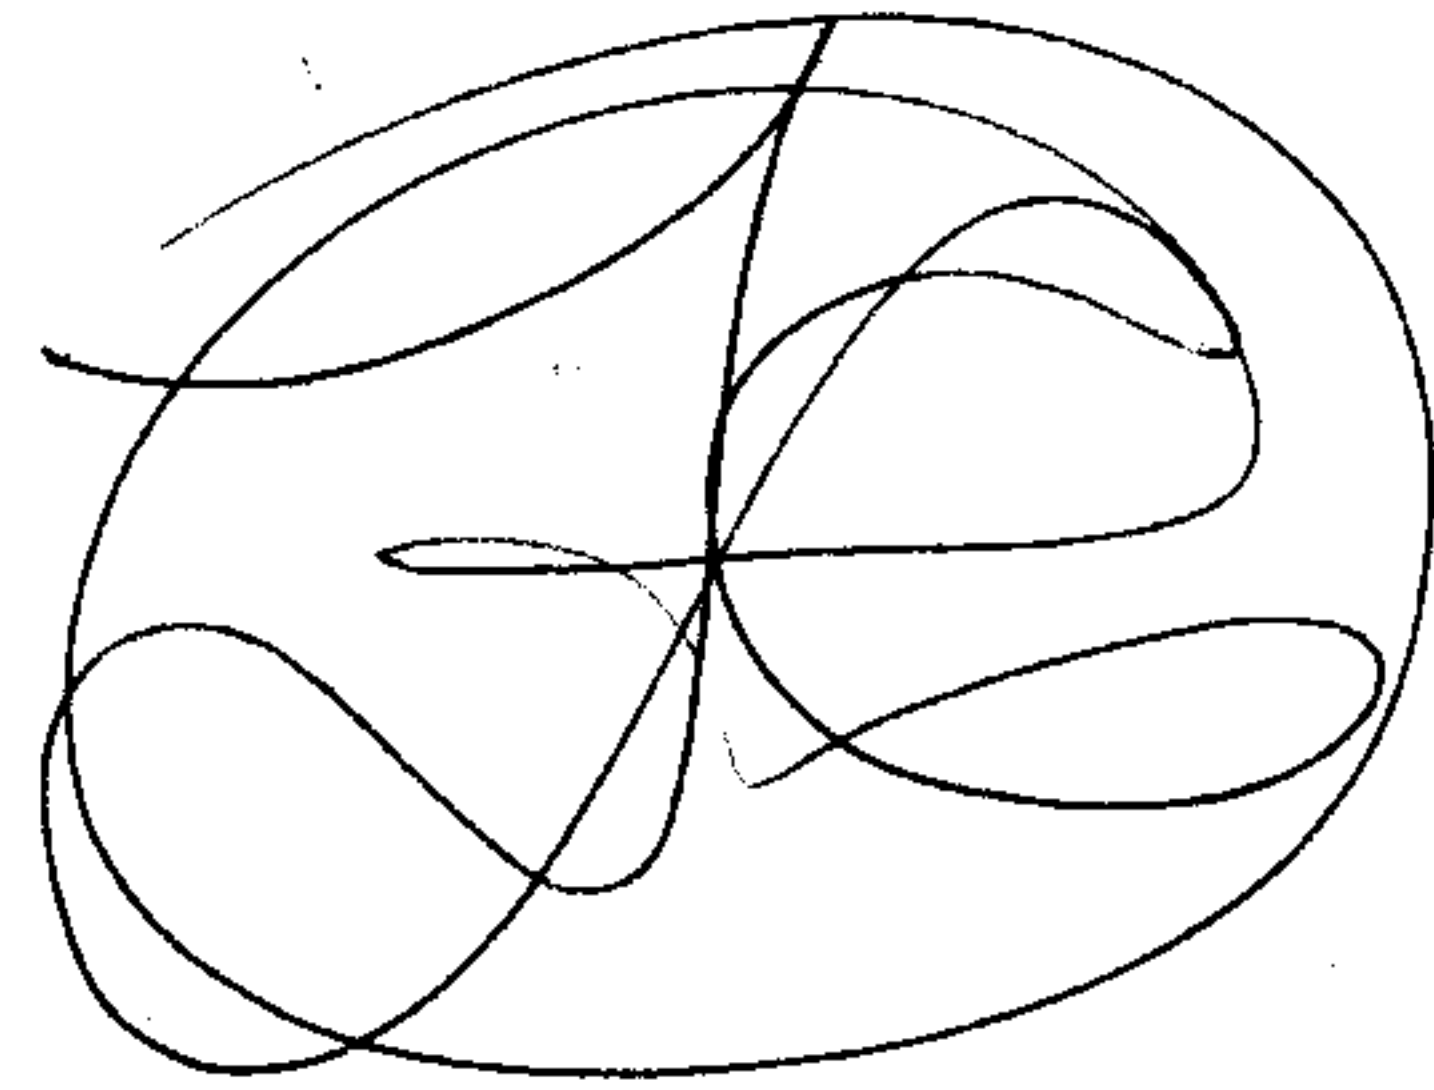

-001
113.00 F.

100 SEP 23 ENT'D

APPROVED
LORAIN CO.
MAP DEPT.
DATE 9/17/71
14-H
BY R. J. Kelley

132

330

-003

002

