
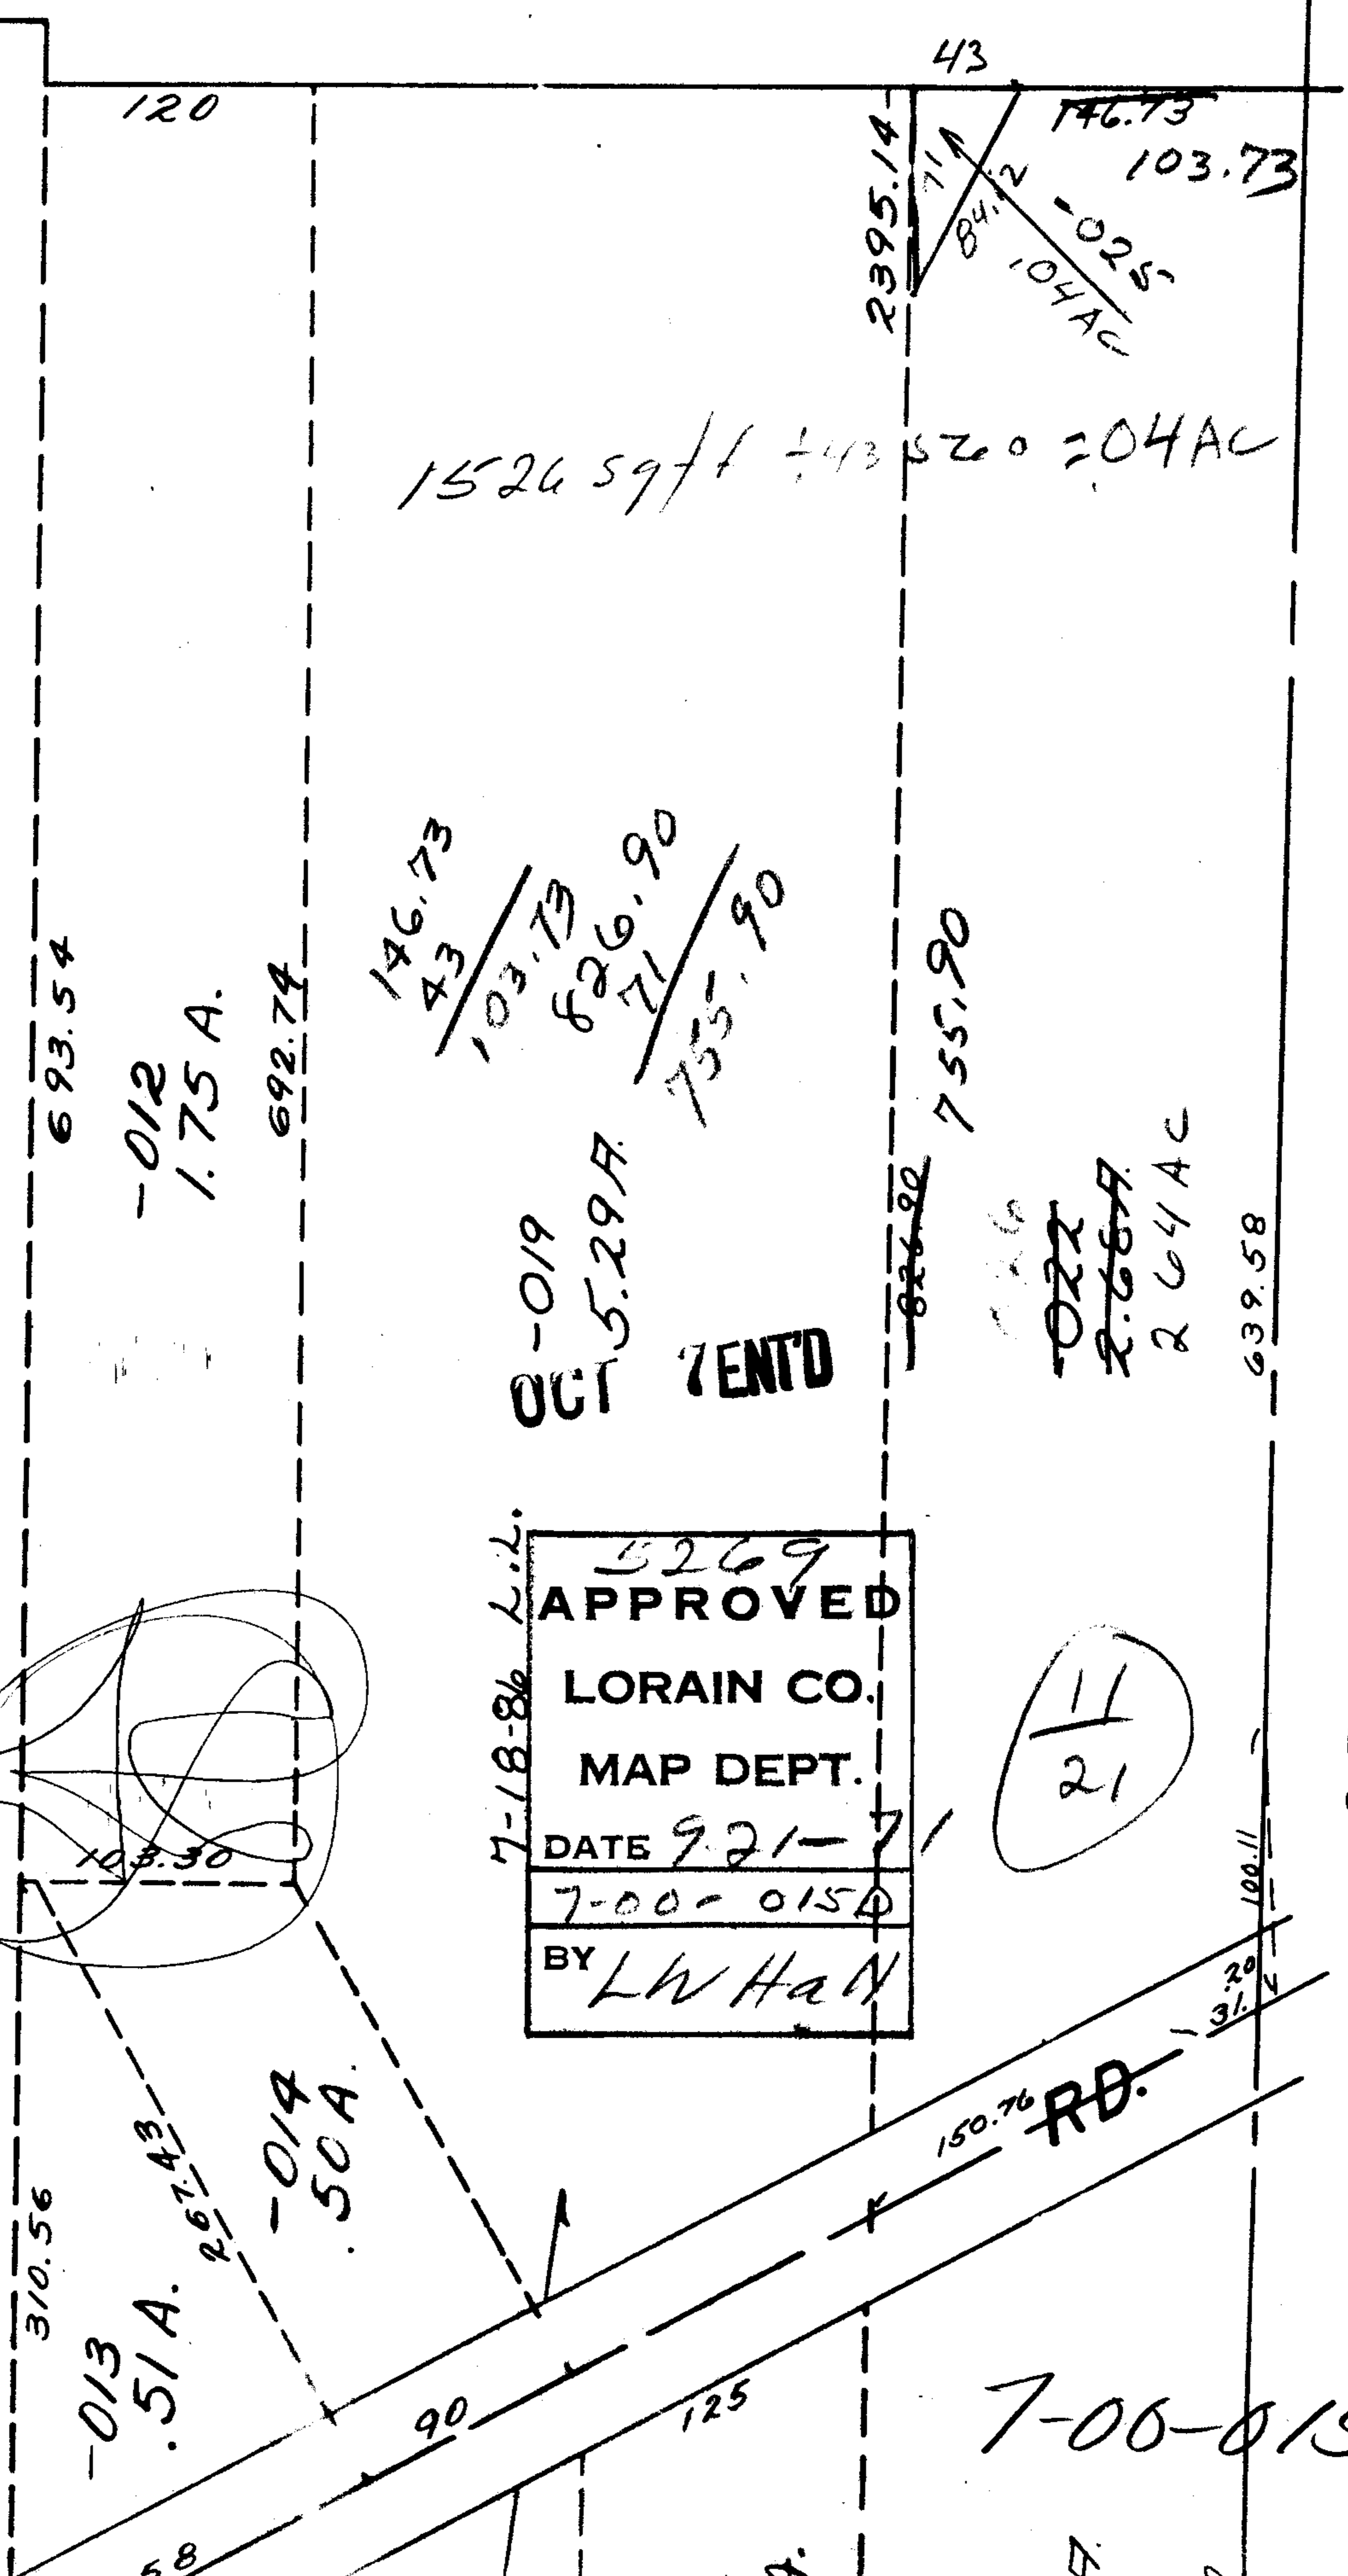


5269

-017
5.27A

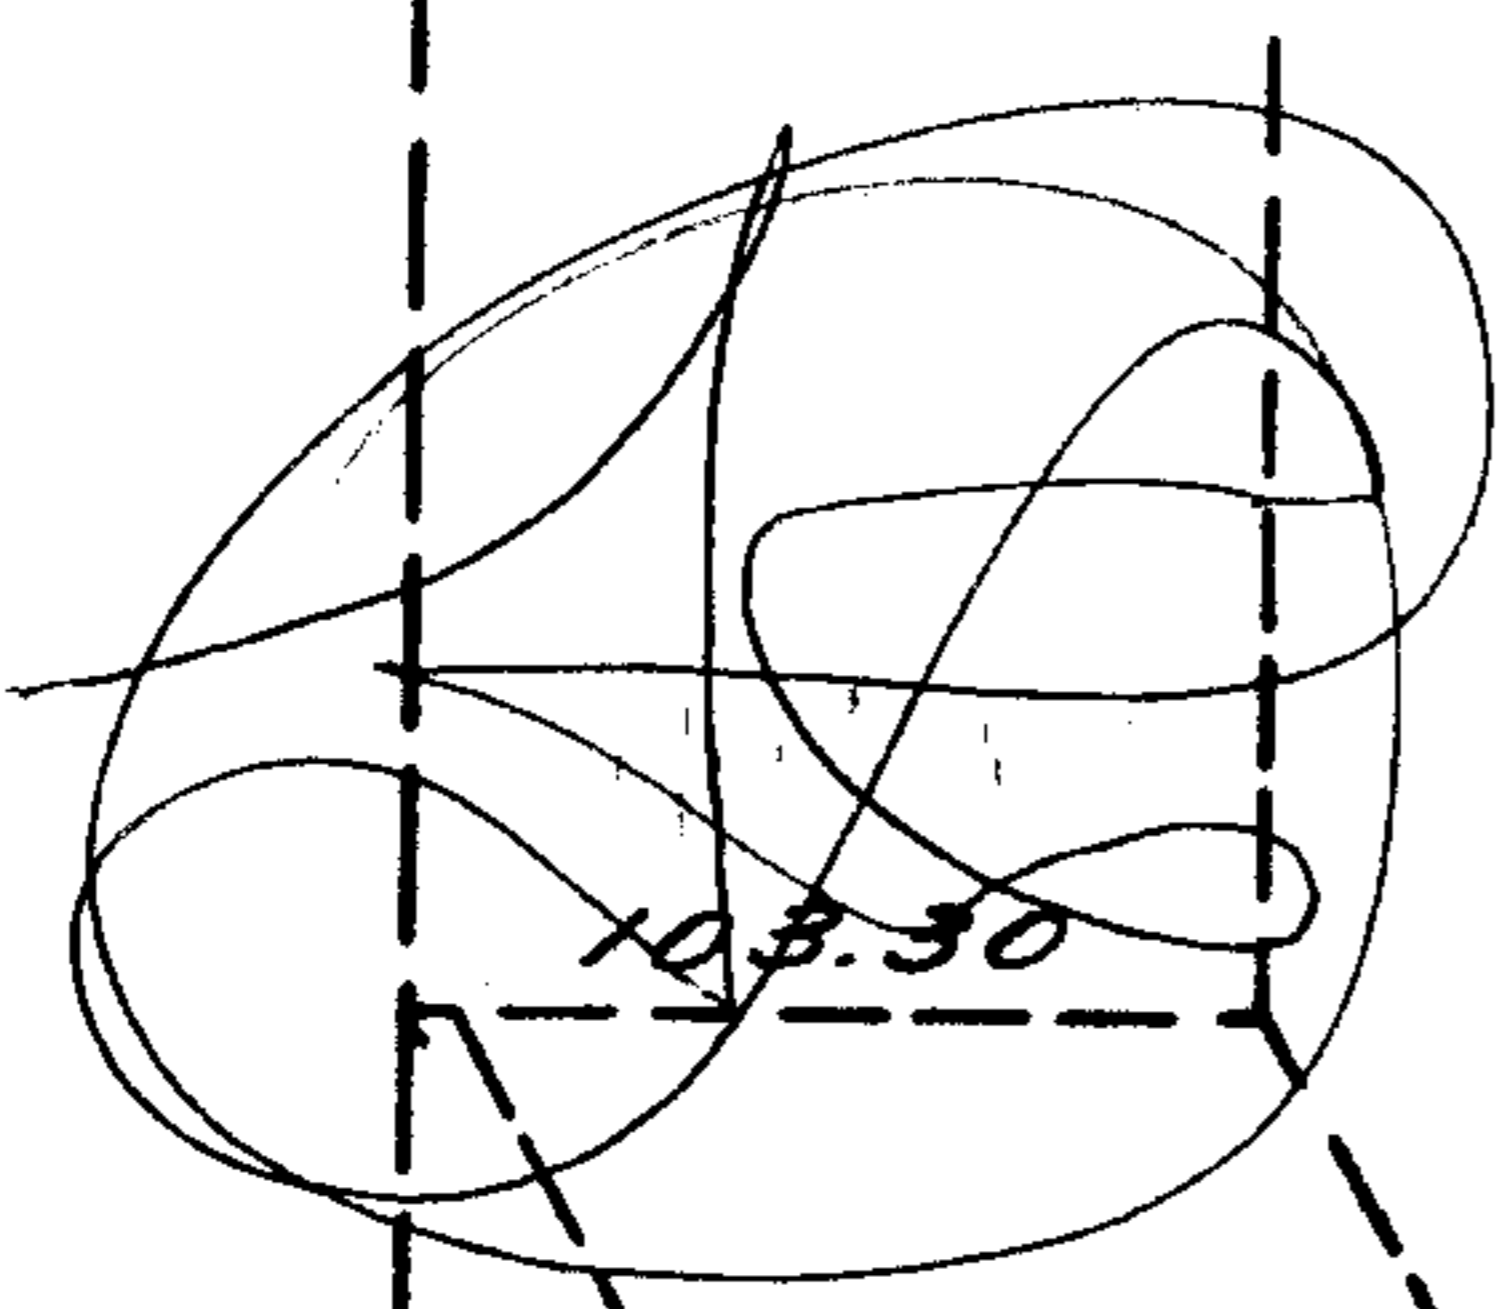

146.73
43
103.73
826.90
71
755.90

-019
OCT 5.29A
7ENTD

~~022~~
~~2.66A~~
2.64AC

7-18-86 L.L.L.
5269
APPROVED
LORAIN CO.
MAP DEPT.
DATE 9-21-71
7-00-0150
BY LW Han

21

SEE 7-00-010-C

7-00-0150