

5274
~~scribble~~
~~scribble~~

APPROVED
LORAIN CO.
MAP DEPT.
DATE 9-22-71
7-00-022-A
BY *[Signature]*

OCT 21 1971
001
21.22 A.

[Circled signature]
[Circled signature]

7-18-86 L.L.

264 x 75.77

421.08
422.43

~~005~~ -052
~~470 A.~~ 4.46 A.

246.43
~~247.5~~

585.50


101

-051
5.84 A.

470
446
24

AL 29

SEE 7-00-027-B

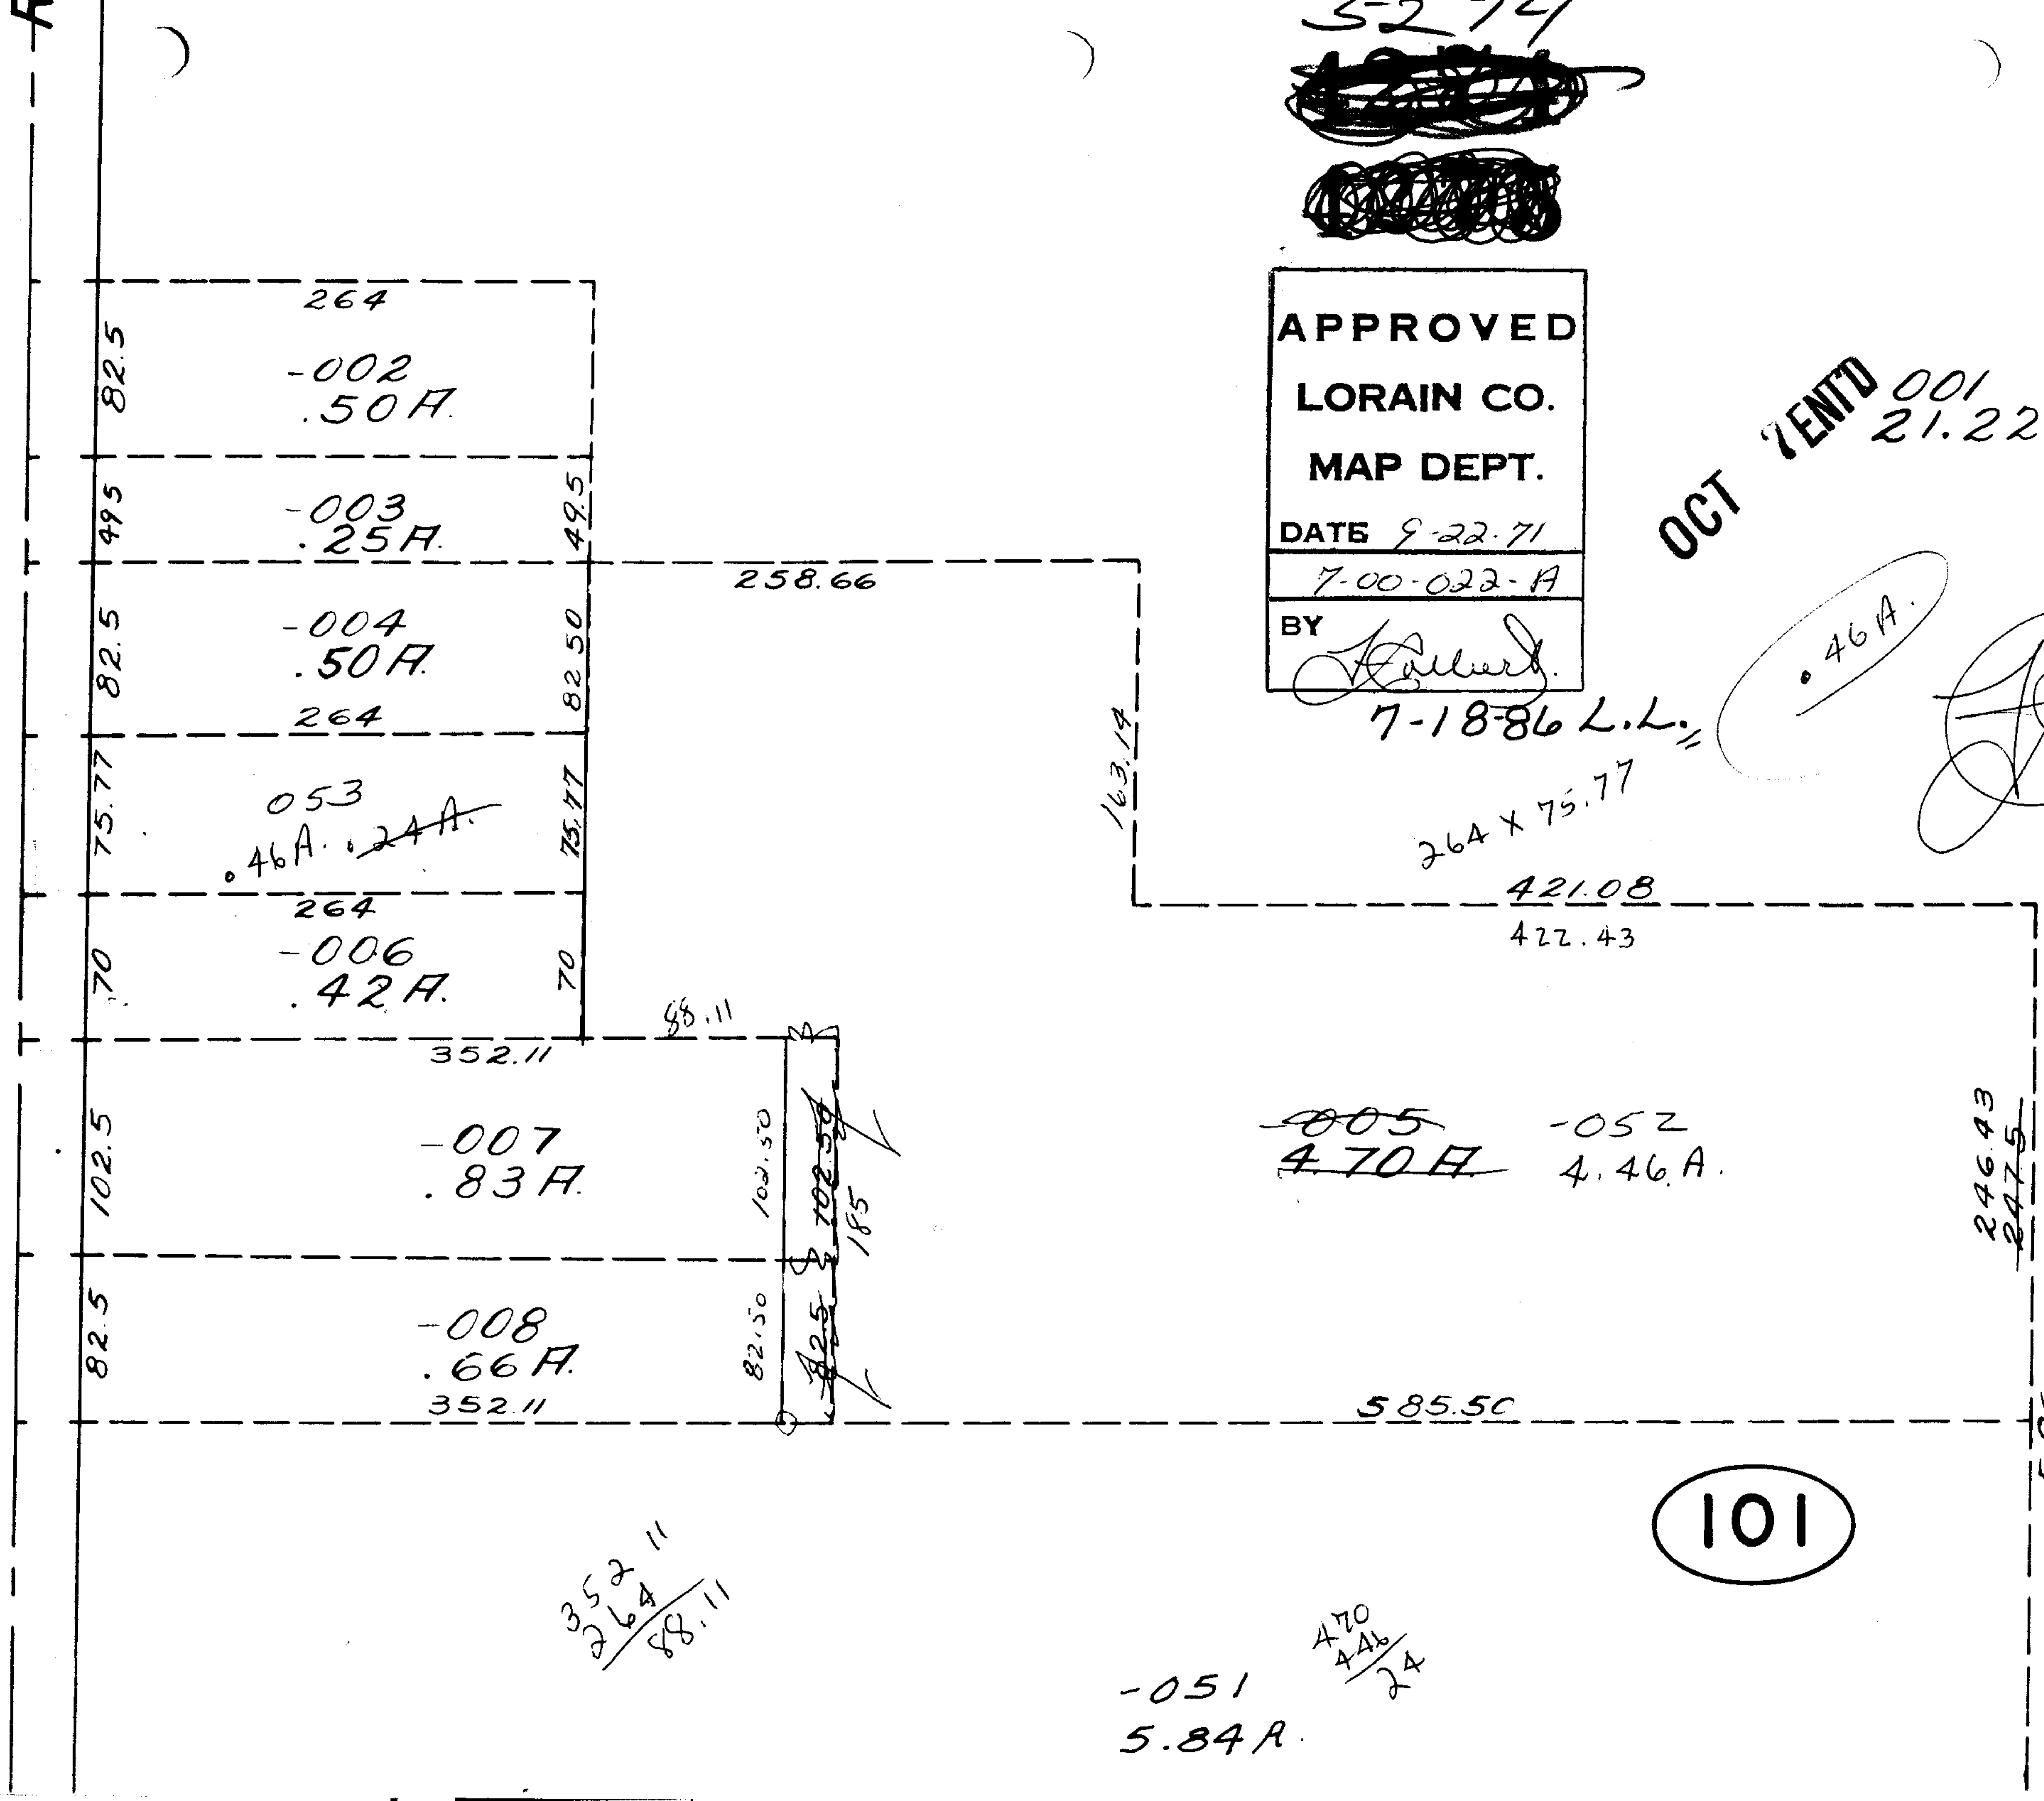

352.11
264
88.11