


771

5275

~~-011~~
16.00A.

-031
15.00A.

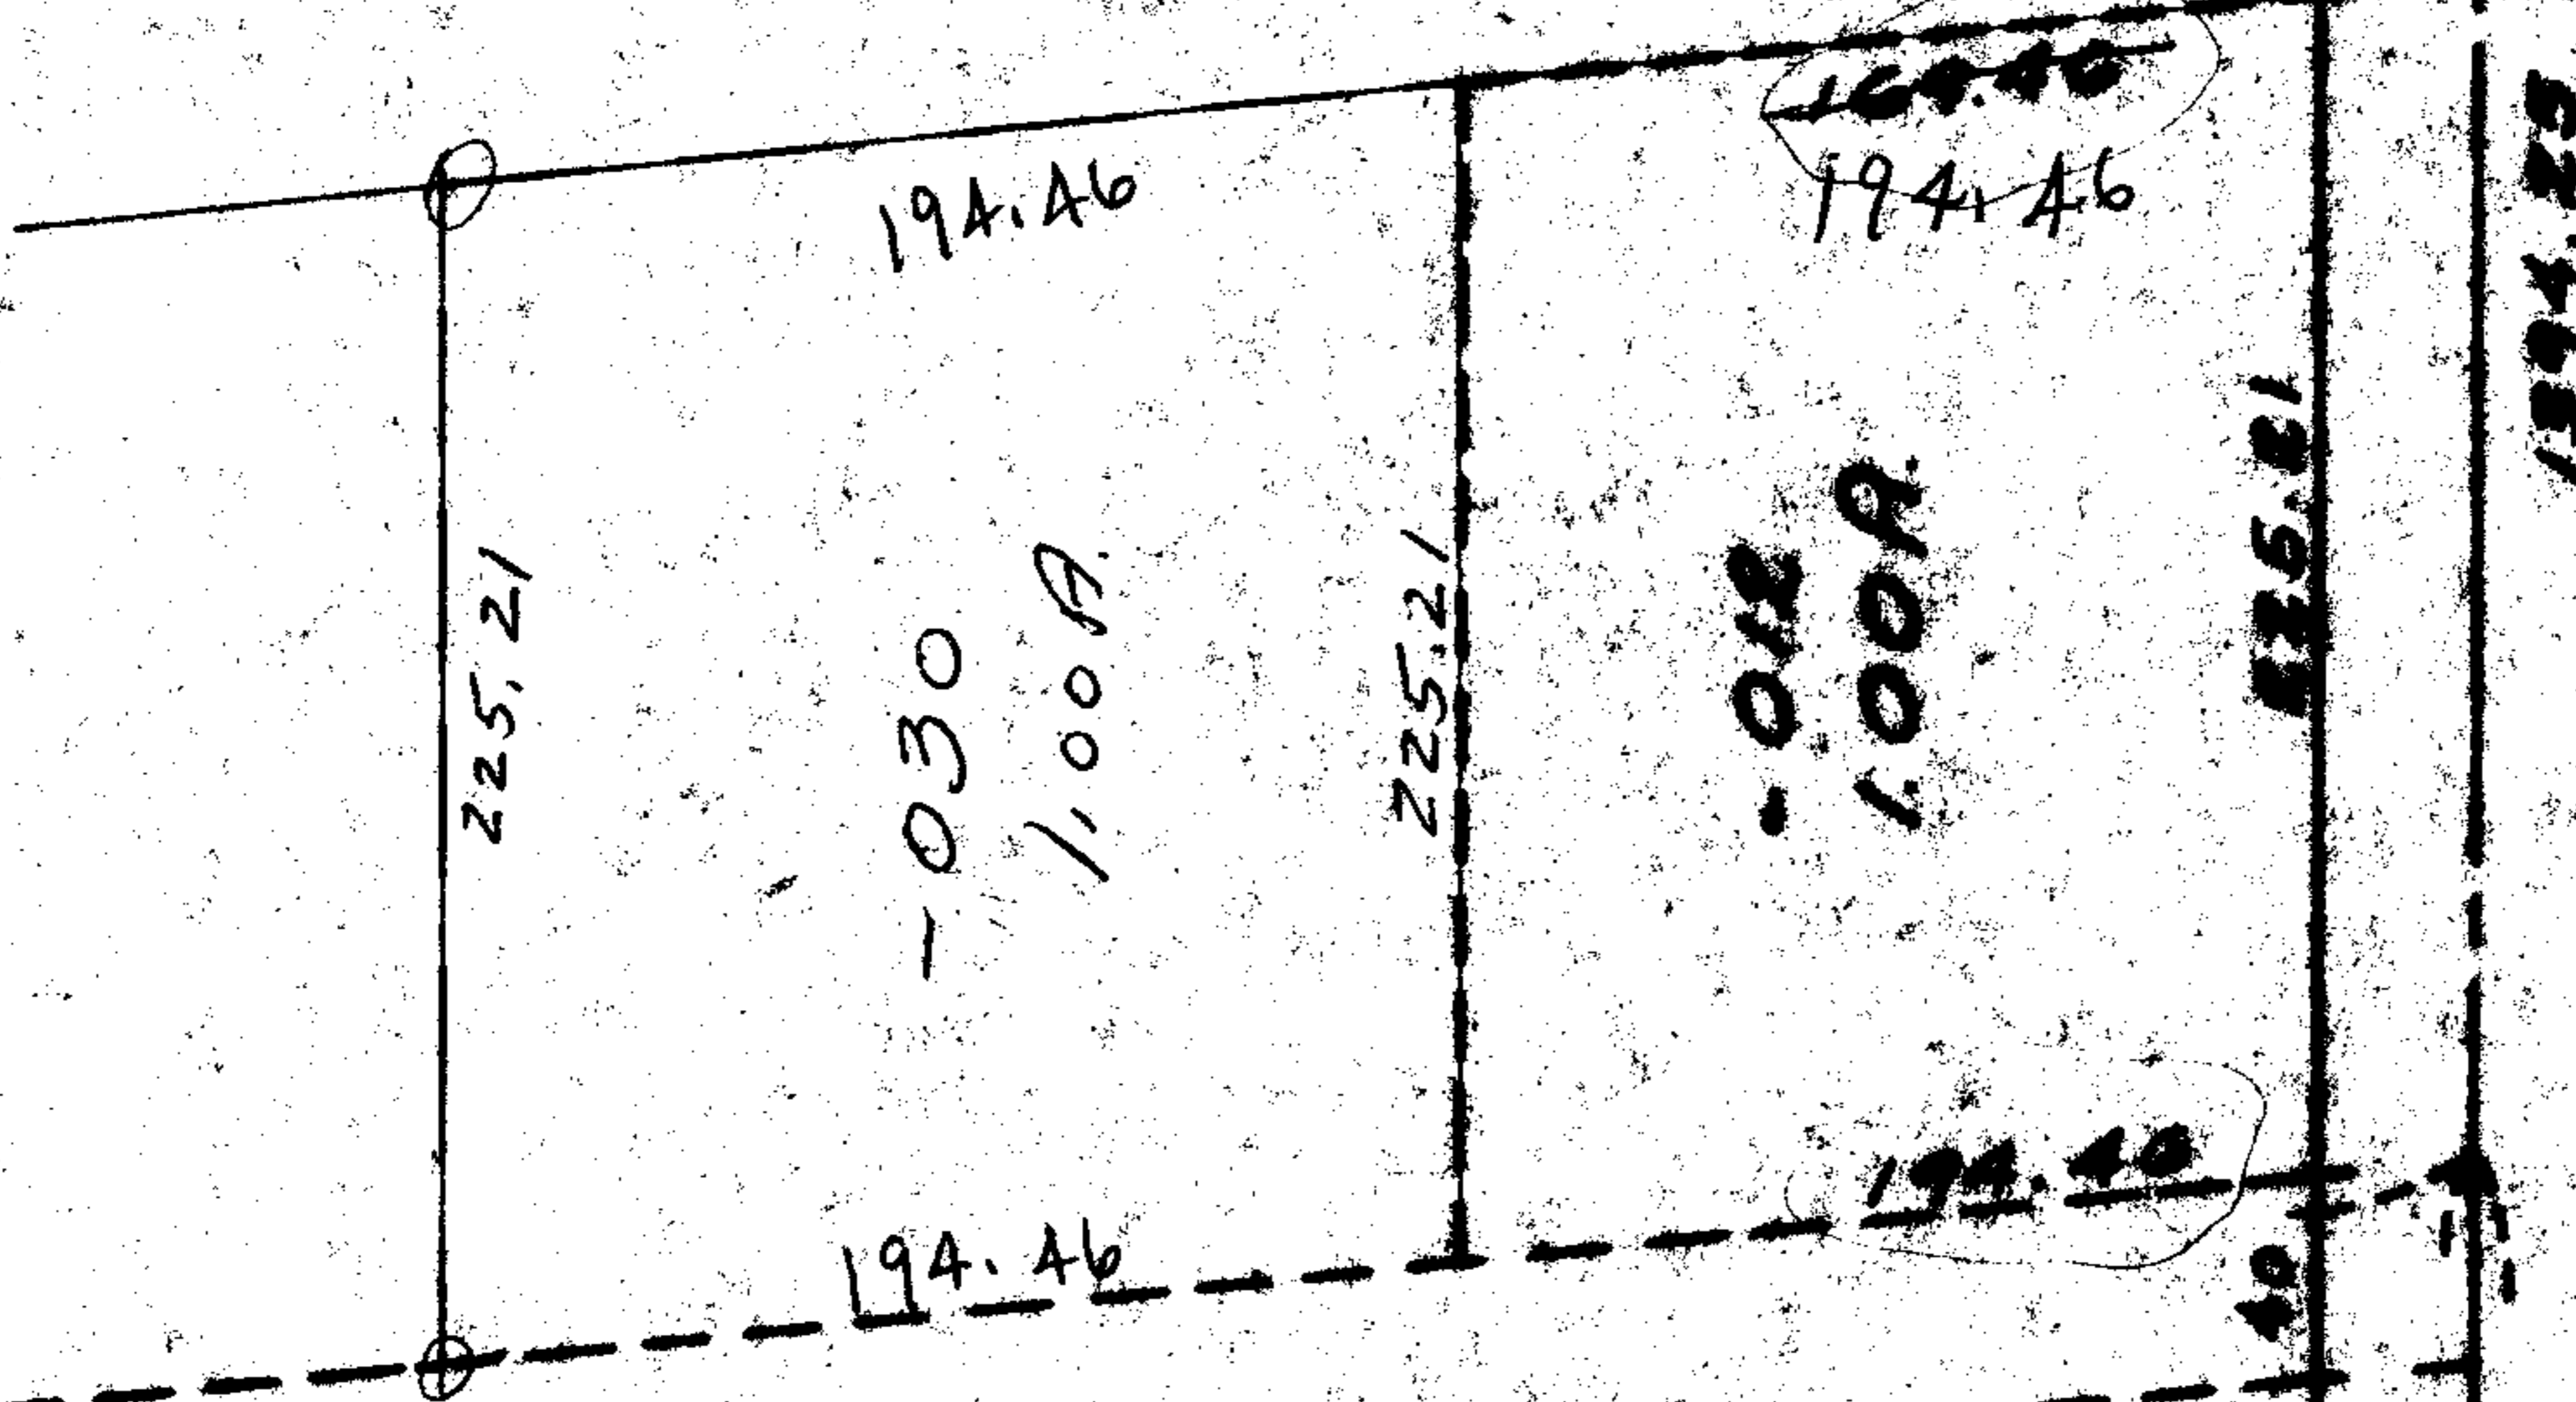

OCT 7 1971

5275

APPROVED
 LORAIN CO.
 MAP DEPT.
 DATE 9-22-71
 12-00-062-B
 BY *L. Dubard*

