

-005
1.00A
504.22 Cal.
502.20
505.20

933.80
2.42 AC -033
854.08
-032 758.53 2.08A

1792.56

1848.55

3189.20 ~~4123.0~~

034
-03+
47.92A
45.50 AC

3768.17

56°14'

64.90
70.10

4123
933.80
3189.20 19

-008
153.97A.

-0
63

10-00-019-000-031
Maxine split
Bachhiks
9-27-71

5284

APPROVED
LORAIN CO.
MAP DEPT.
DATE 9-27-71
BY LWH/11

NOV 23 1971



2079.0

2573

-017

2200

2641.32
2630.10

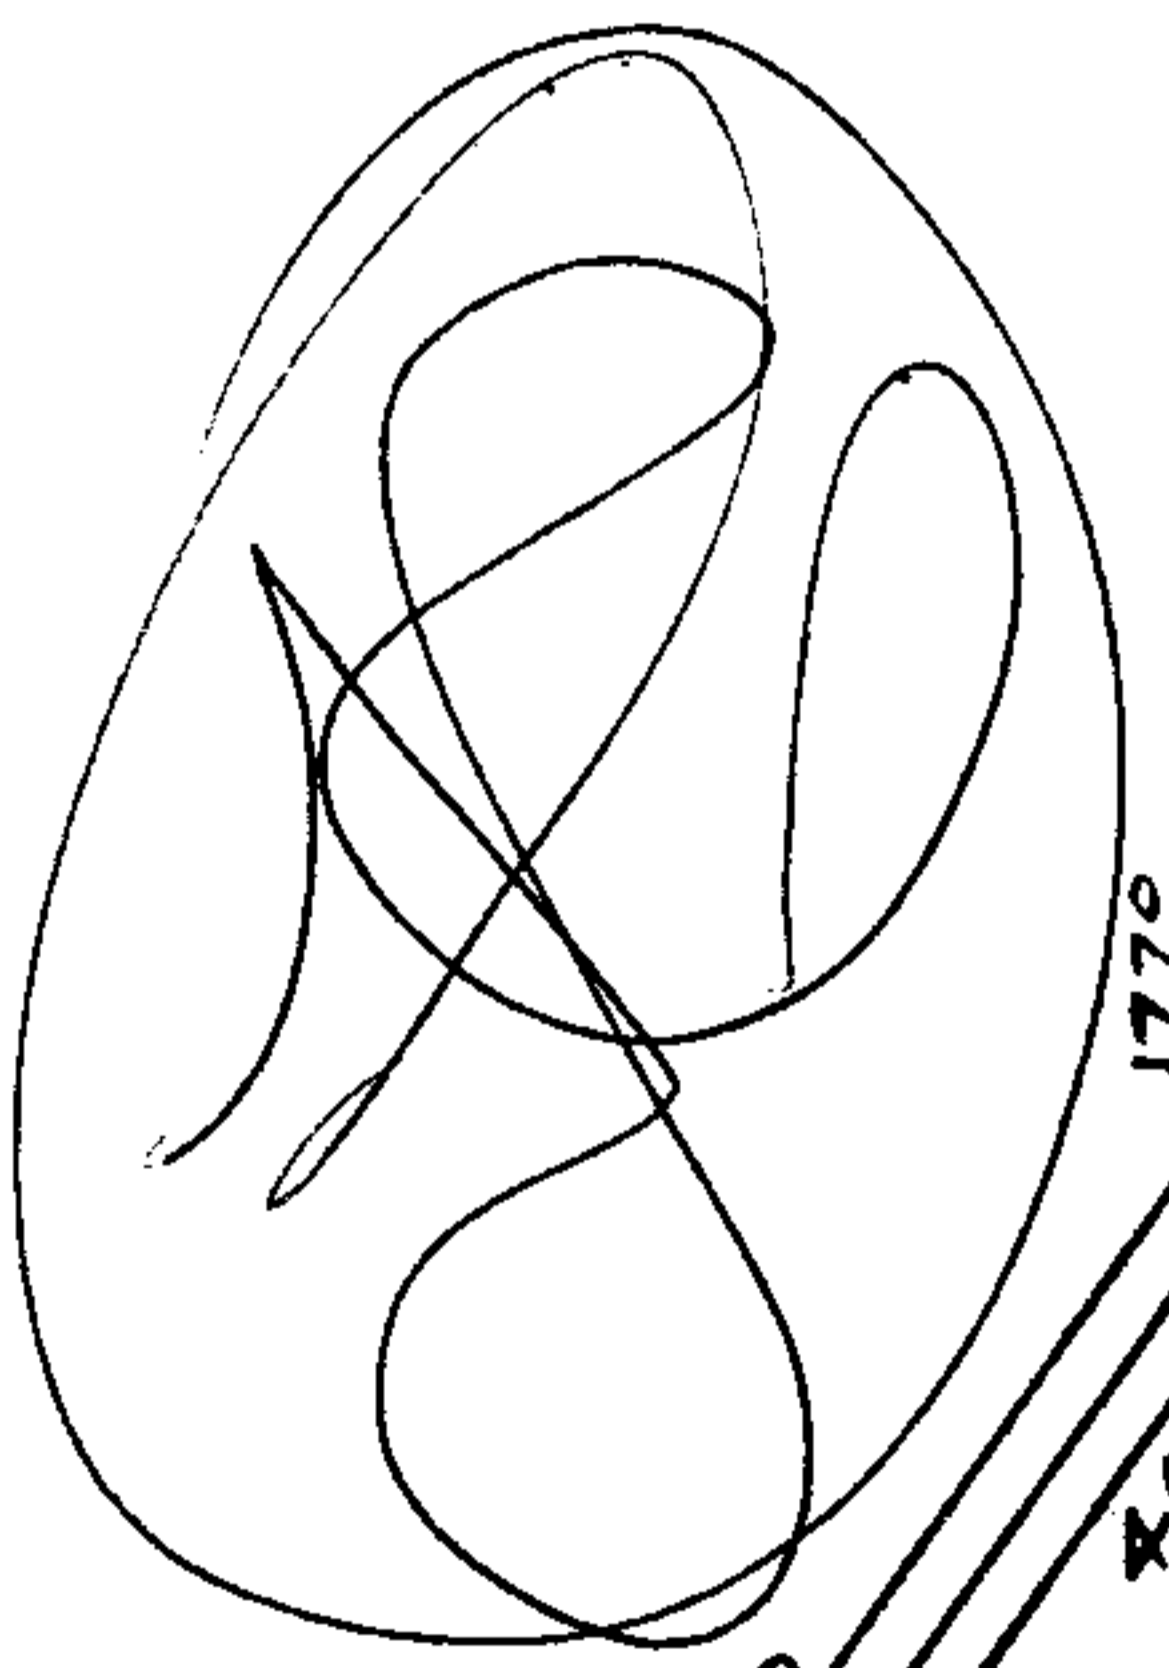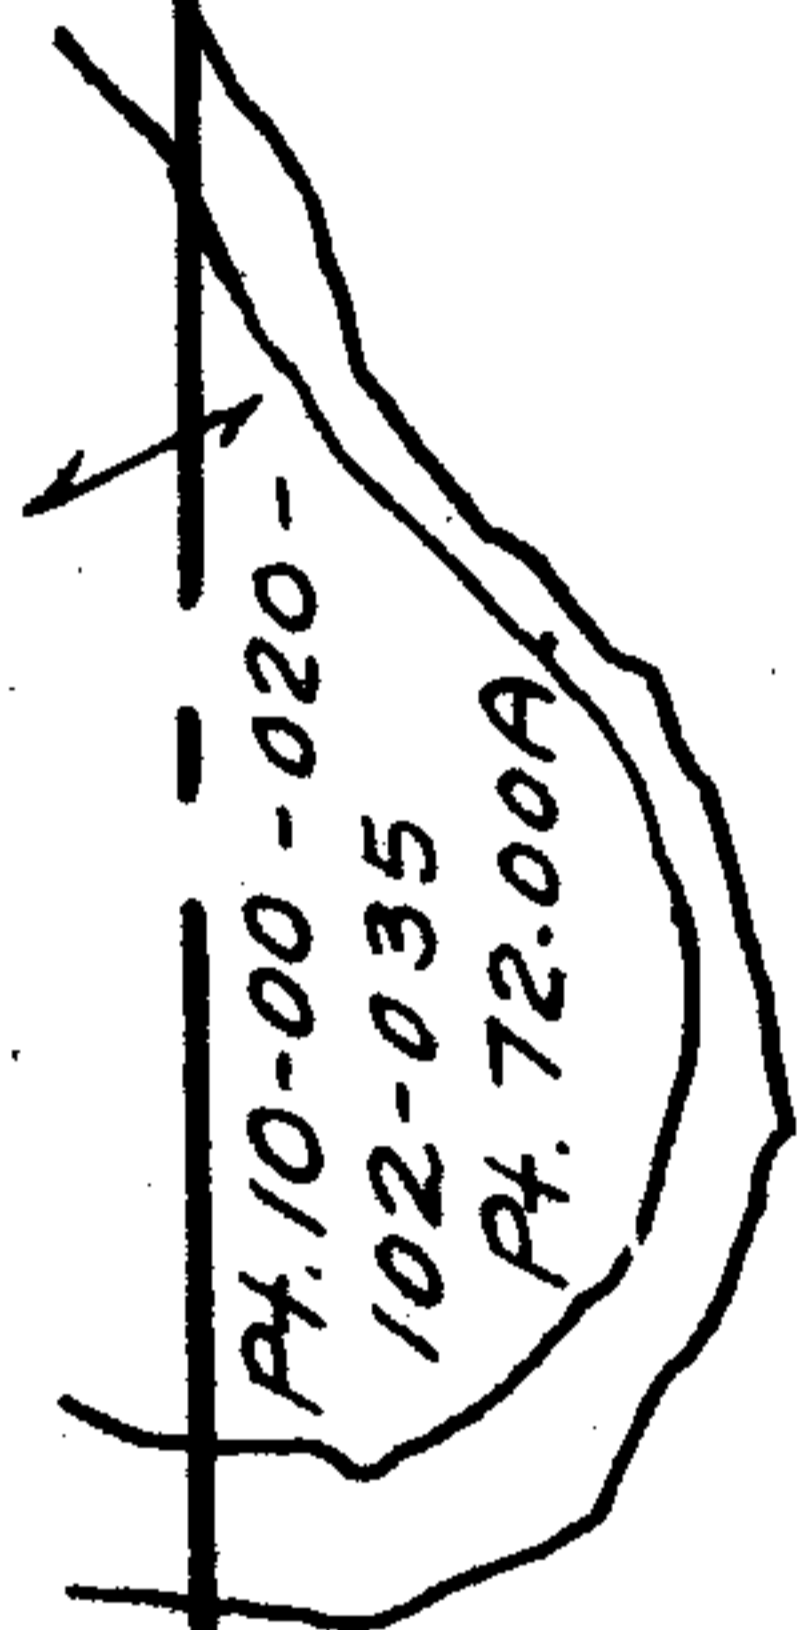

RD.

600
3.00A

1562.38

177°55'

19x

236

160

284.40

175°45'

130°00'

407.22

552.23

91°28'

Pt. 10-00-020-
102-035
Pt. 72.00A