
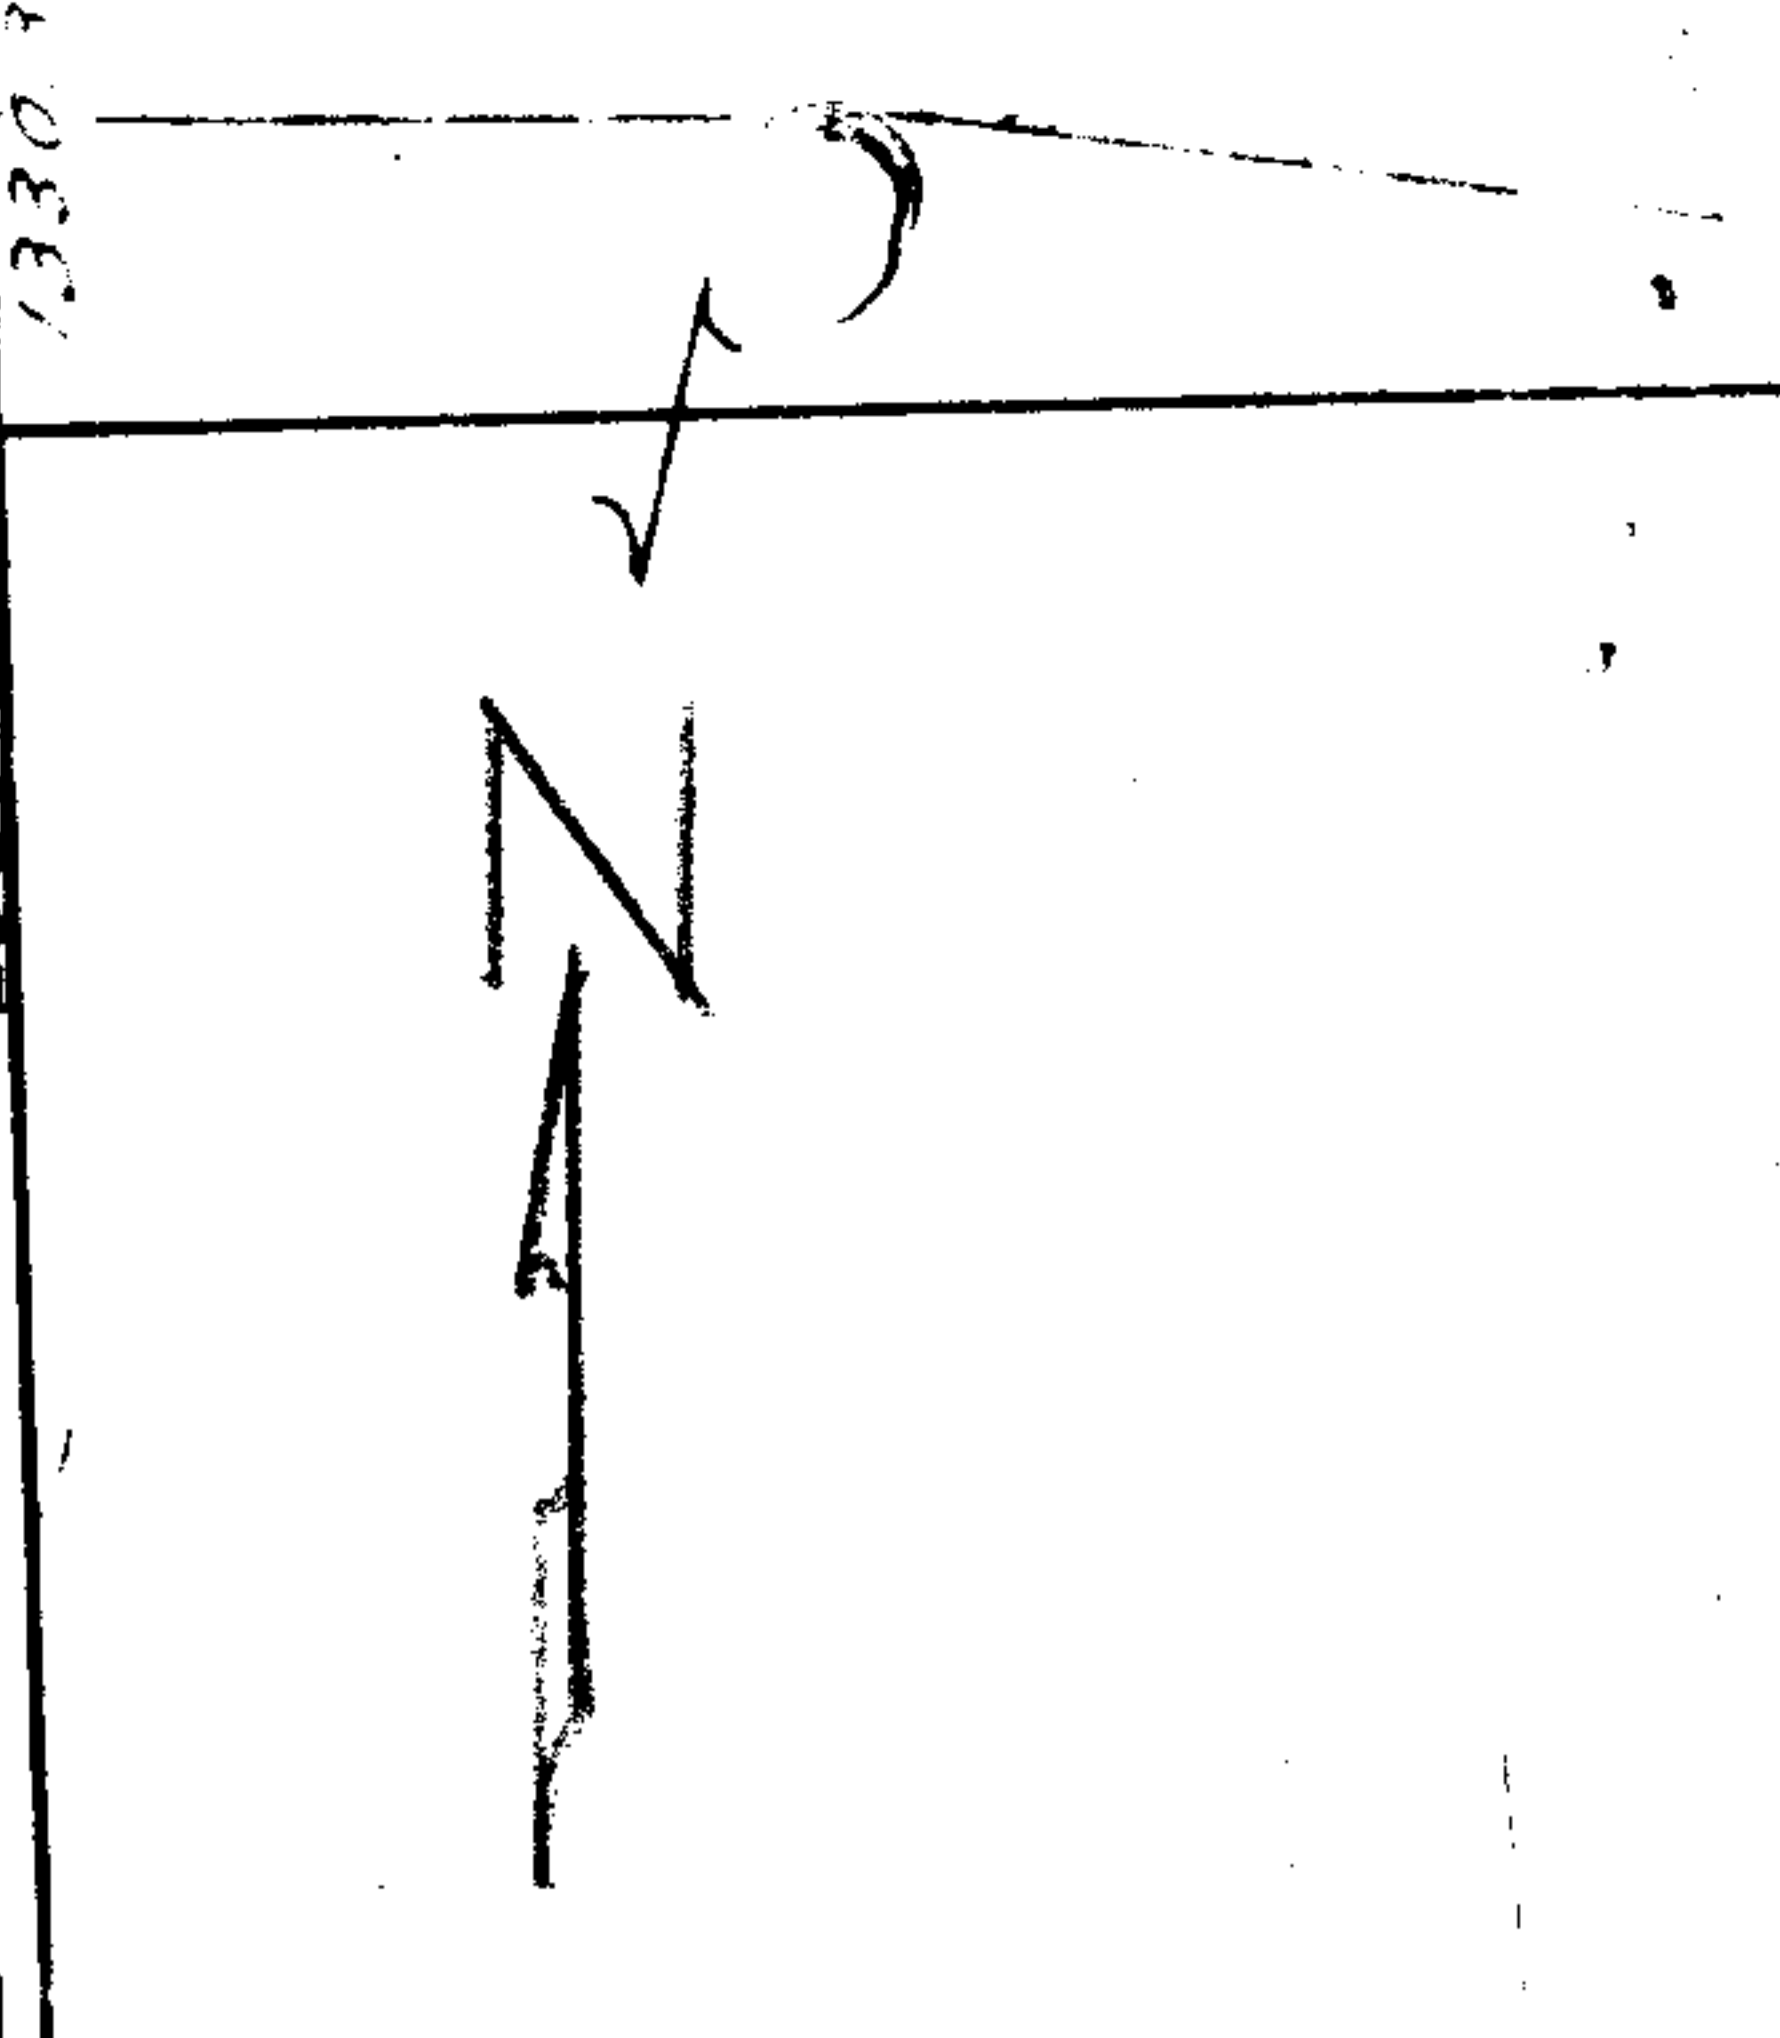


5287

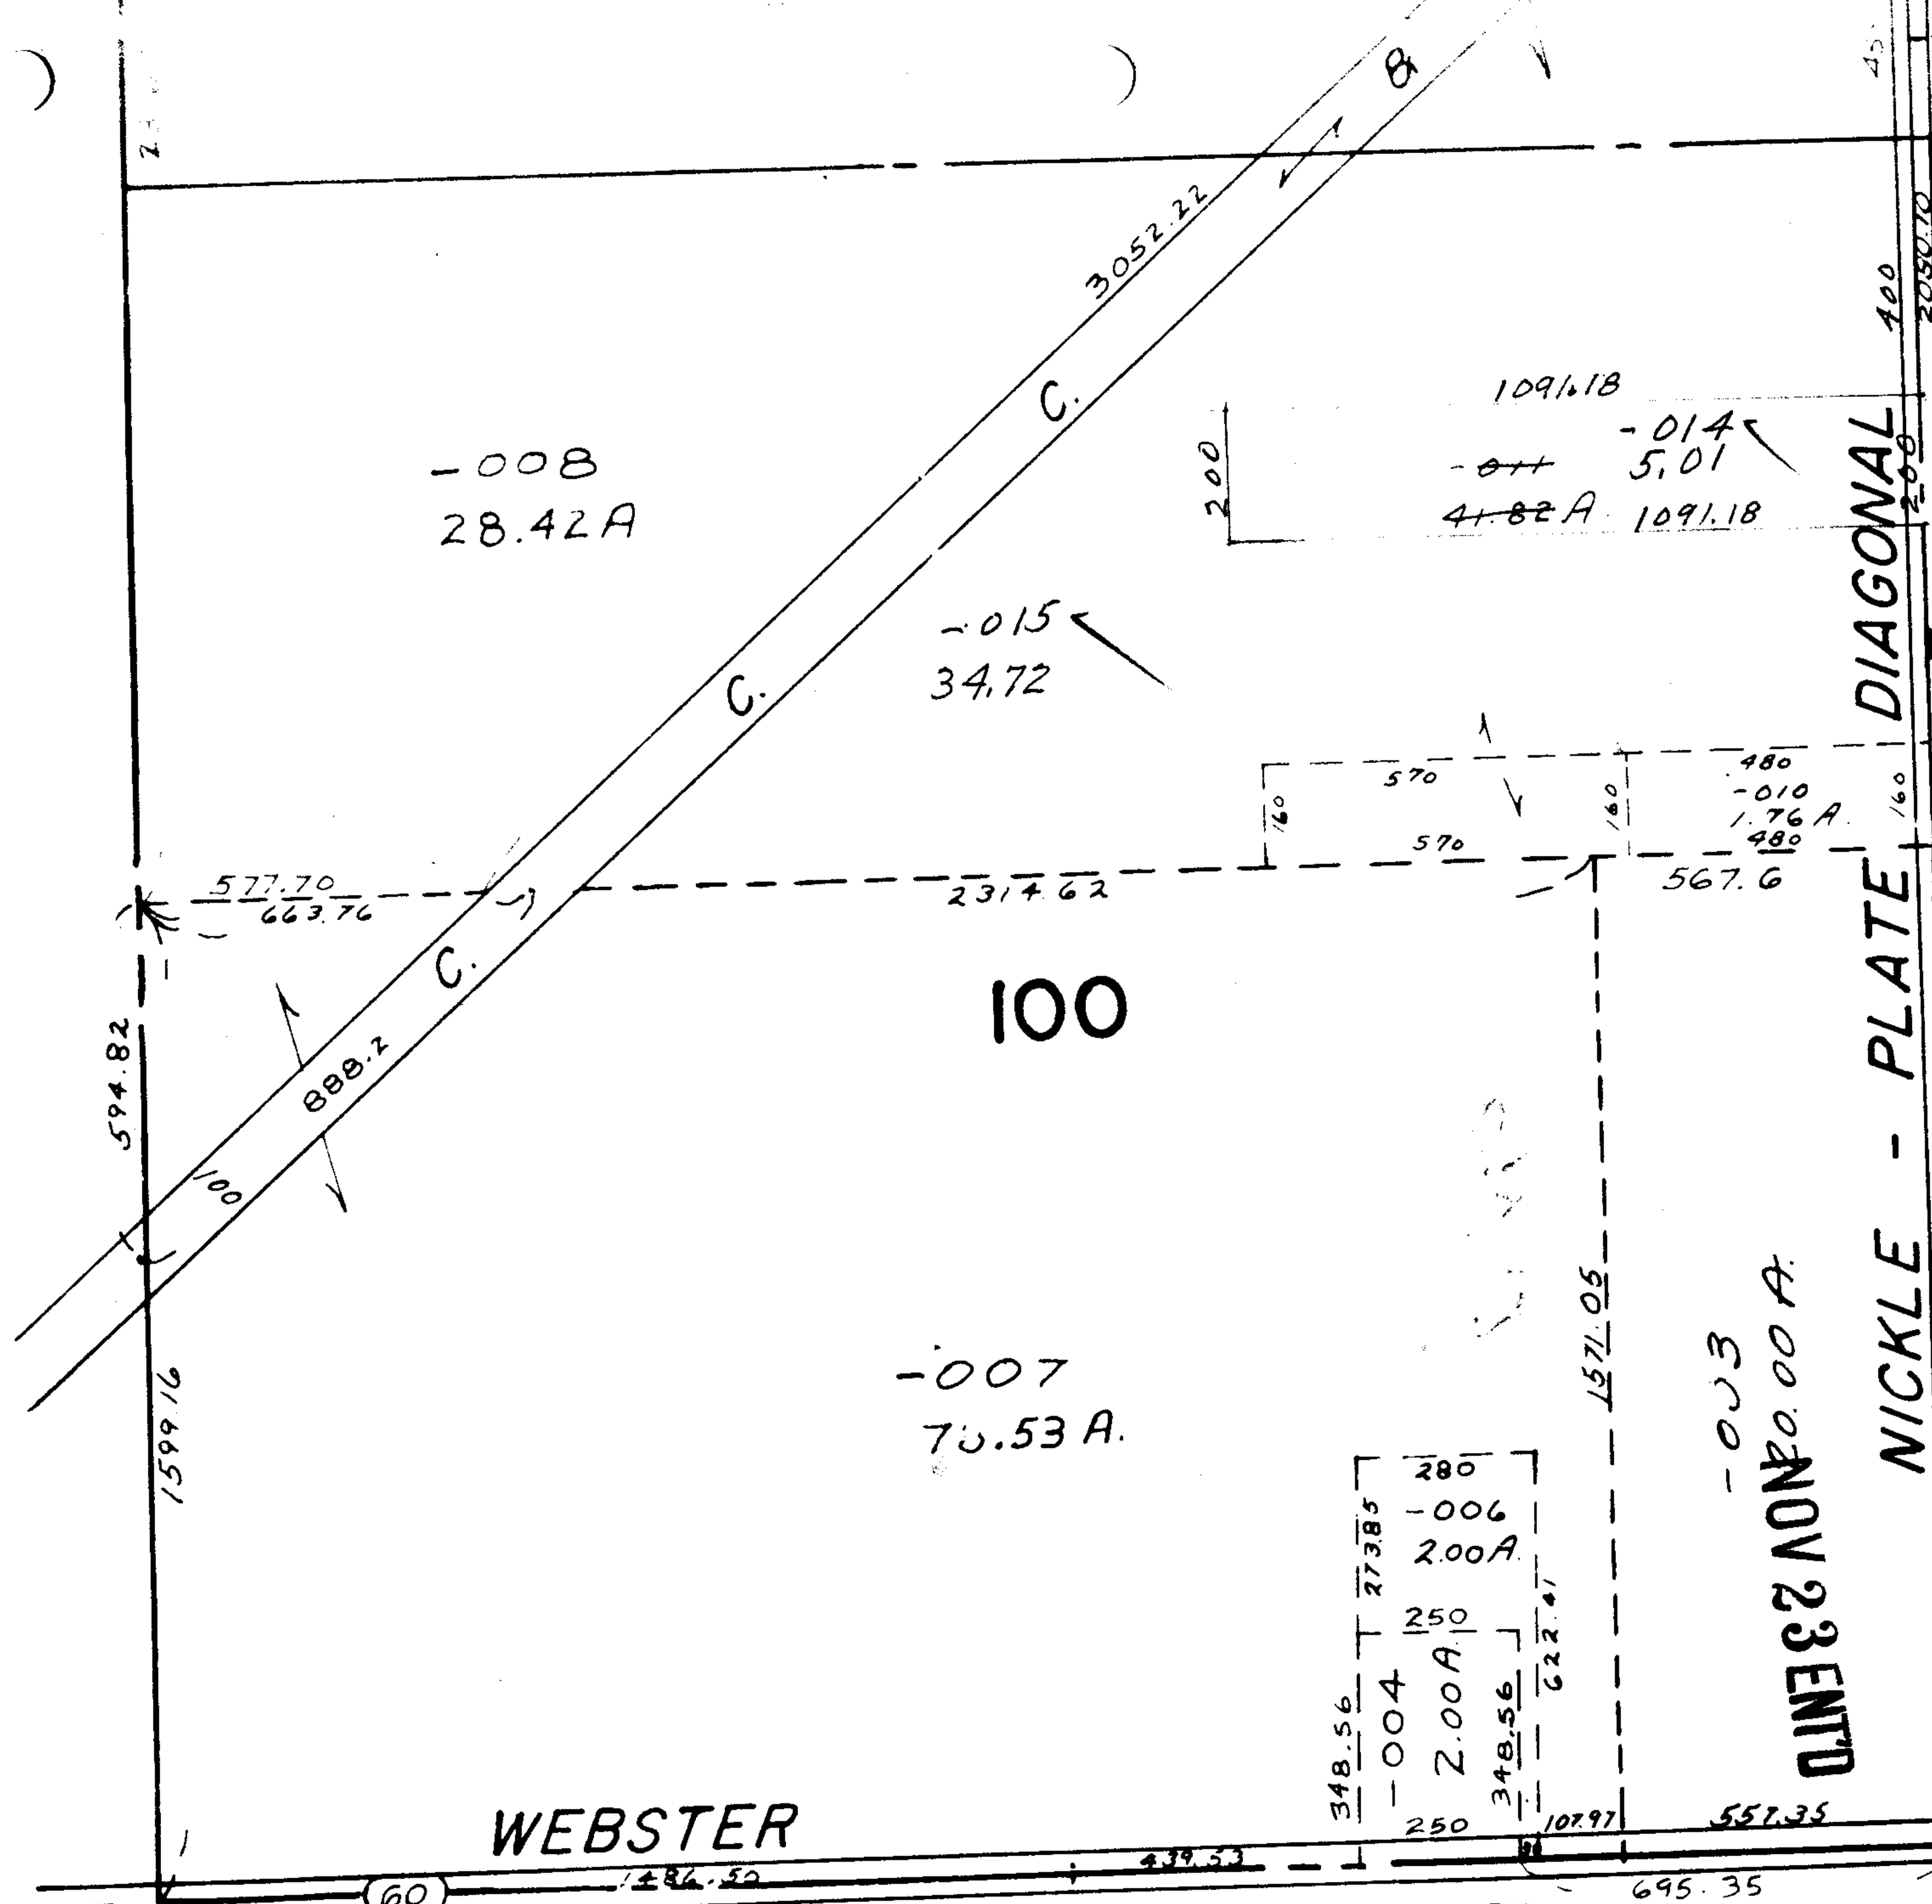

SEE  
**5287**  
 15-00-099-A

APPROVED  
 LORAIN CO.  
 MAP DEPT.  
 DATE 9/28/71  
 BY  
*R. J. Kelling*

Copyright 1962

15-E

# LAGRANGE TWP.

SCALE: 1" = 400'