


5291

SEE 12-00-081-B

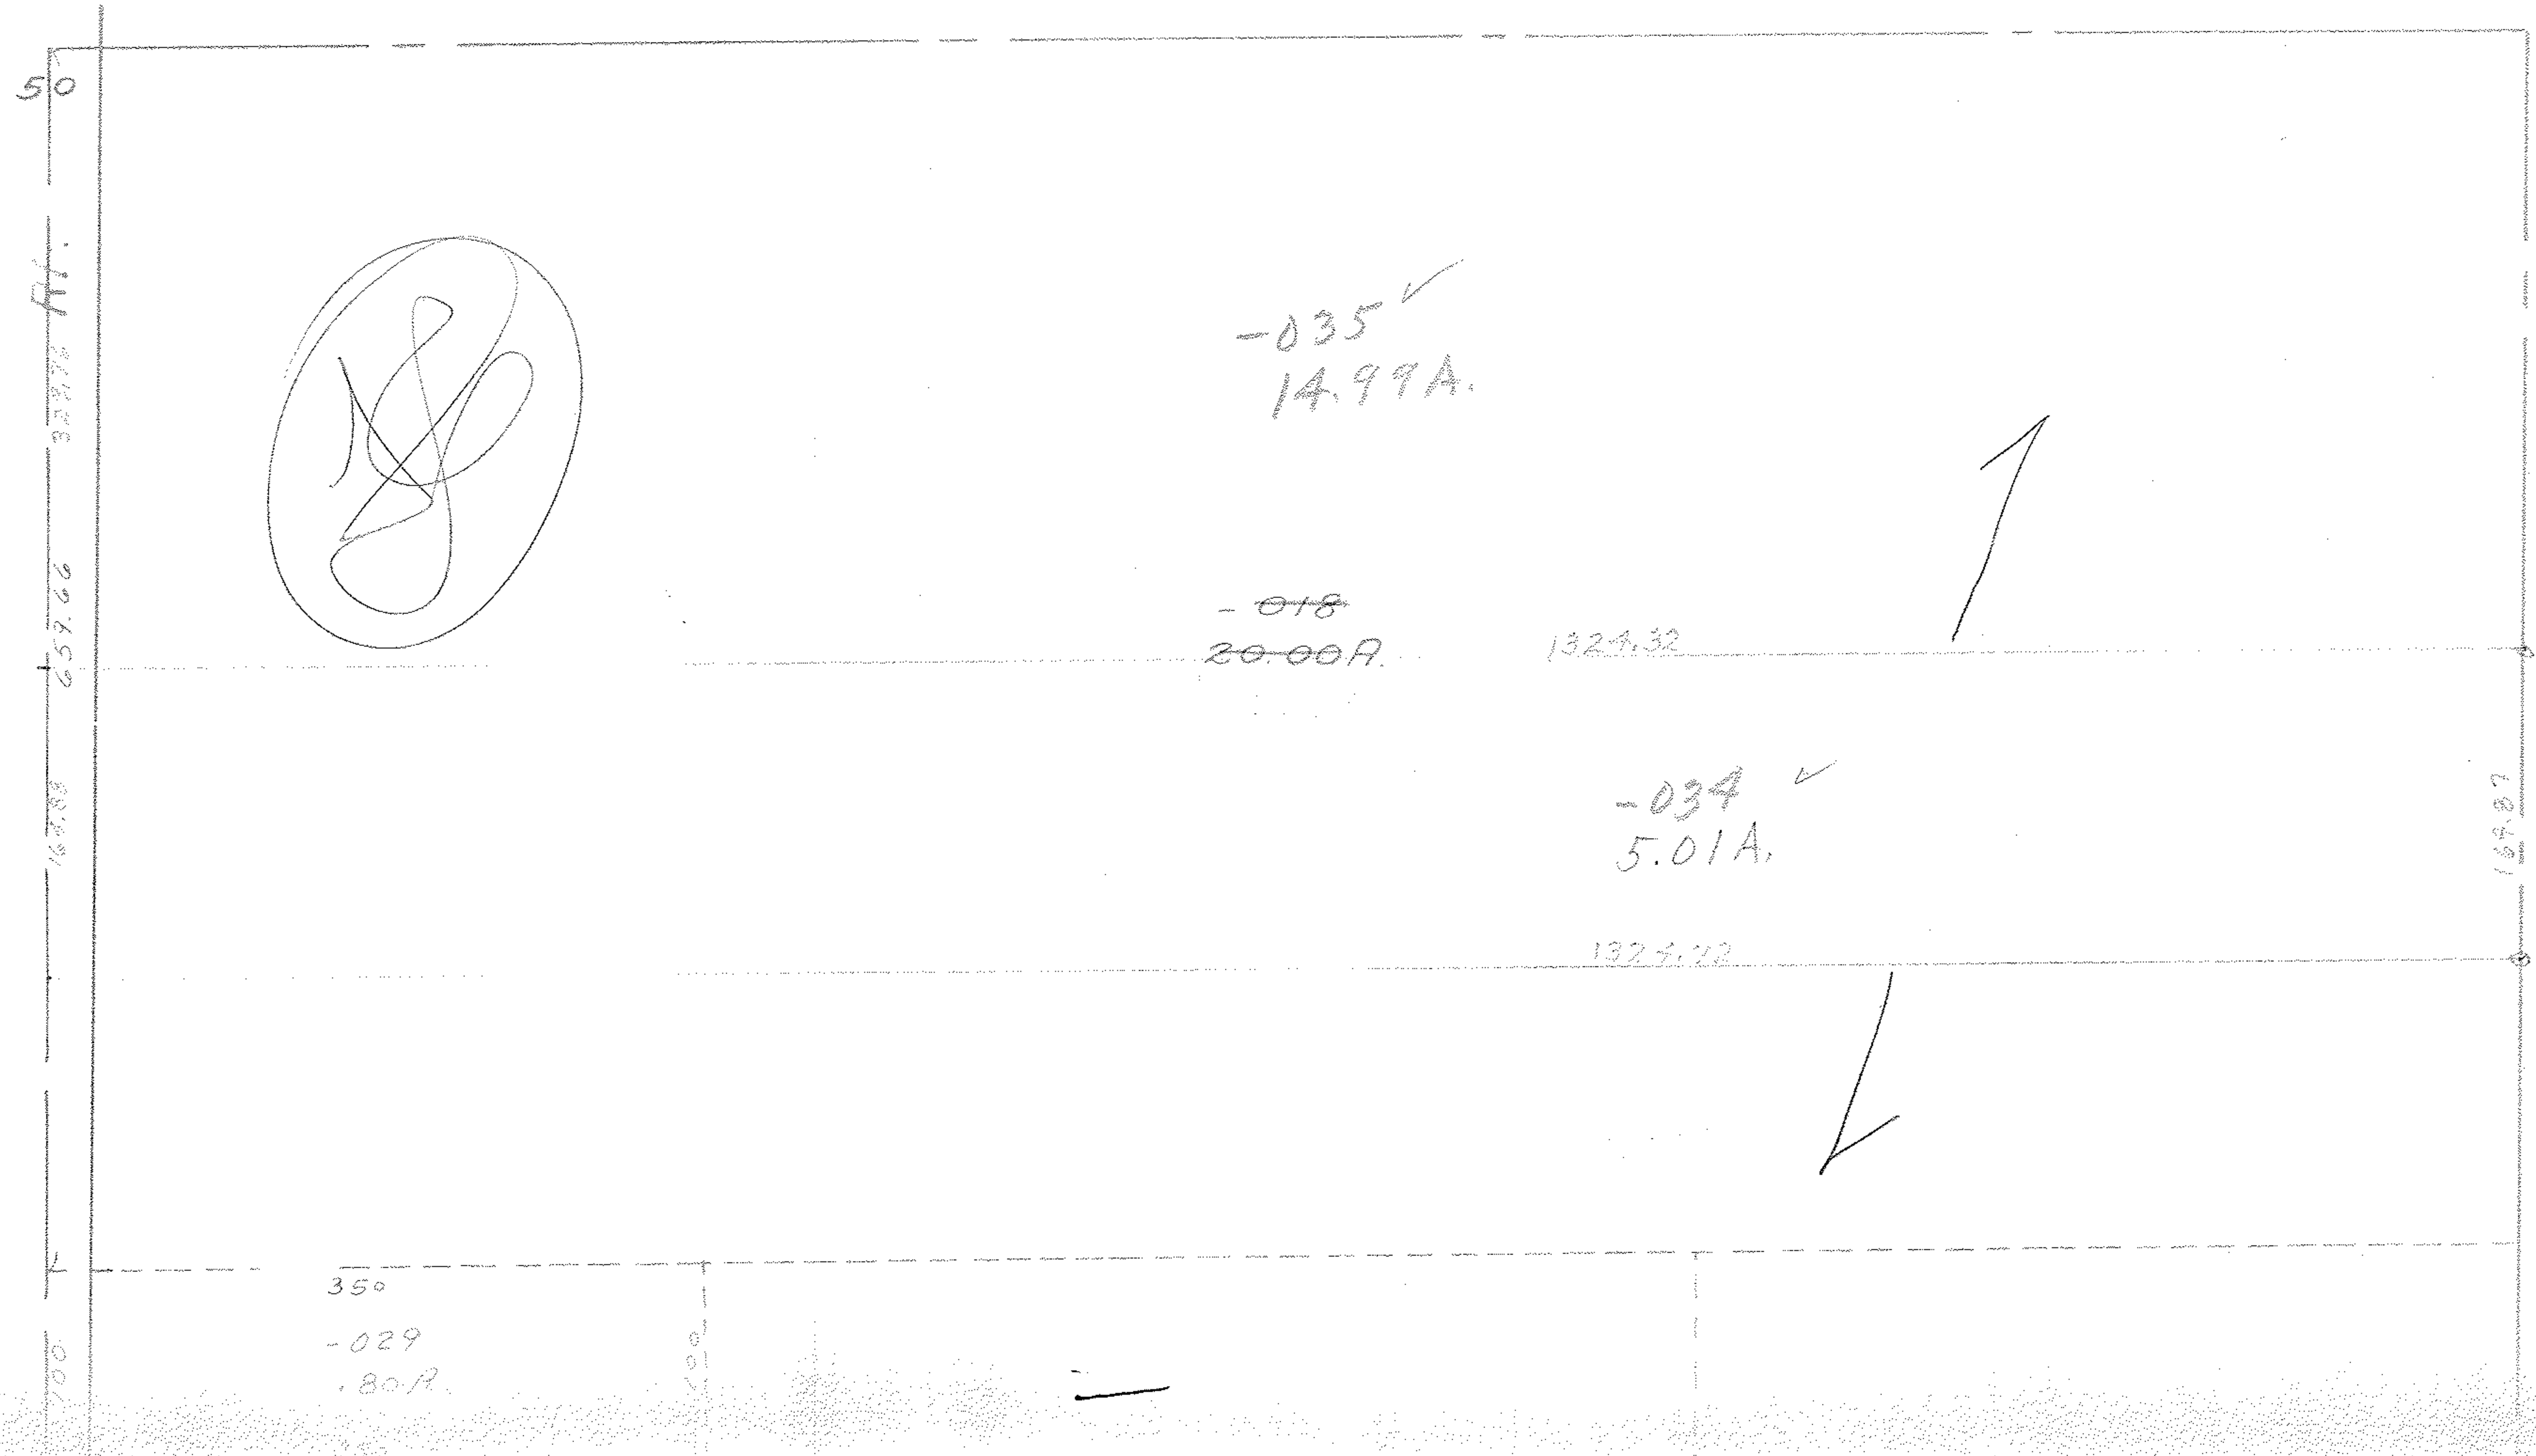

NOV 23 1971

S.S. 7-22-71

5291

APPROVED
LORAIN CO.
MAP DEPT.
DATE 10/11/71
12-00-082-B
BY R.L. Kelling