



5294

413 520
 146
 63,597.60
 332.89 = 191.04

3

RD.

2

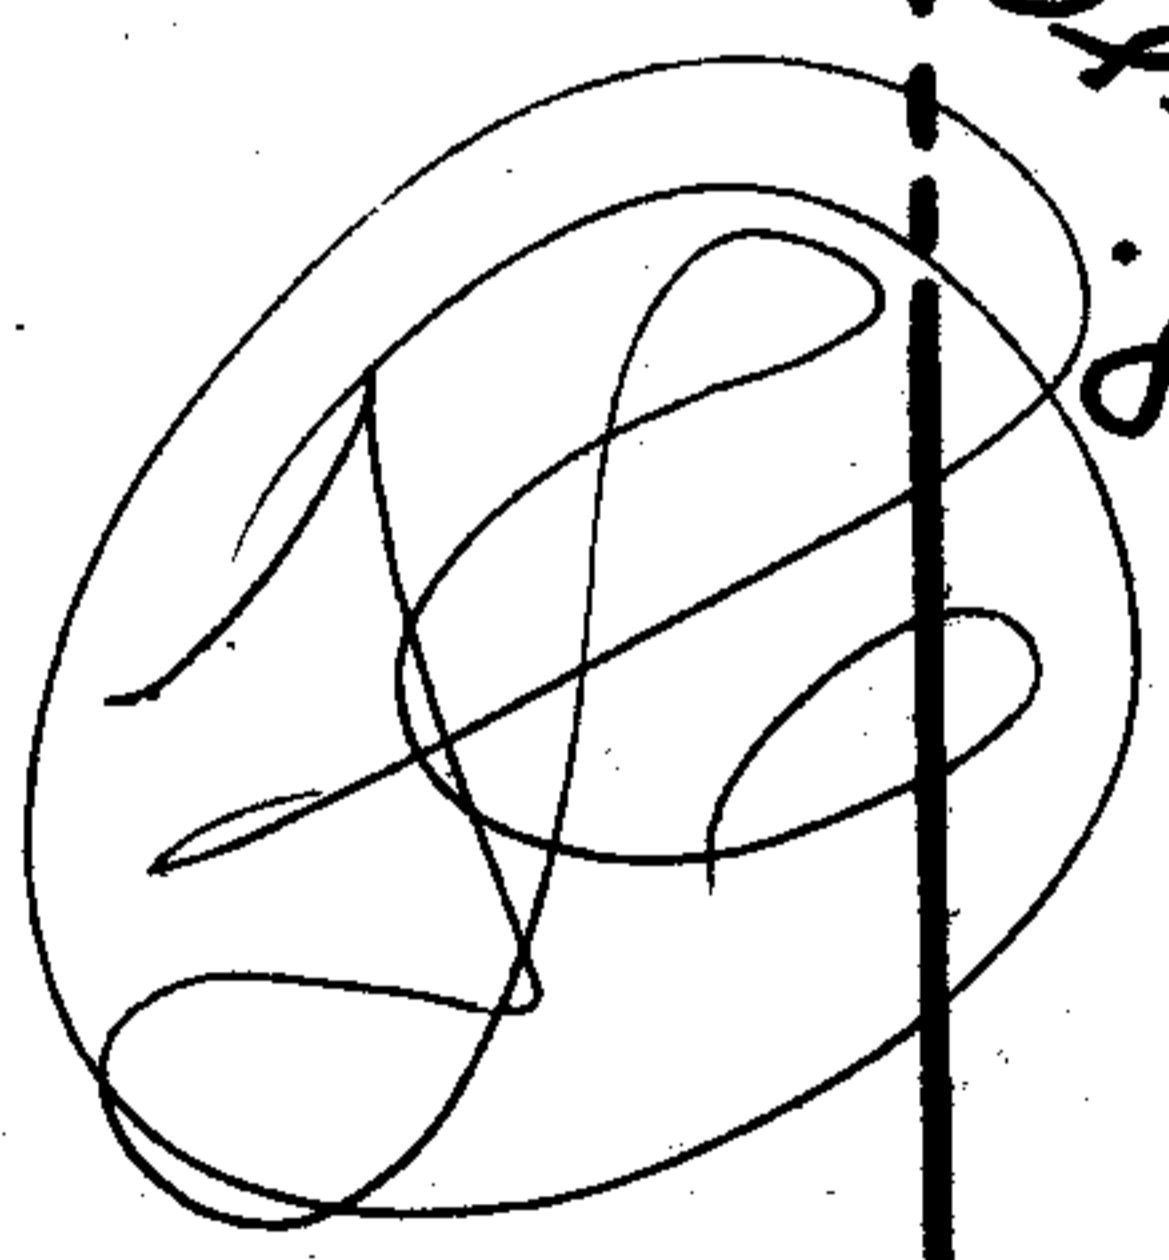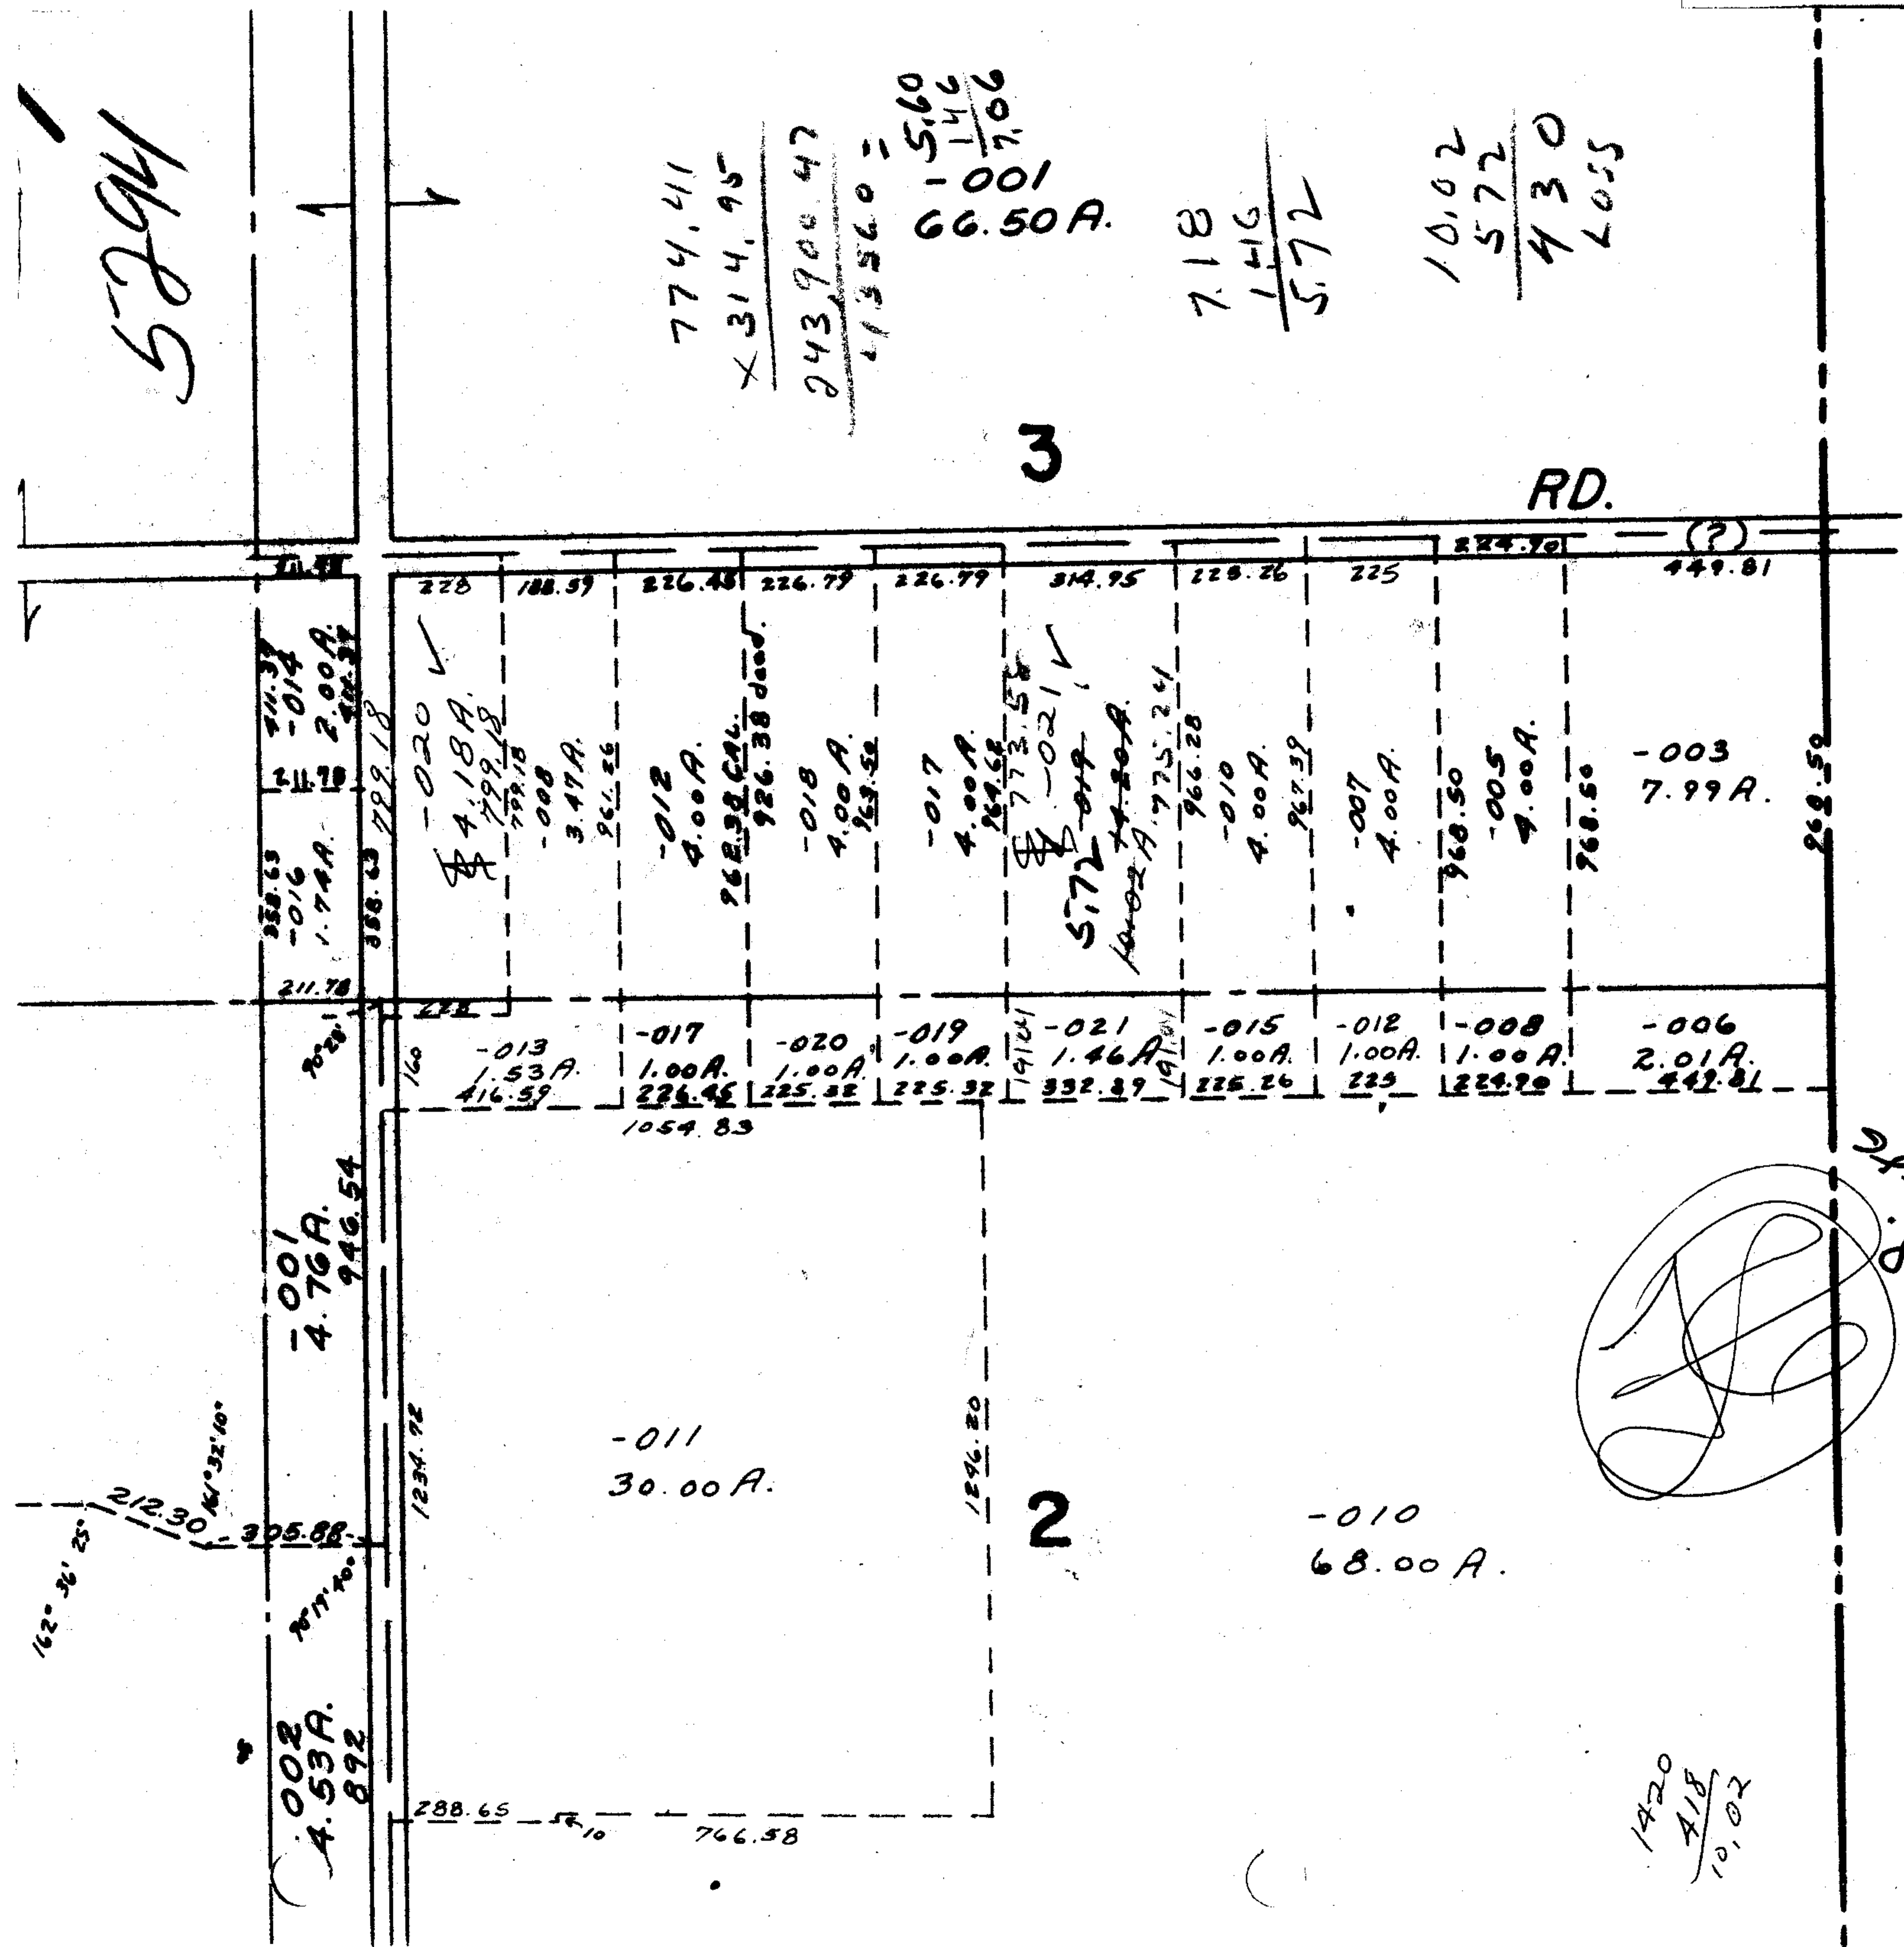

SP-87-8
 17-8-71

See 5378
 NOW 23 ENT

5294

| |
|-------------------|
| APPROVED |
| LORAIN CO. |
| MAP DEPT. |
| DATE 10-4-71 |
| 20-D |
| BY <i>Halbert</i> |

1420
 418
 10.02

774.41
 X 314.95
 243,900.47
 13560 =
 15.60
 146
 66.50A.
 7.18
 1.416
 5.72
 10.02
 5.72
 430
 LOSS

358.63
 -016
 1.78A.
 388.63 789.18

-001
 4.76A.
 946.54

002
 A.53A.
 892

| | | | | | | | | | |
|--------------------------------------|--------------------------|---|--------------------------|------------------------------------|------------------------------------|--------------------------|--------------------------|--------------------------|--------------------------|
| 228 | 188.59 | 226.48 | 226.79 | 226.79 | 314.95 | 228.26 | 225 | 224.90 | (?) |
| -020 ✓ 4.18A. 799.18 799.18 | -008 3.47A. 964.26 | -012 4.00A. 962.38 CAL. 926.38 dand. | -018 4.00A. 963.52 | -017 4.00A. 969.62 773.58 | -021 ✓ 5.72 775.24 966.28 | -010 4.00A. 967.39 | -007 4.00A. | 968.50 -005 4.00A. | 768.50 -003 7.99A. |
| -013 1.53A. 416.59 | -017 1.00A. 226.46 | -020 1.00A. 225.32 | -019 1.00A. 225.32 | 191.21 -021 1.46A. 332.89 | 191.21 -015 1.00A. 225.26 | -012 1.00A. 225 | -008 1.00A. 224.90 | -006 2.01A. 442.81 | |

-011
 30.00A.

-010
 68.00A.