


-036
~~-035~~
 10.45 A
 9.97

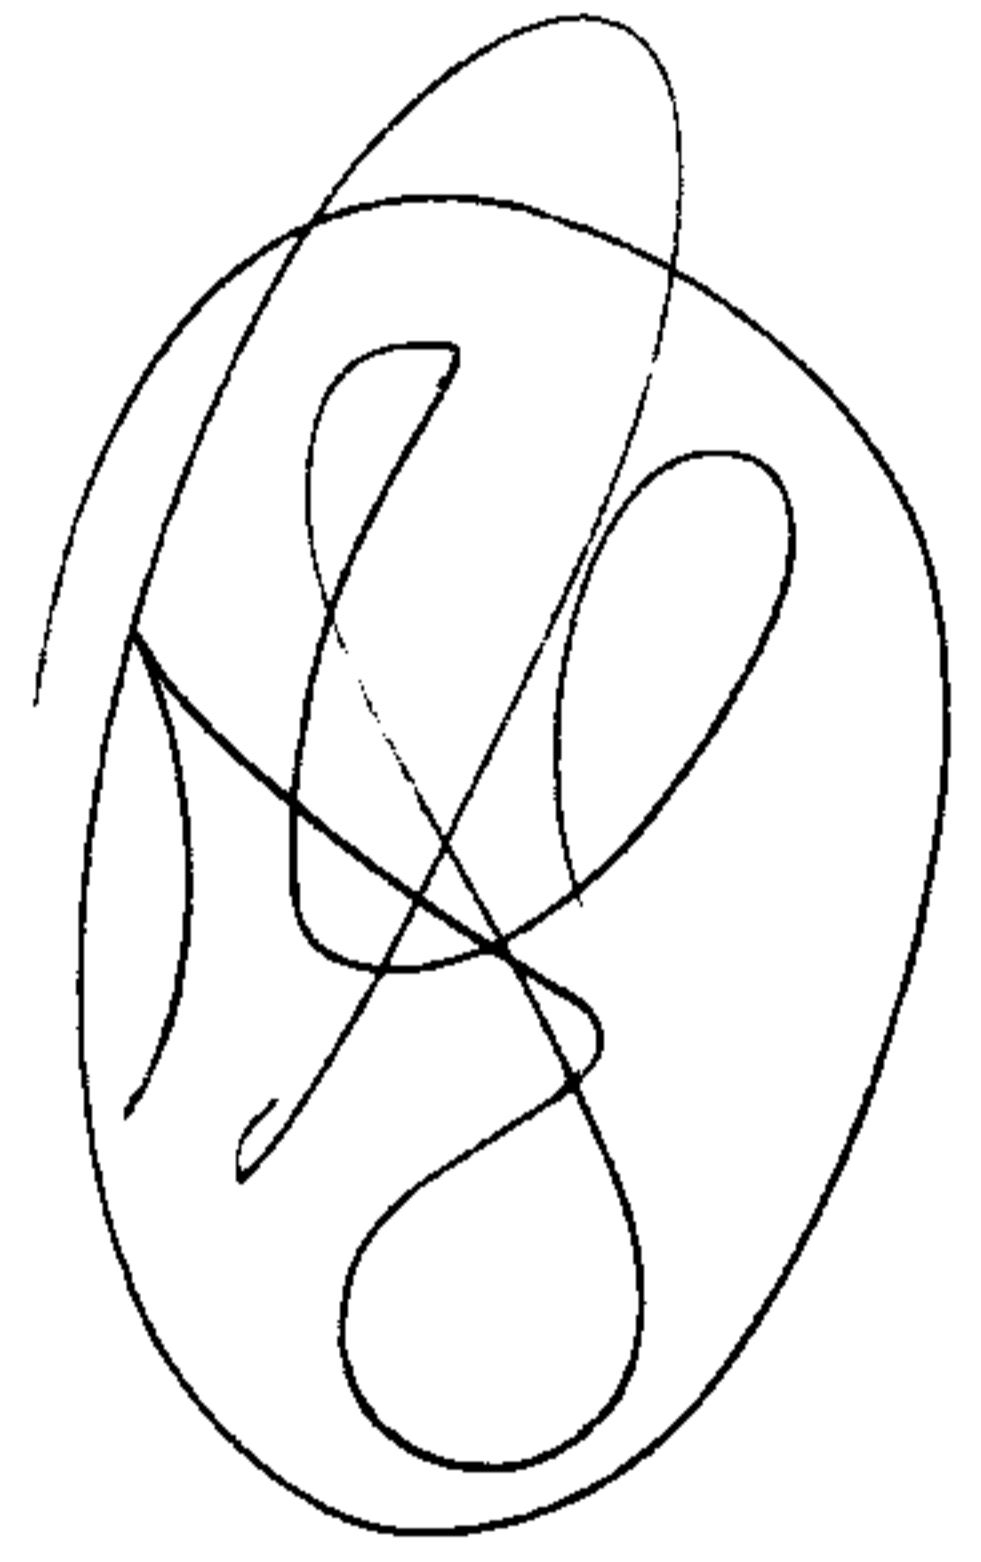

NOV 23 1986

432.86

5308

APPROVED	
LORAIN CO.	
MAP DEPT.	
DATE	11-13-86
BY	[Signature]

5308

-037
 1.06 A Cal.

-032

93.34

-034

34.4