


90	80	75	"	"	"	"	"	"	75	30	30
5320 26-014	-015 27-016	28-016	29-017	103 30-018	31-019	32-020	33-021	34-022	35-023 143	NAPLES	
90	80	75	"	"	"	"	"	"	75	30	30


TONETTE

ST. 30.0

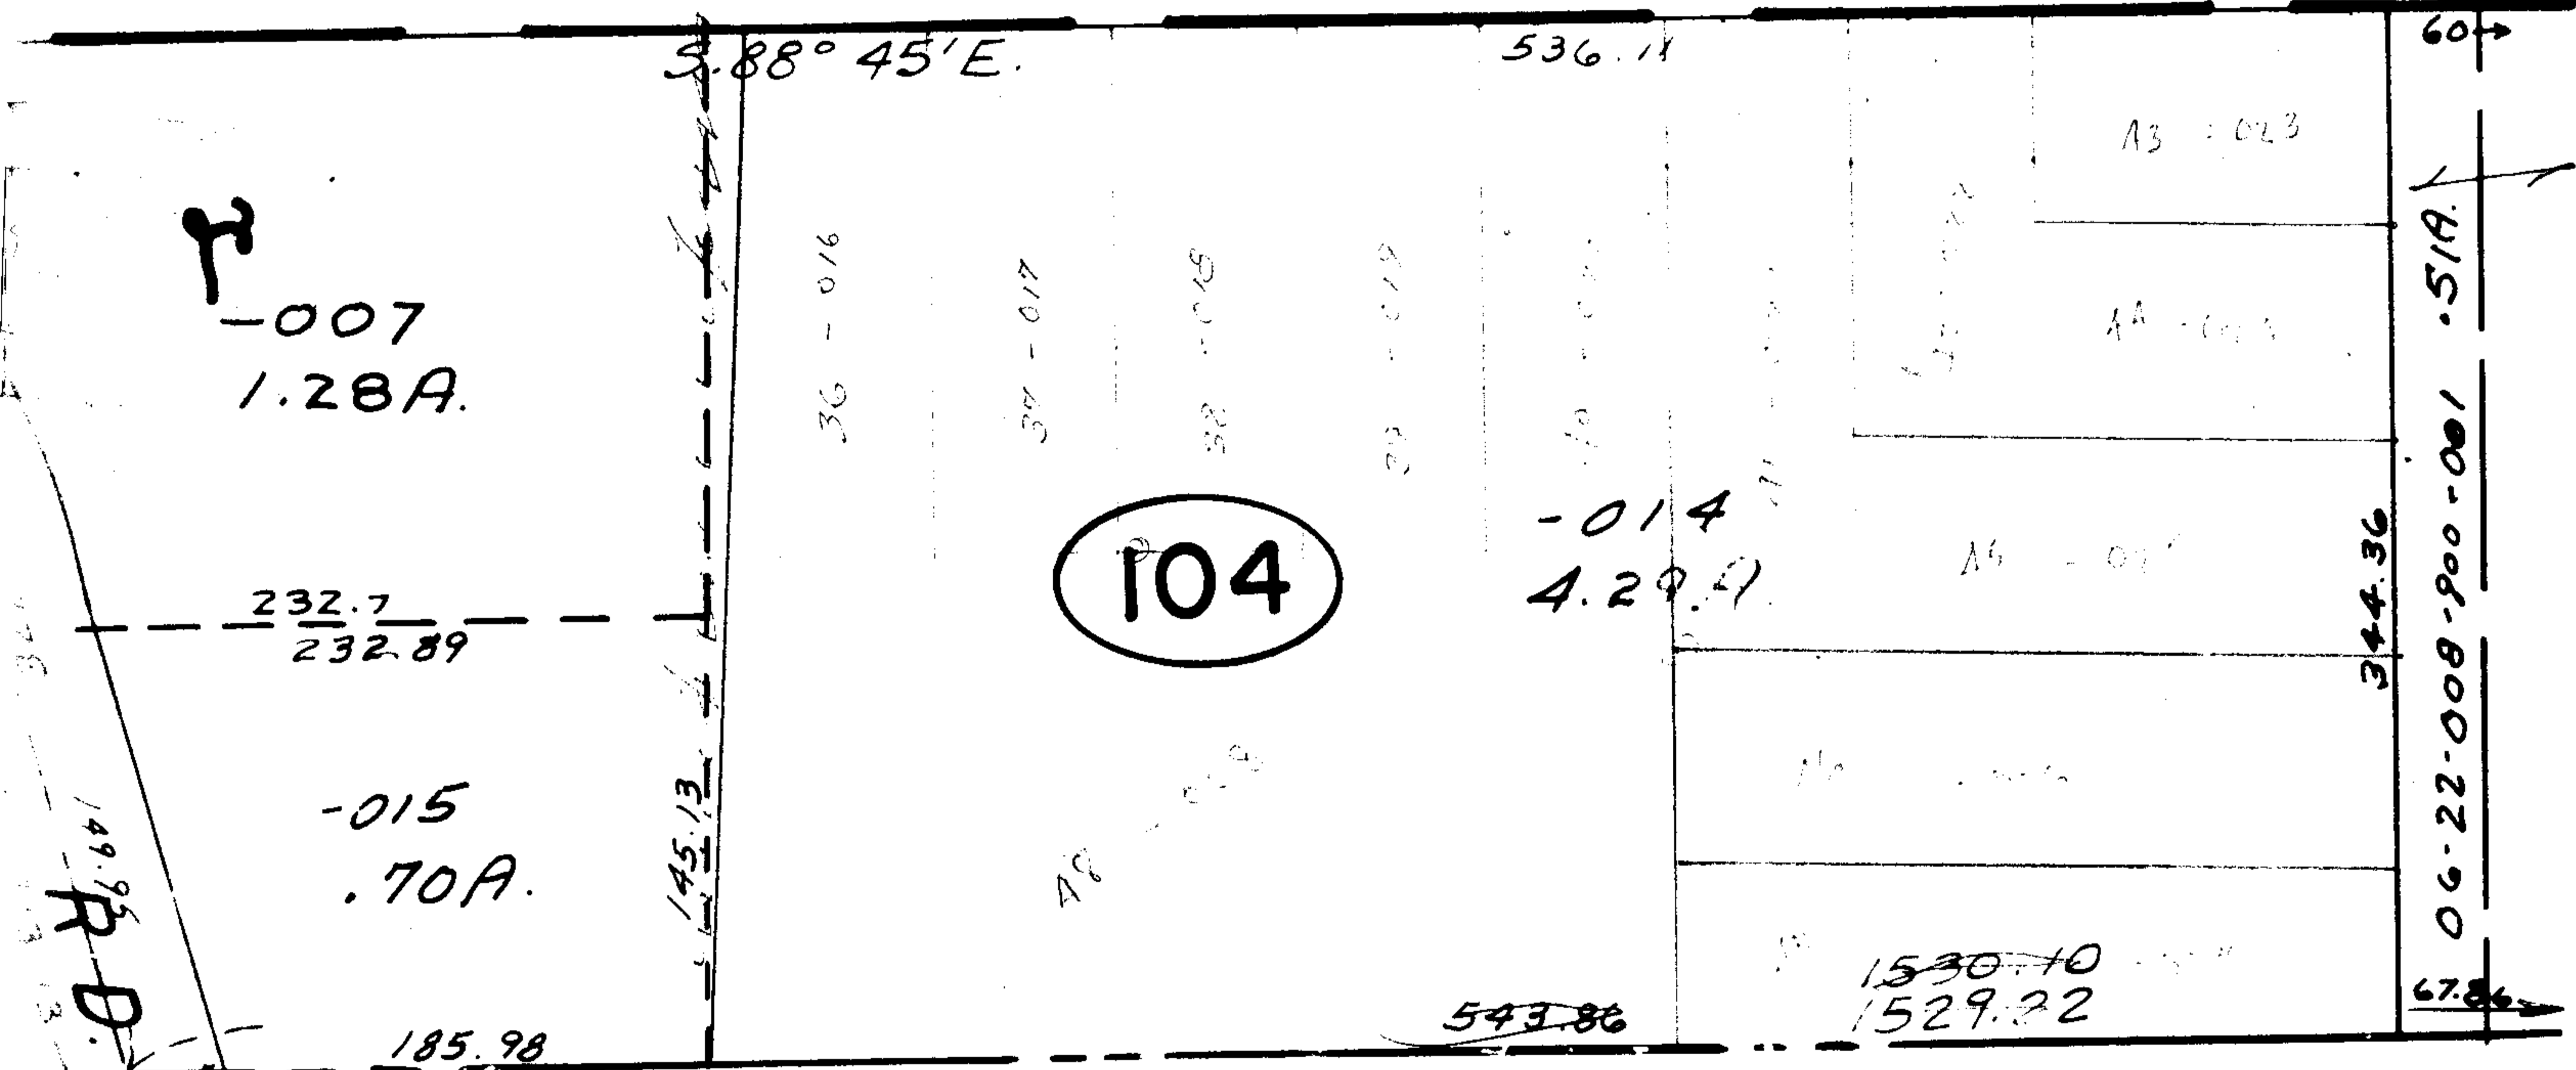

60
7
320
420
10
536

Pl. Co. 17 R. 140444 # 2
New P. 100 T. 10 F. 10 W.

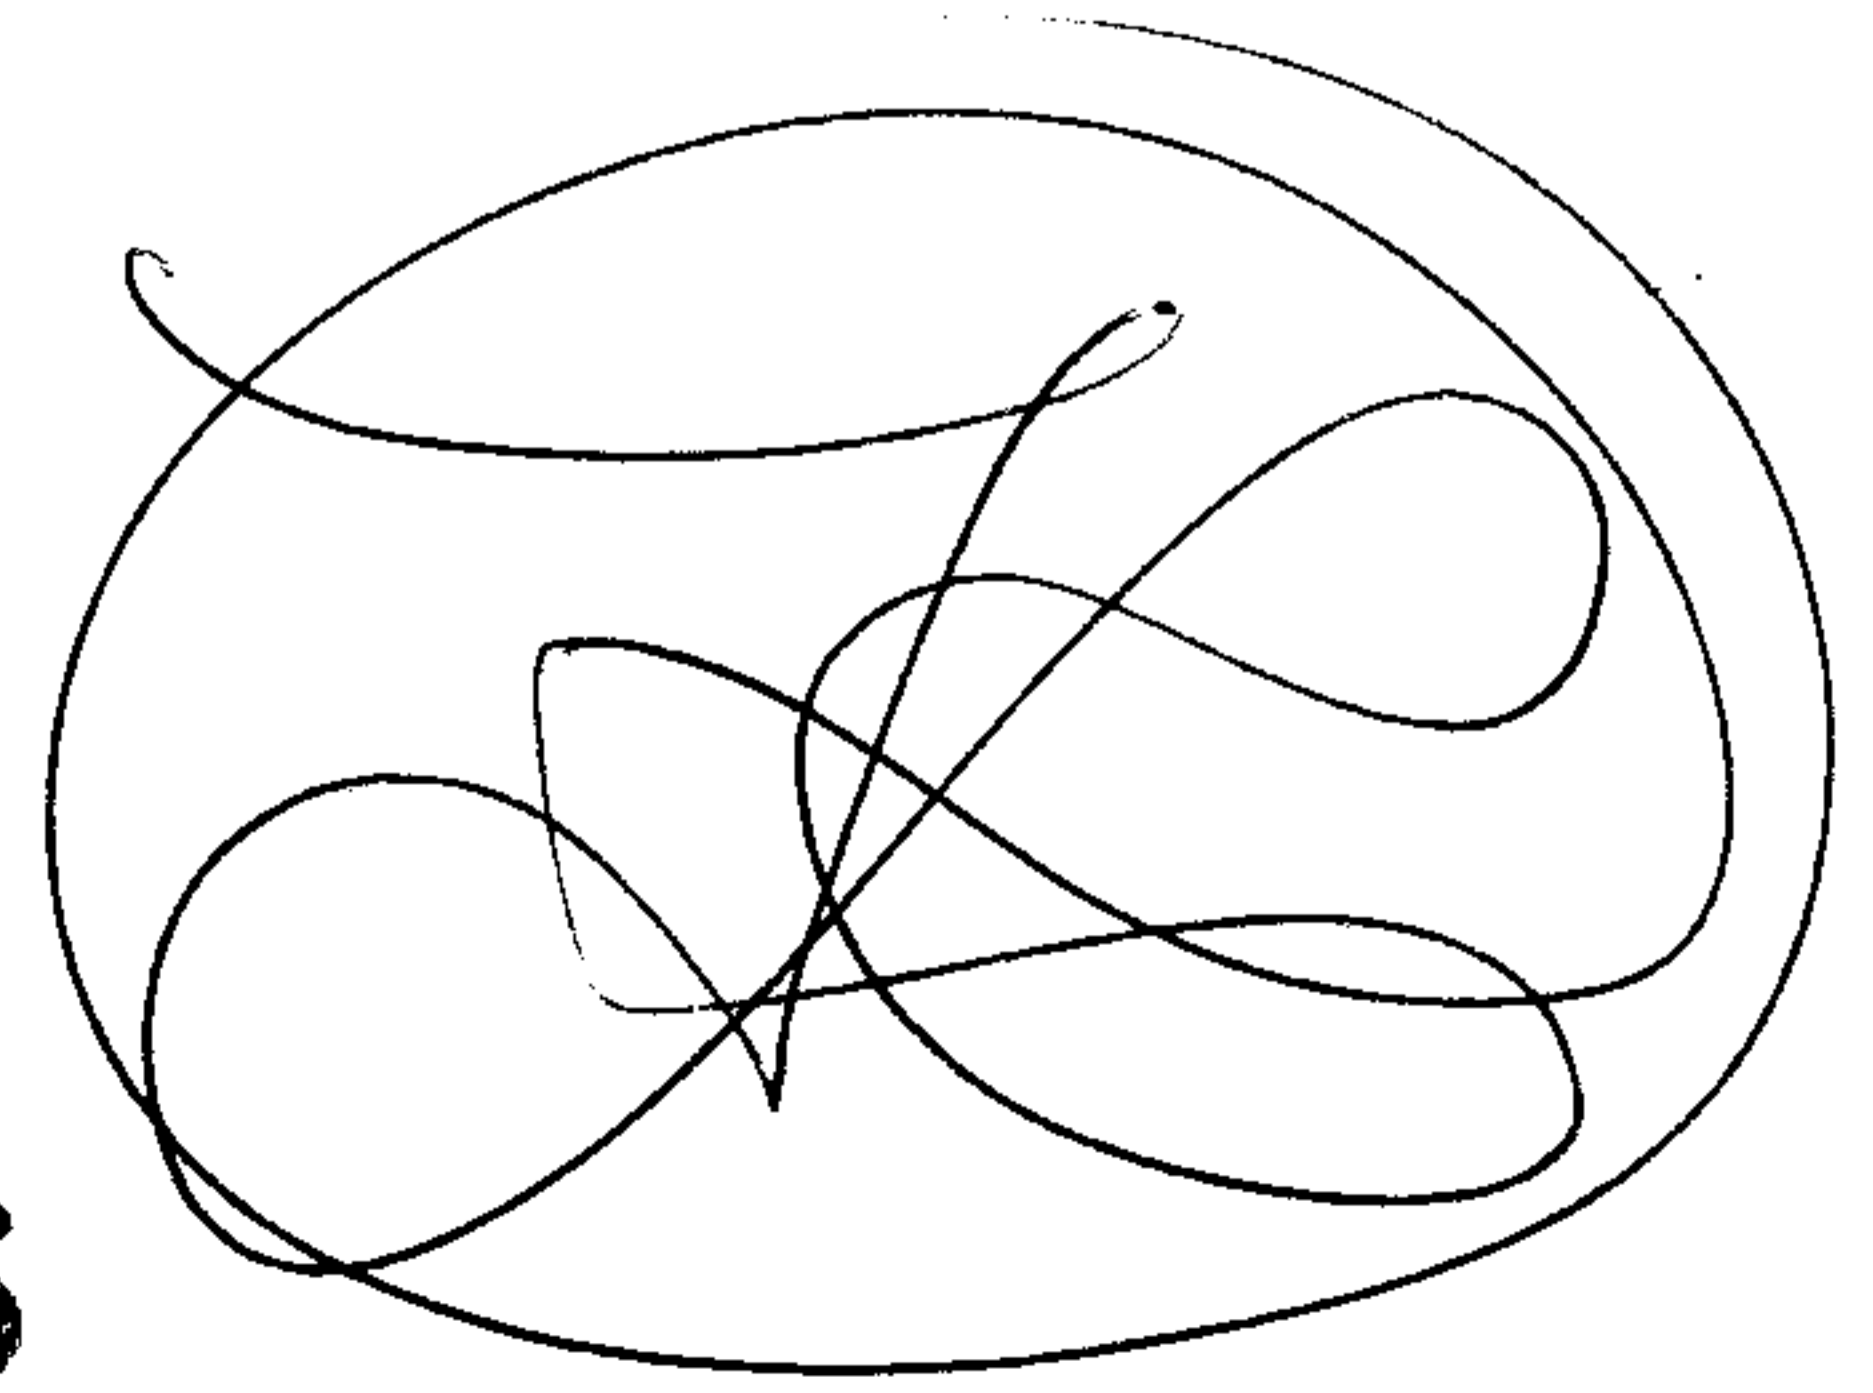

8 DAY TRACT, Ely PT. LOT 6