

5323

-001
10.00 A.

-002
6.00 A.

-003
50.57 A. Dup.
50.75 A. Map

895

70 496

63

~~-005~~
-004
99.25 A.
78.22


-006

385
190.06
1.034
255

140

997.85

NOV 23 ENTD

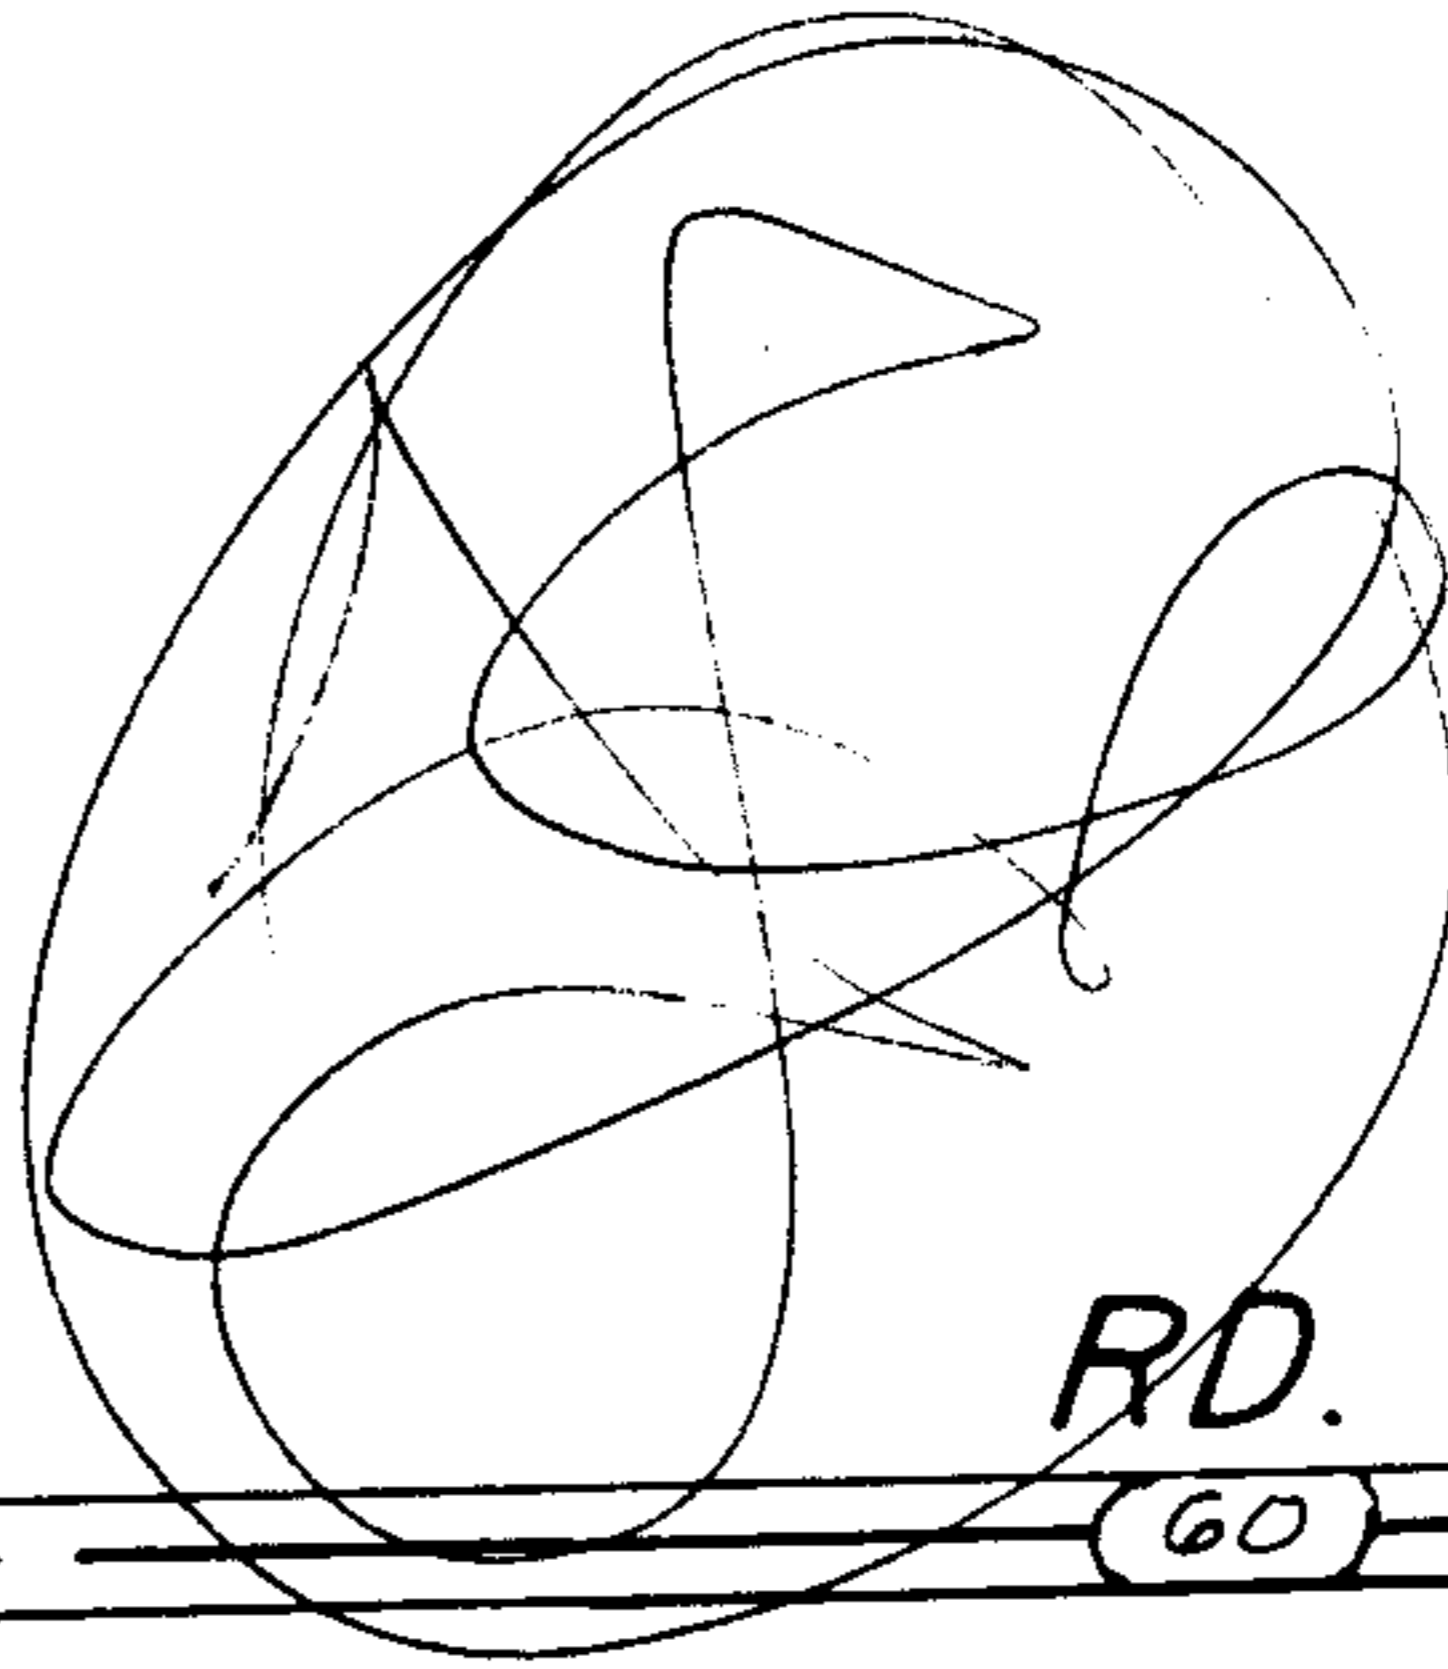

RD.

60

1.33

APPROVED
LORAIN CO.
MAP DEPT.
DATE 10/20/71
15-F
BY R.J. Kelling

7-28-84
L.H.

-002
62.93 A.

R. R.

-003
5.00 A. 594

734.25

100