


APPROVED
 LORAIN
 MAP D.L.
 DATE 10-26-71
 BY L.W. Hill

Handwritten signature

Map 141 only

100-033 = 10,15X 1/65'
 100-034 = 39,855 1/32.00
 100-035 = 55,000 1/49.86
 100-036 = 93,03X 1/12.23

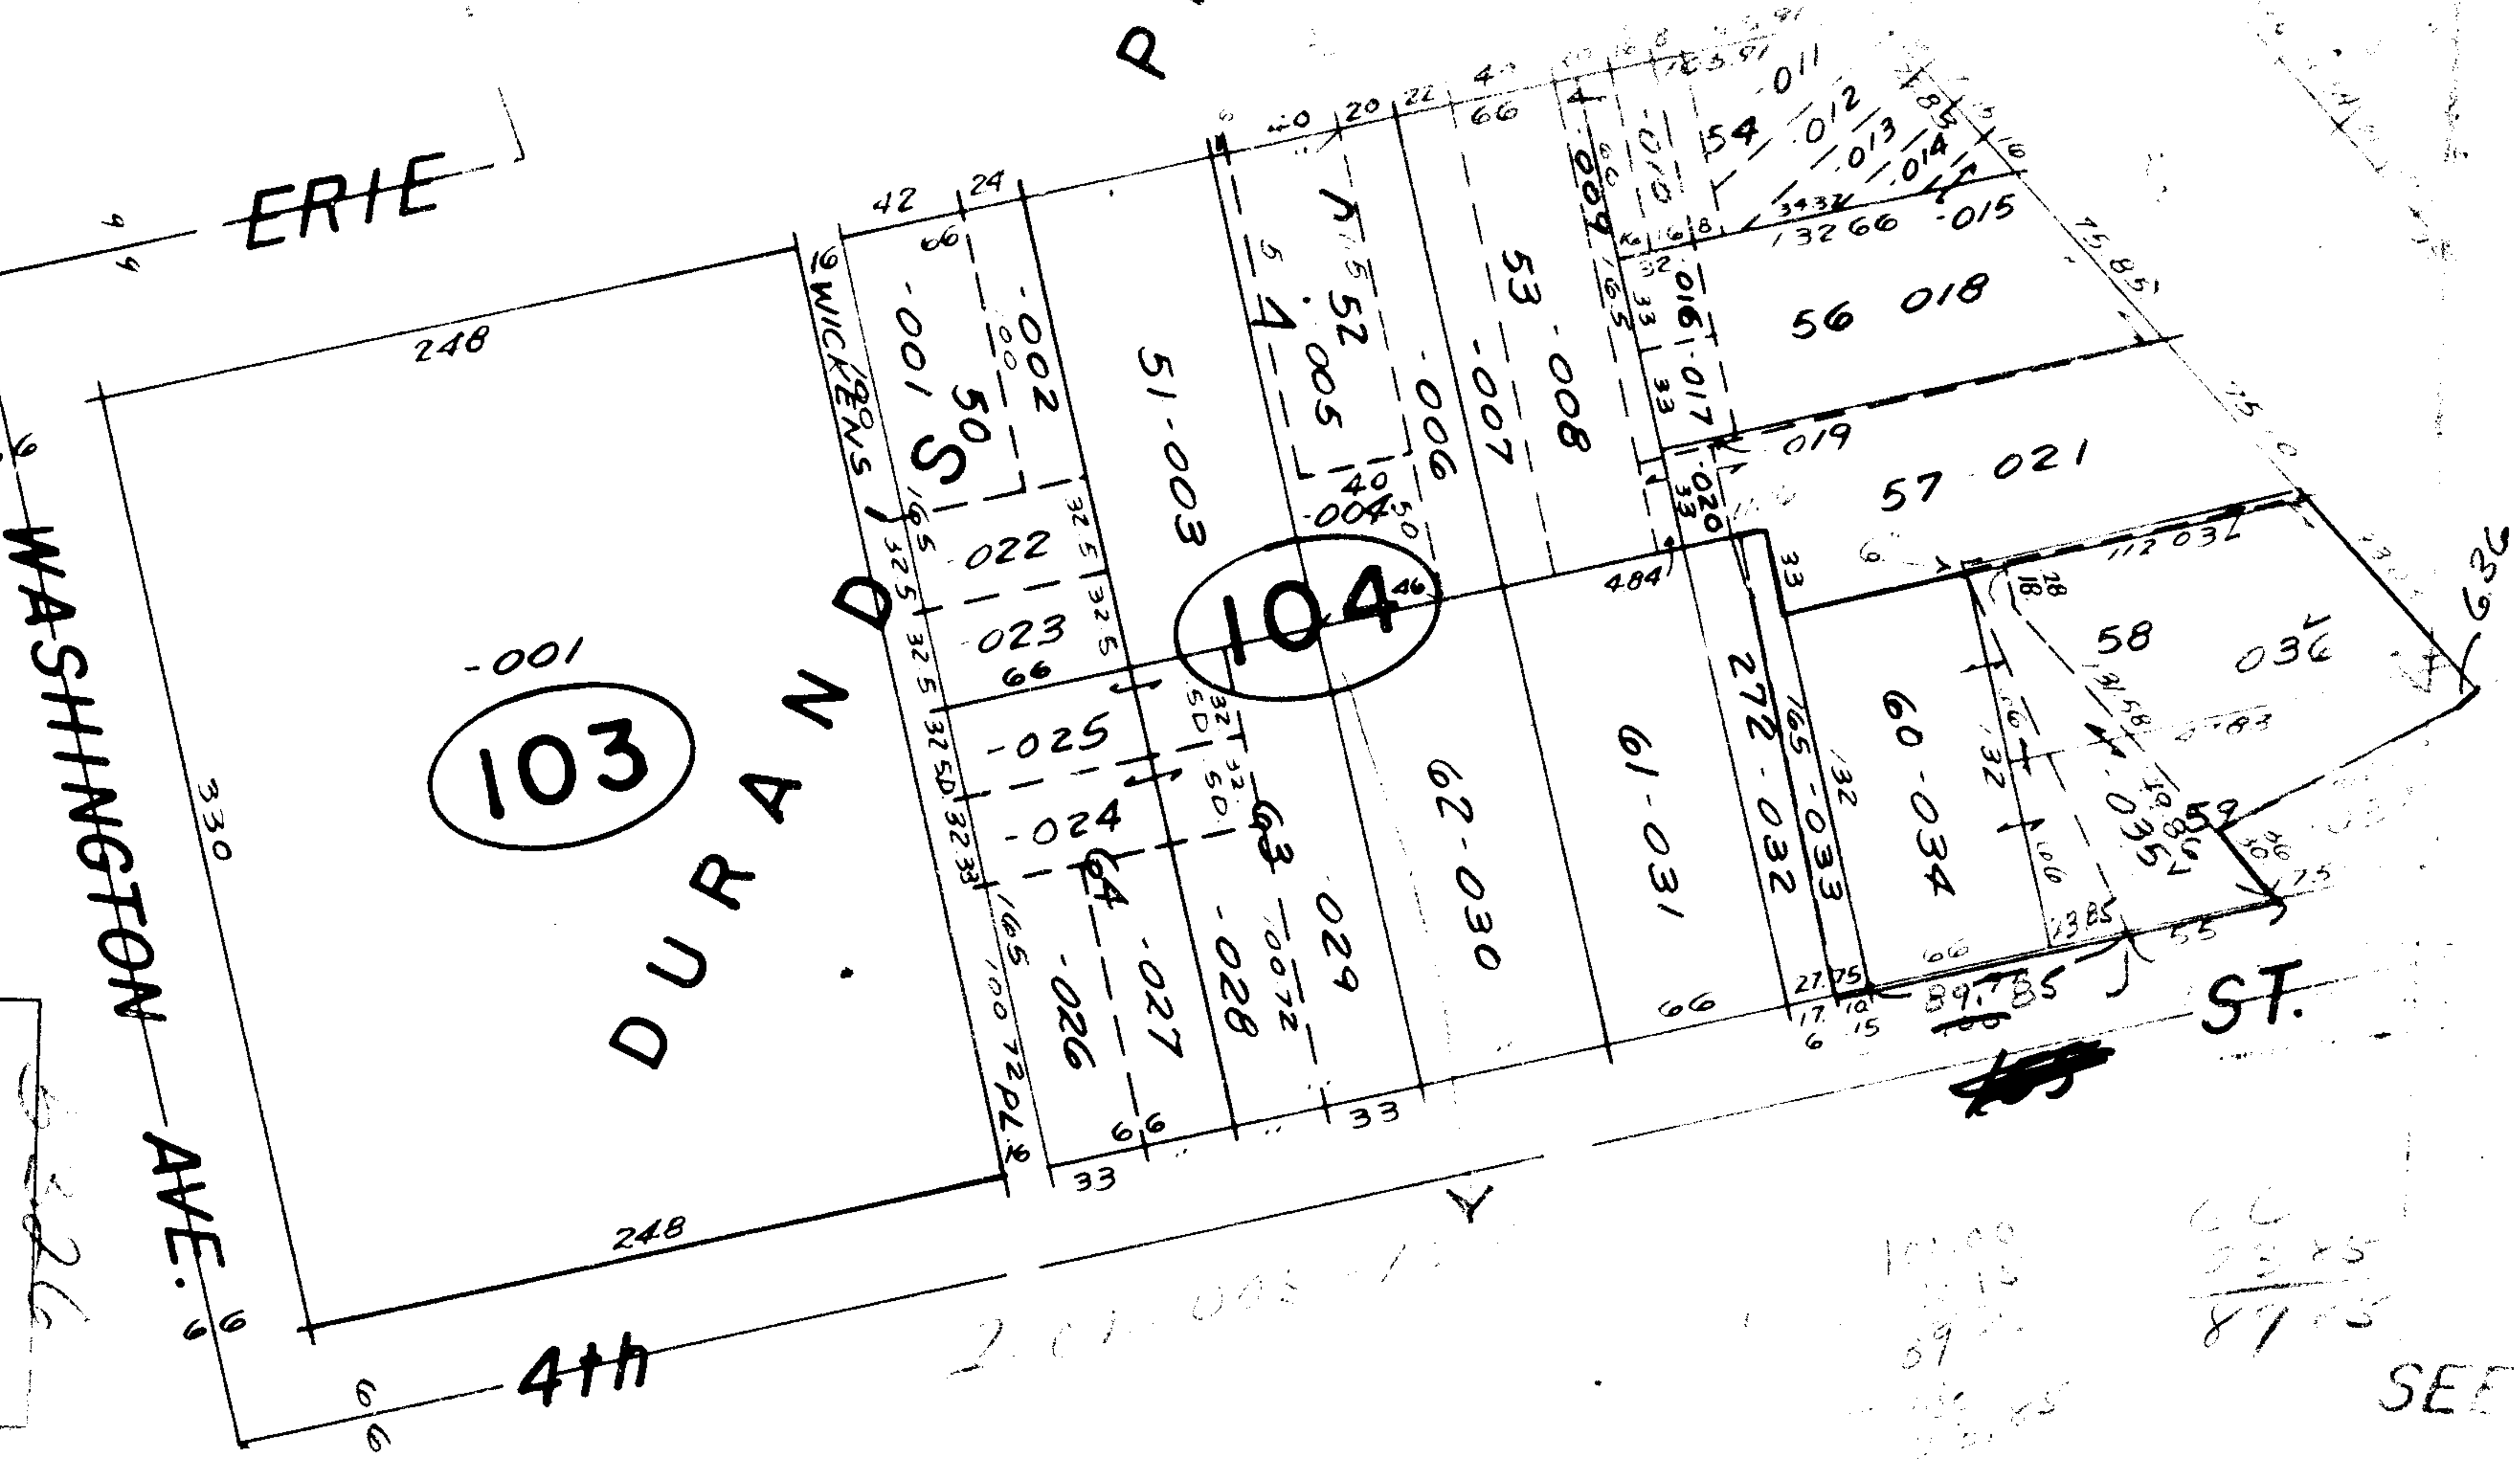

BLACK RIVER TW

SCALE: 1" = 100'

01-004-A

Copyright 1964

SEE

#532C

10,000
 21,000
 39,000
 59,000
 89,000

66
 23.85
 89.85