

5337  
 New Map To Follow  
 8-B+8C

-001  
 35.50 A.

-013  
 15.68 A.

-015  
 12.65 A.

-016  
 6.60 A.

-006  
 31.13 A.

-006  
 5.69 A.


-005  
 24.50 A.

-001  
 55.42 A.

13.69  
 53.05  
 14.27

47  
 117  
 610  
 728  
 14102

28.29  
 1.07  
 27.22  
 64  
 26.58001  
 71.83 A.

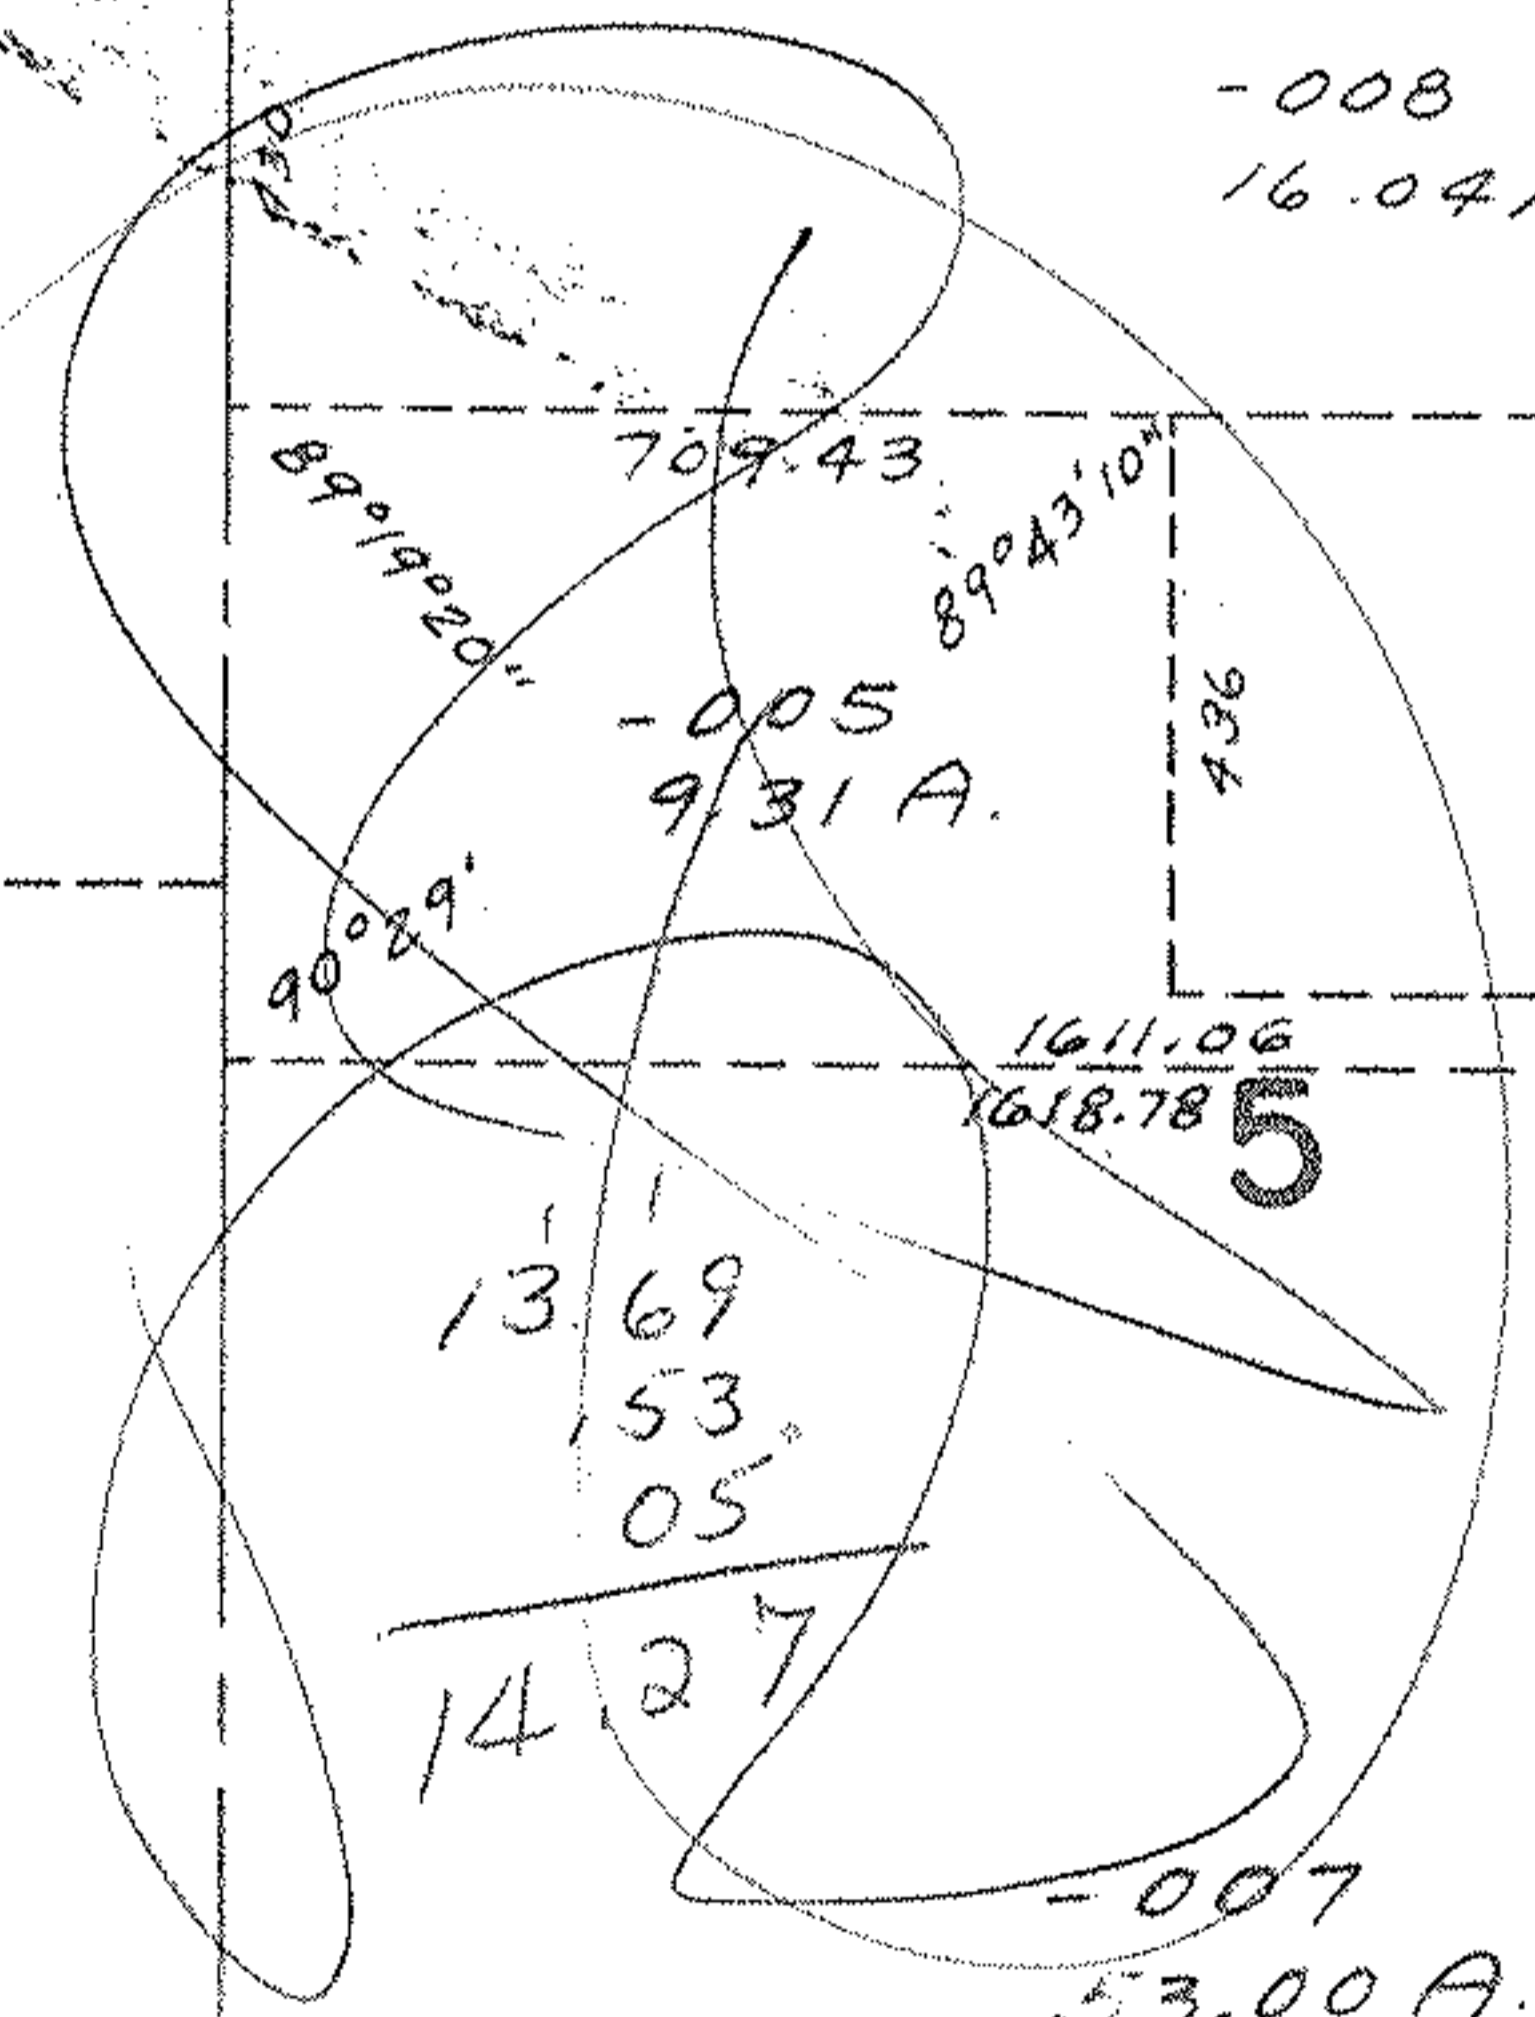

Verm Rd.

8-B

8-C

9

8

-001  
 18.30 A.

