


Map Correction


WEST

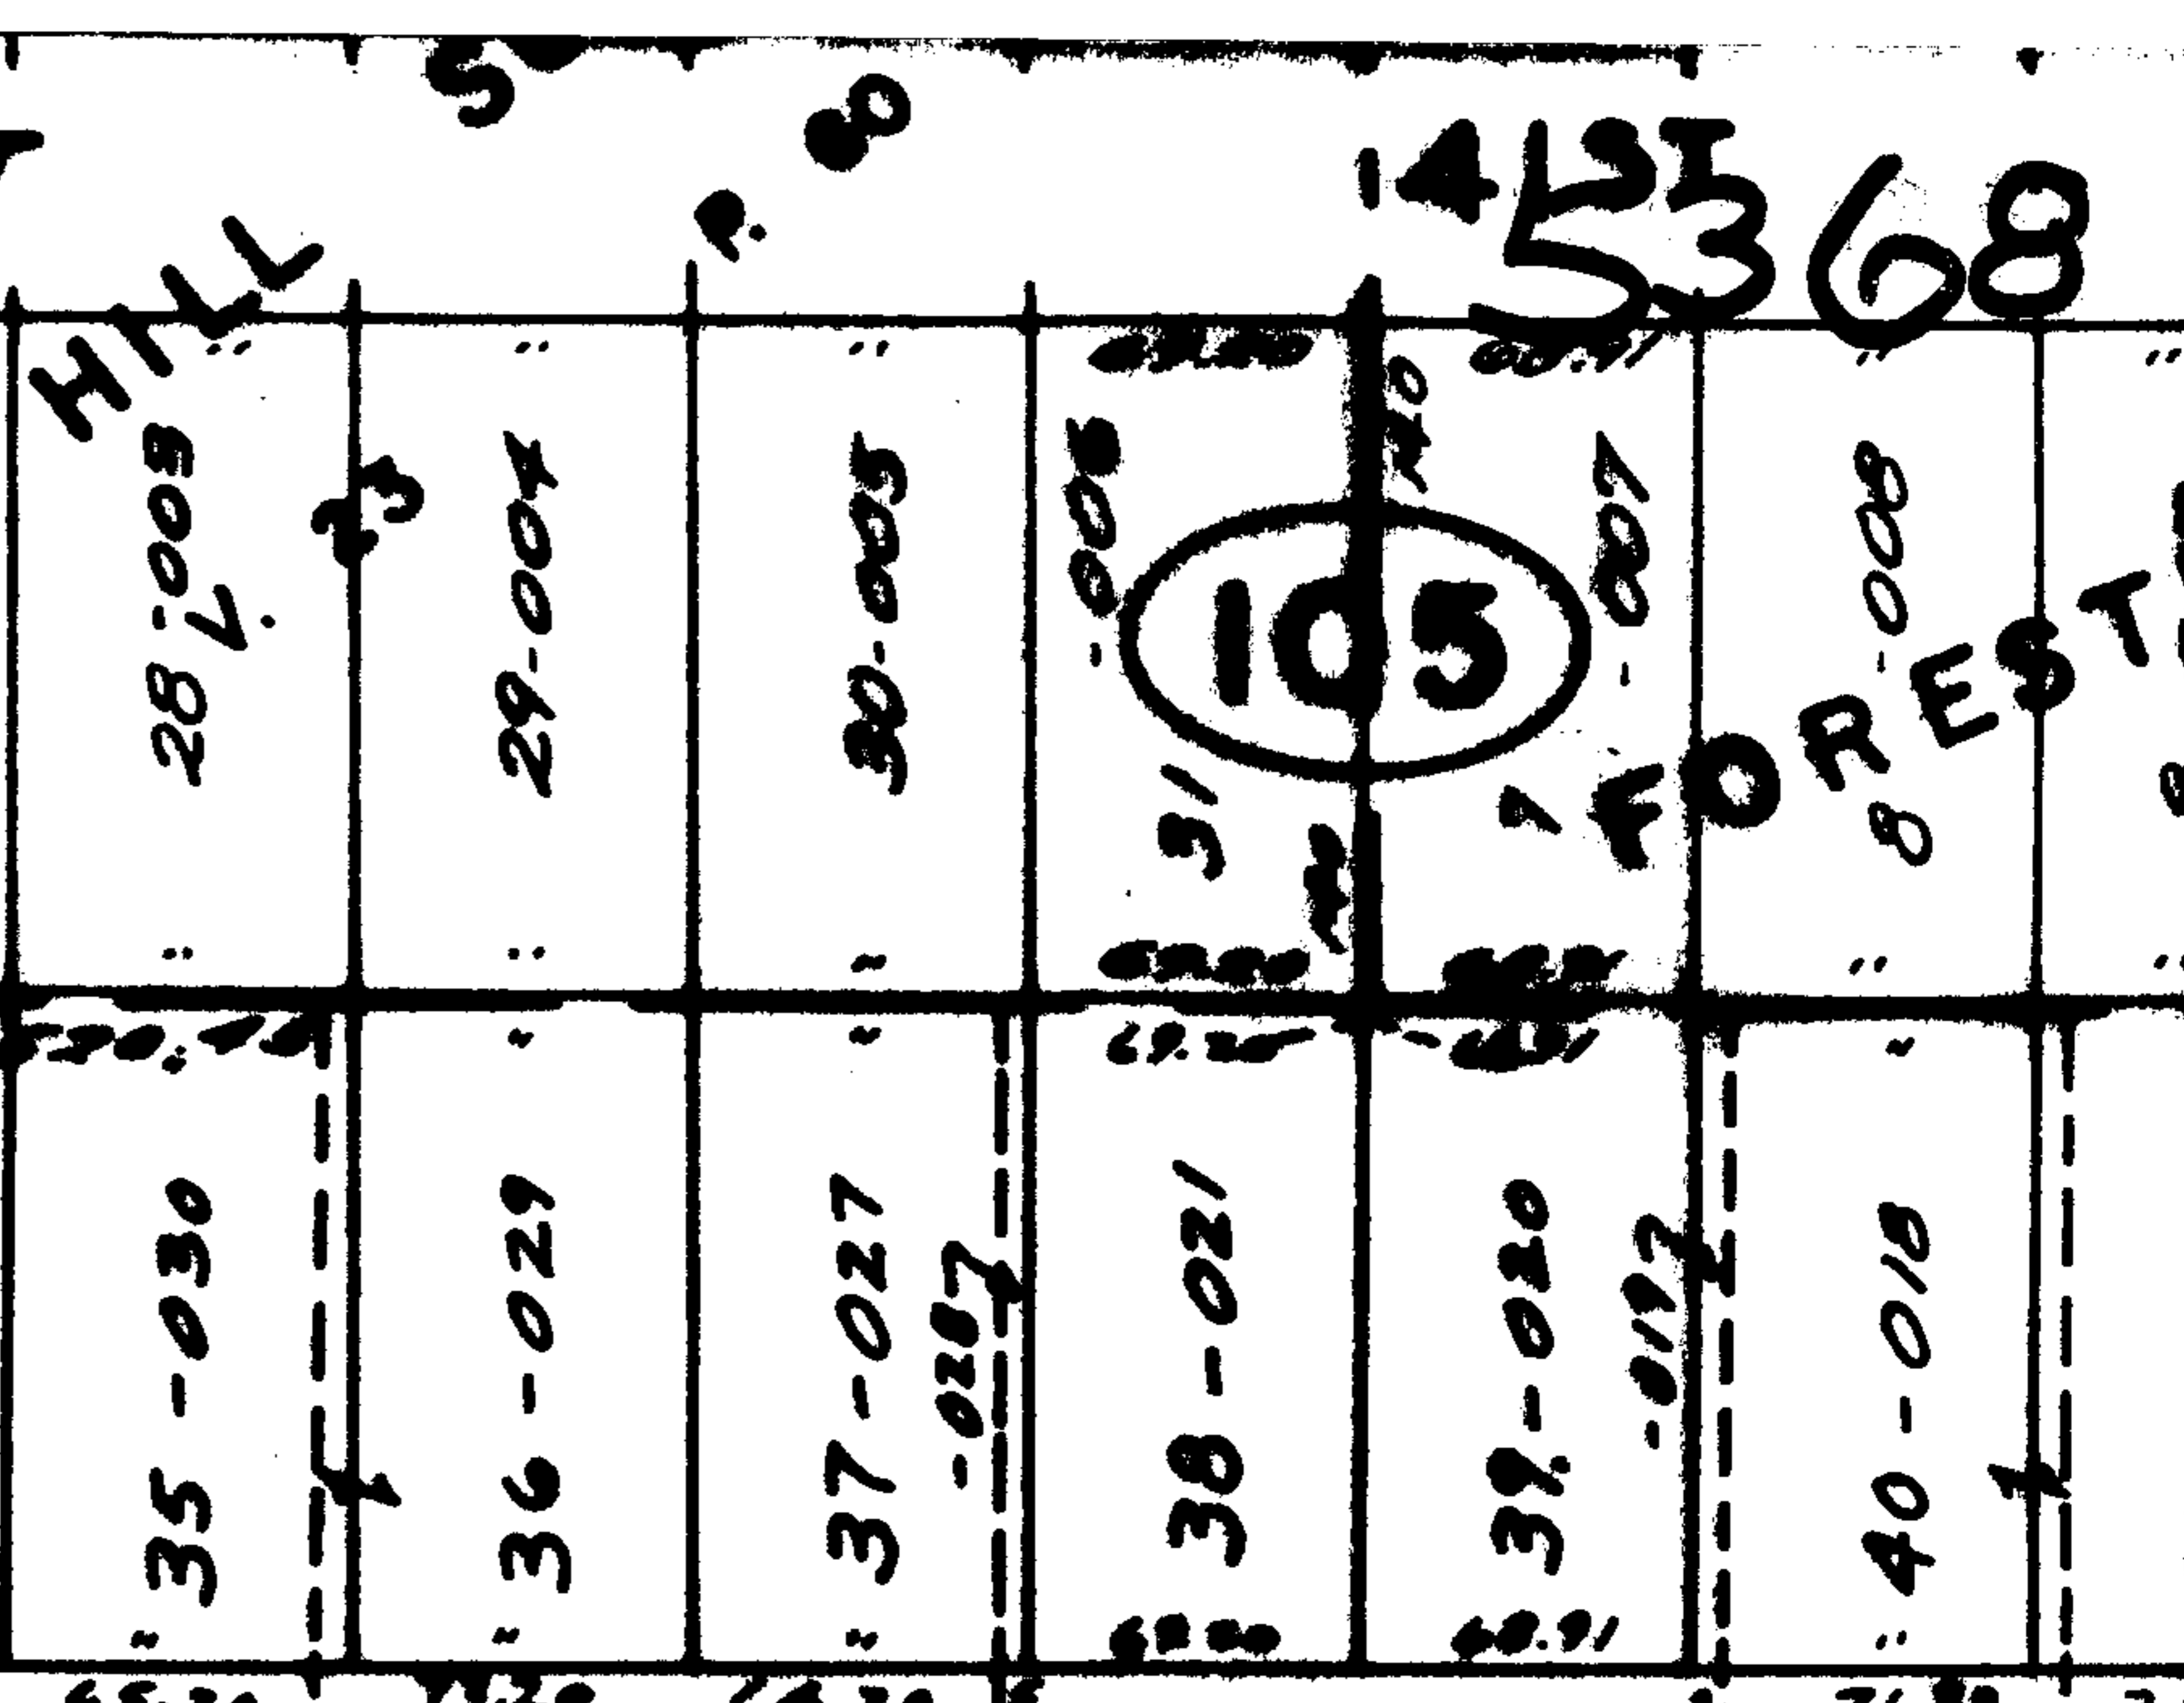

5368

WEST

42ND.

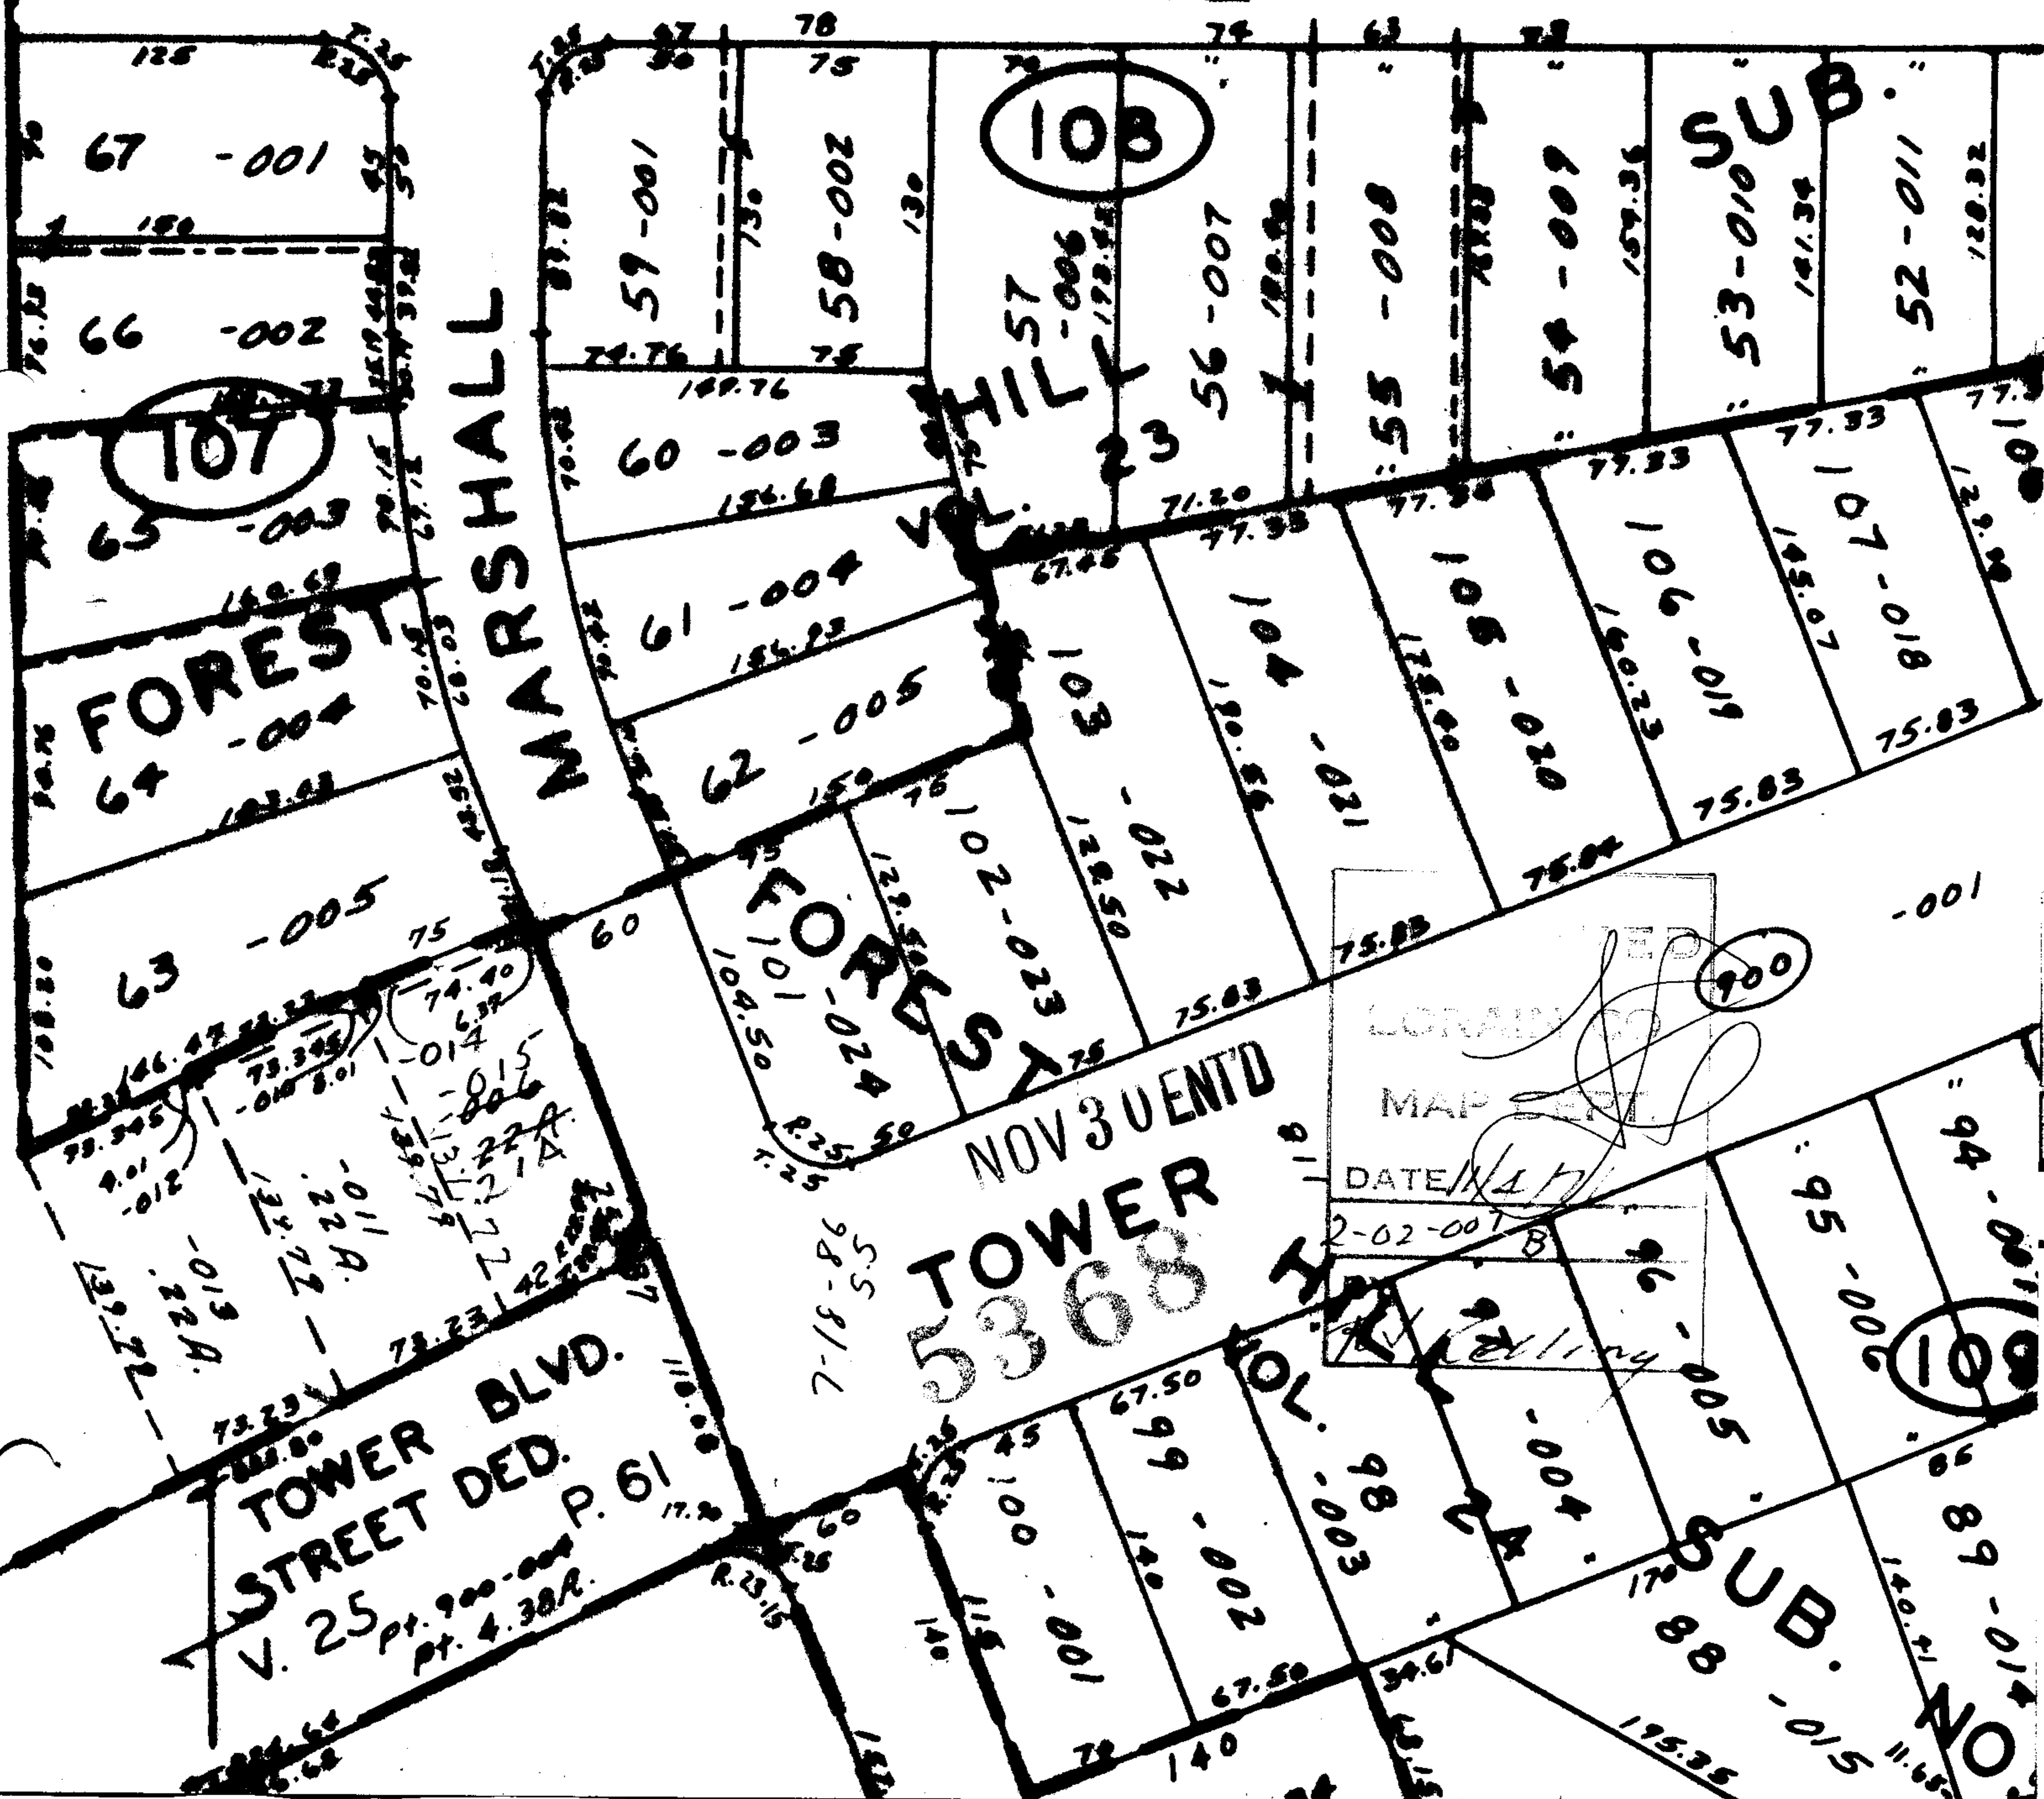

NOV 3 1902 TOWER 368

LOAN MAP

DATE 1/4/11

2-02-001

109

108

107