

85

5381

5407

5408

- 003
75.00 A.

- 007 - ~~004~~

7.10A

~~11-00A-006~~

- 005

- 001 14.00 A.

- 002
30.00 A.

- 003
27.00 A.

96

- 005
25.52 A.

- 004
61.48 A. Dup.
60.00 A. D.

Re-Split

DEC 29 ENT'D

APPROVED

LORAIN CO.

MAP DEPT

DATE 11/17/71

15-F

BY

R. L. Kelling

7-28-86
K. L. L.

ELYRIA

LATTASBURG

RD.

2427.82

233.54

31.41

427.82

1747.78

962.28

392.4

393

196.55

419.76

419.76

152


233.54

427.82

2427.82

60

301

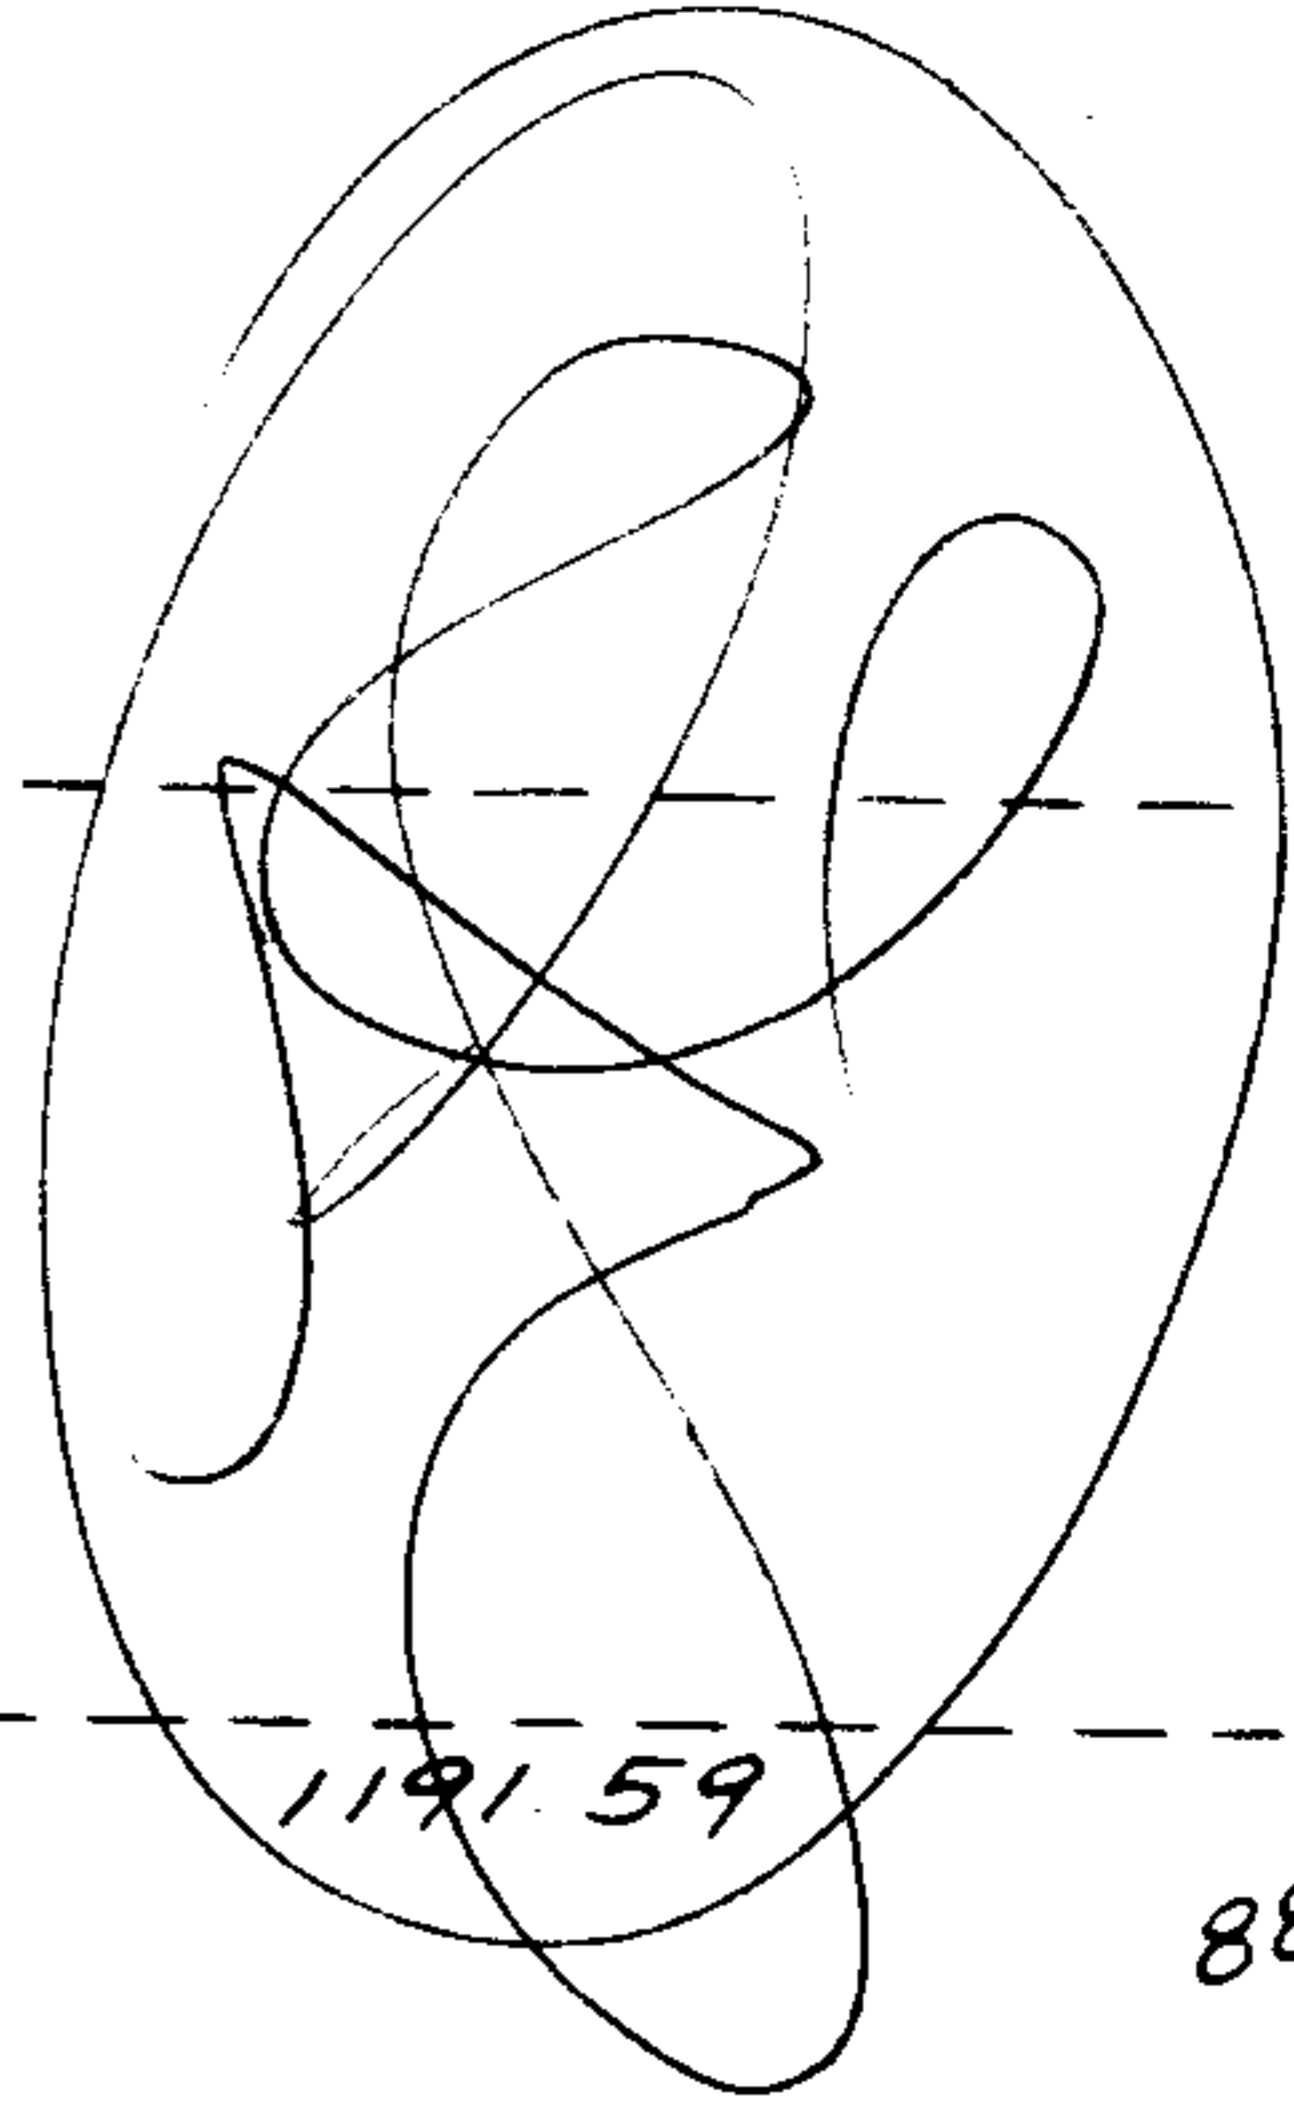

MAN 10 ENT'D

John L. L.

88°54'

1191.59

88°52'

903.84

96°10'

514.10

177°34'

645.95

88°30'

88°52'

978.90

88°30'

978.90

60

301