

5404

Measurement

- 001
29.75 A.

1306.8

1518

234.3 165

257.15
- 014
9.20 A

6.39 A

683.15
733.15
- 012
22.19 A

70

~~- 013~~
~~45.25 A.~~
- 015 ✓
36.05 A.

- 003
25.00 A.

- 004
34.00 A.

- 005
25.00 A.

LAW 1 RD.
(X)


DEC 29 ENT'D

7-28-86 L.H.

APPROVED
LORAIN CO
MAP DEPT.
DATE 11/16/71
15-4
BY R.J. Kelling

- 002
80.00 A

1036-636
Bus Well

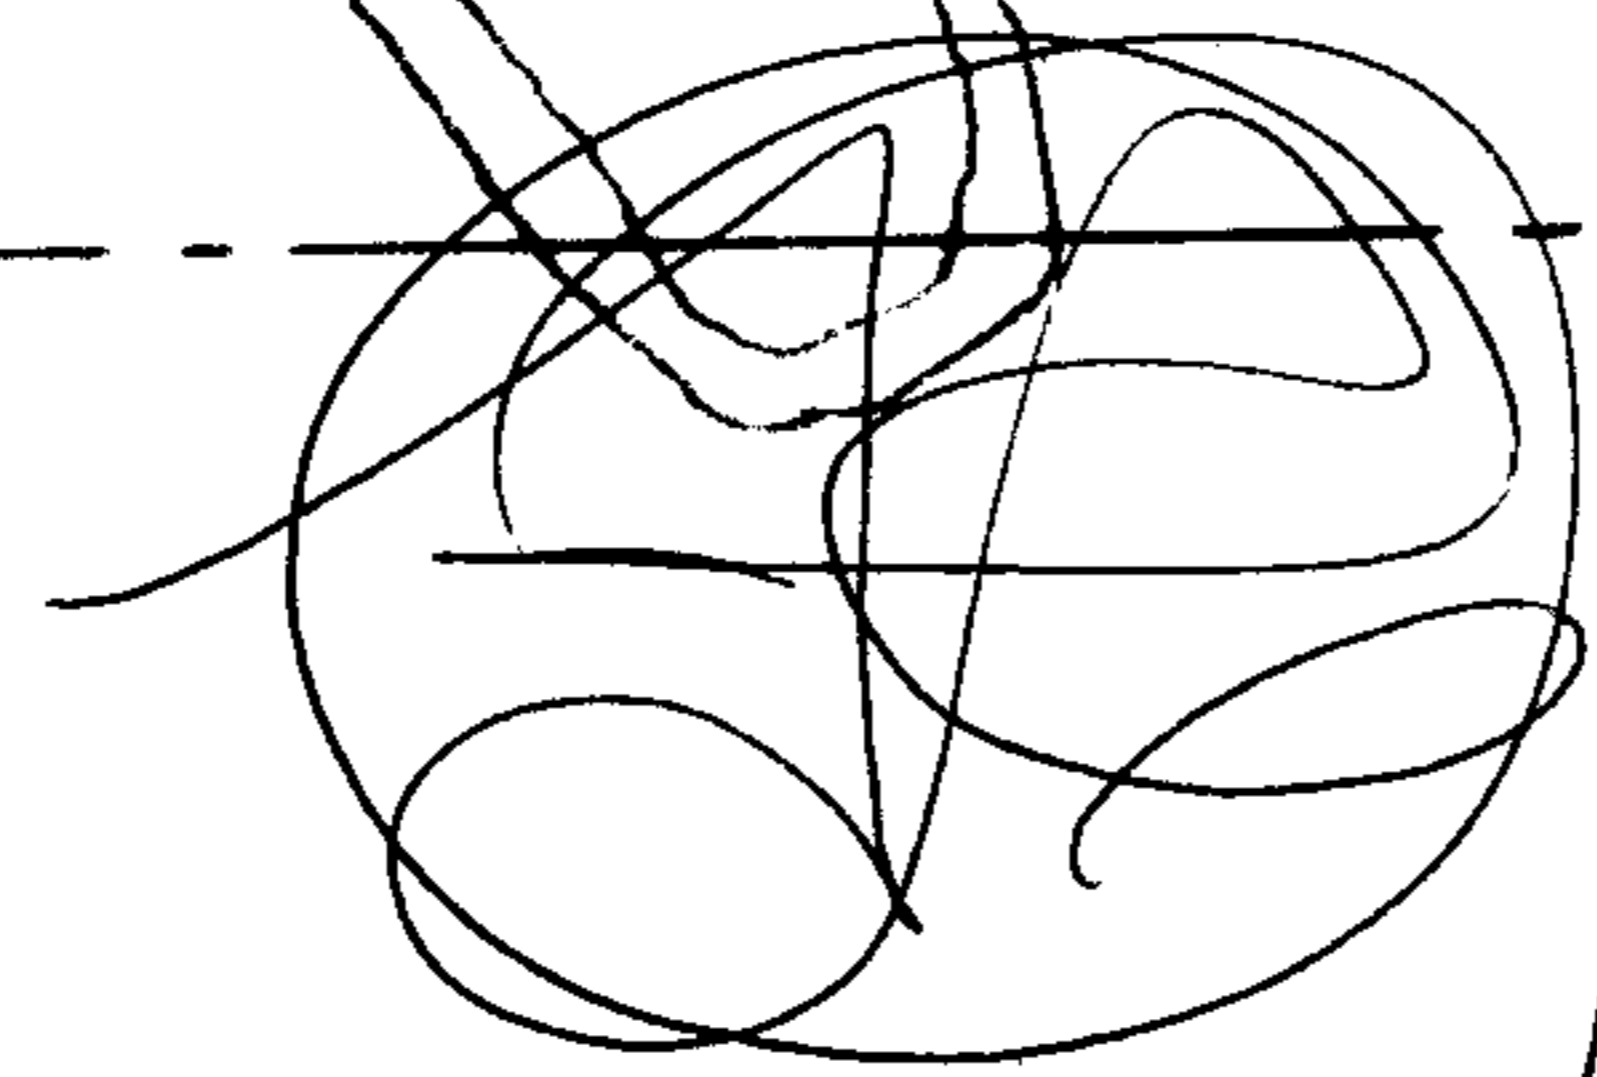

4719

cc/ map