



Pt. -003  
Pt. 91.13 A.

~~5416~~  
5413 ✓

SECS. -  
W. 1/2 18  
CARLISLE TWP.

101

-018  
34.34 A.

23 ELYRIA

2703.25

2705.63

-017  
37.71 A.

2702.90


-005  
26.97 A.

2700.62

LATTASBURG

89° 37'

-021  
~~OTC~~  
36.79 AC  
35.59

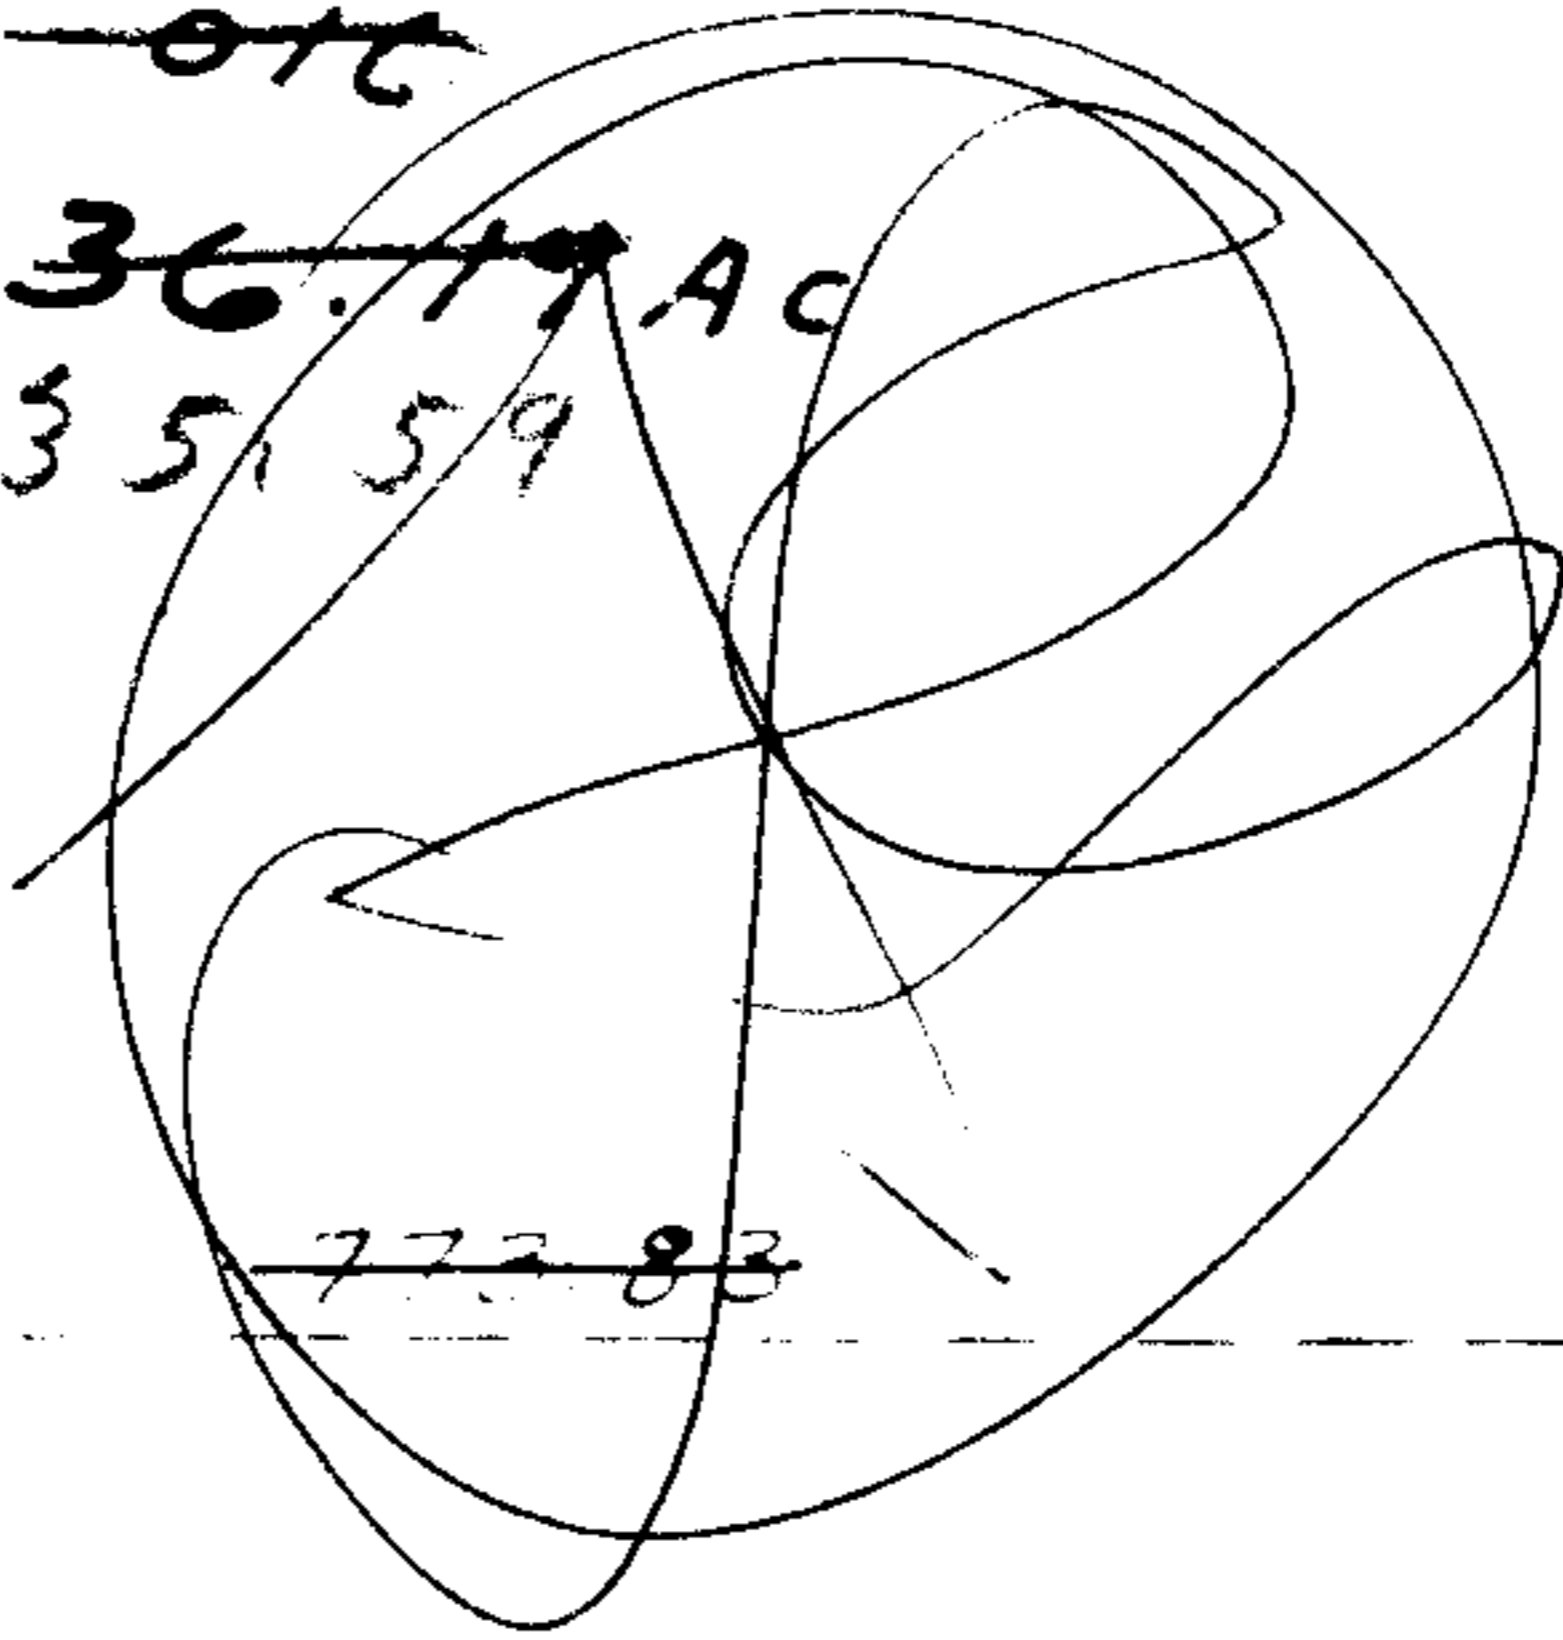

1505.83

1773.83  
268  
1505.83

2401.0

RD.

IAN BENTO  
~~5416~~  
5413  
APPROVED  
LORAIN CO.  
50.00 A.  
MAP DEPT.  
DATE 11/22/71  
10-F  
BY  
R. W. [Signature]

400  
268  
219  
9.4  
268  
268.60 A  
150° 43'

Copyright 1967