


5416

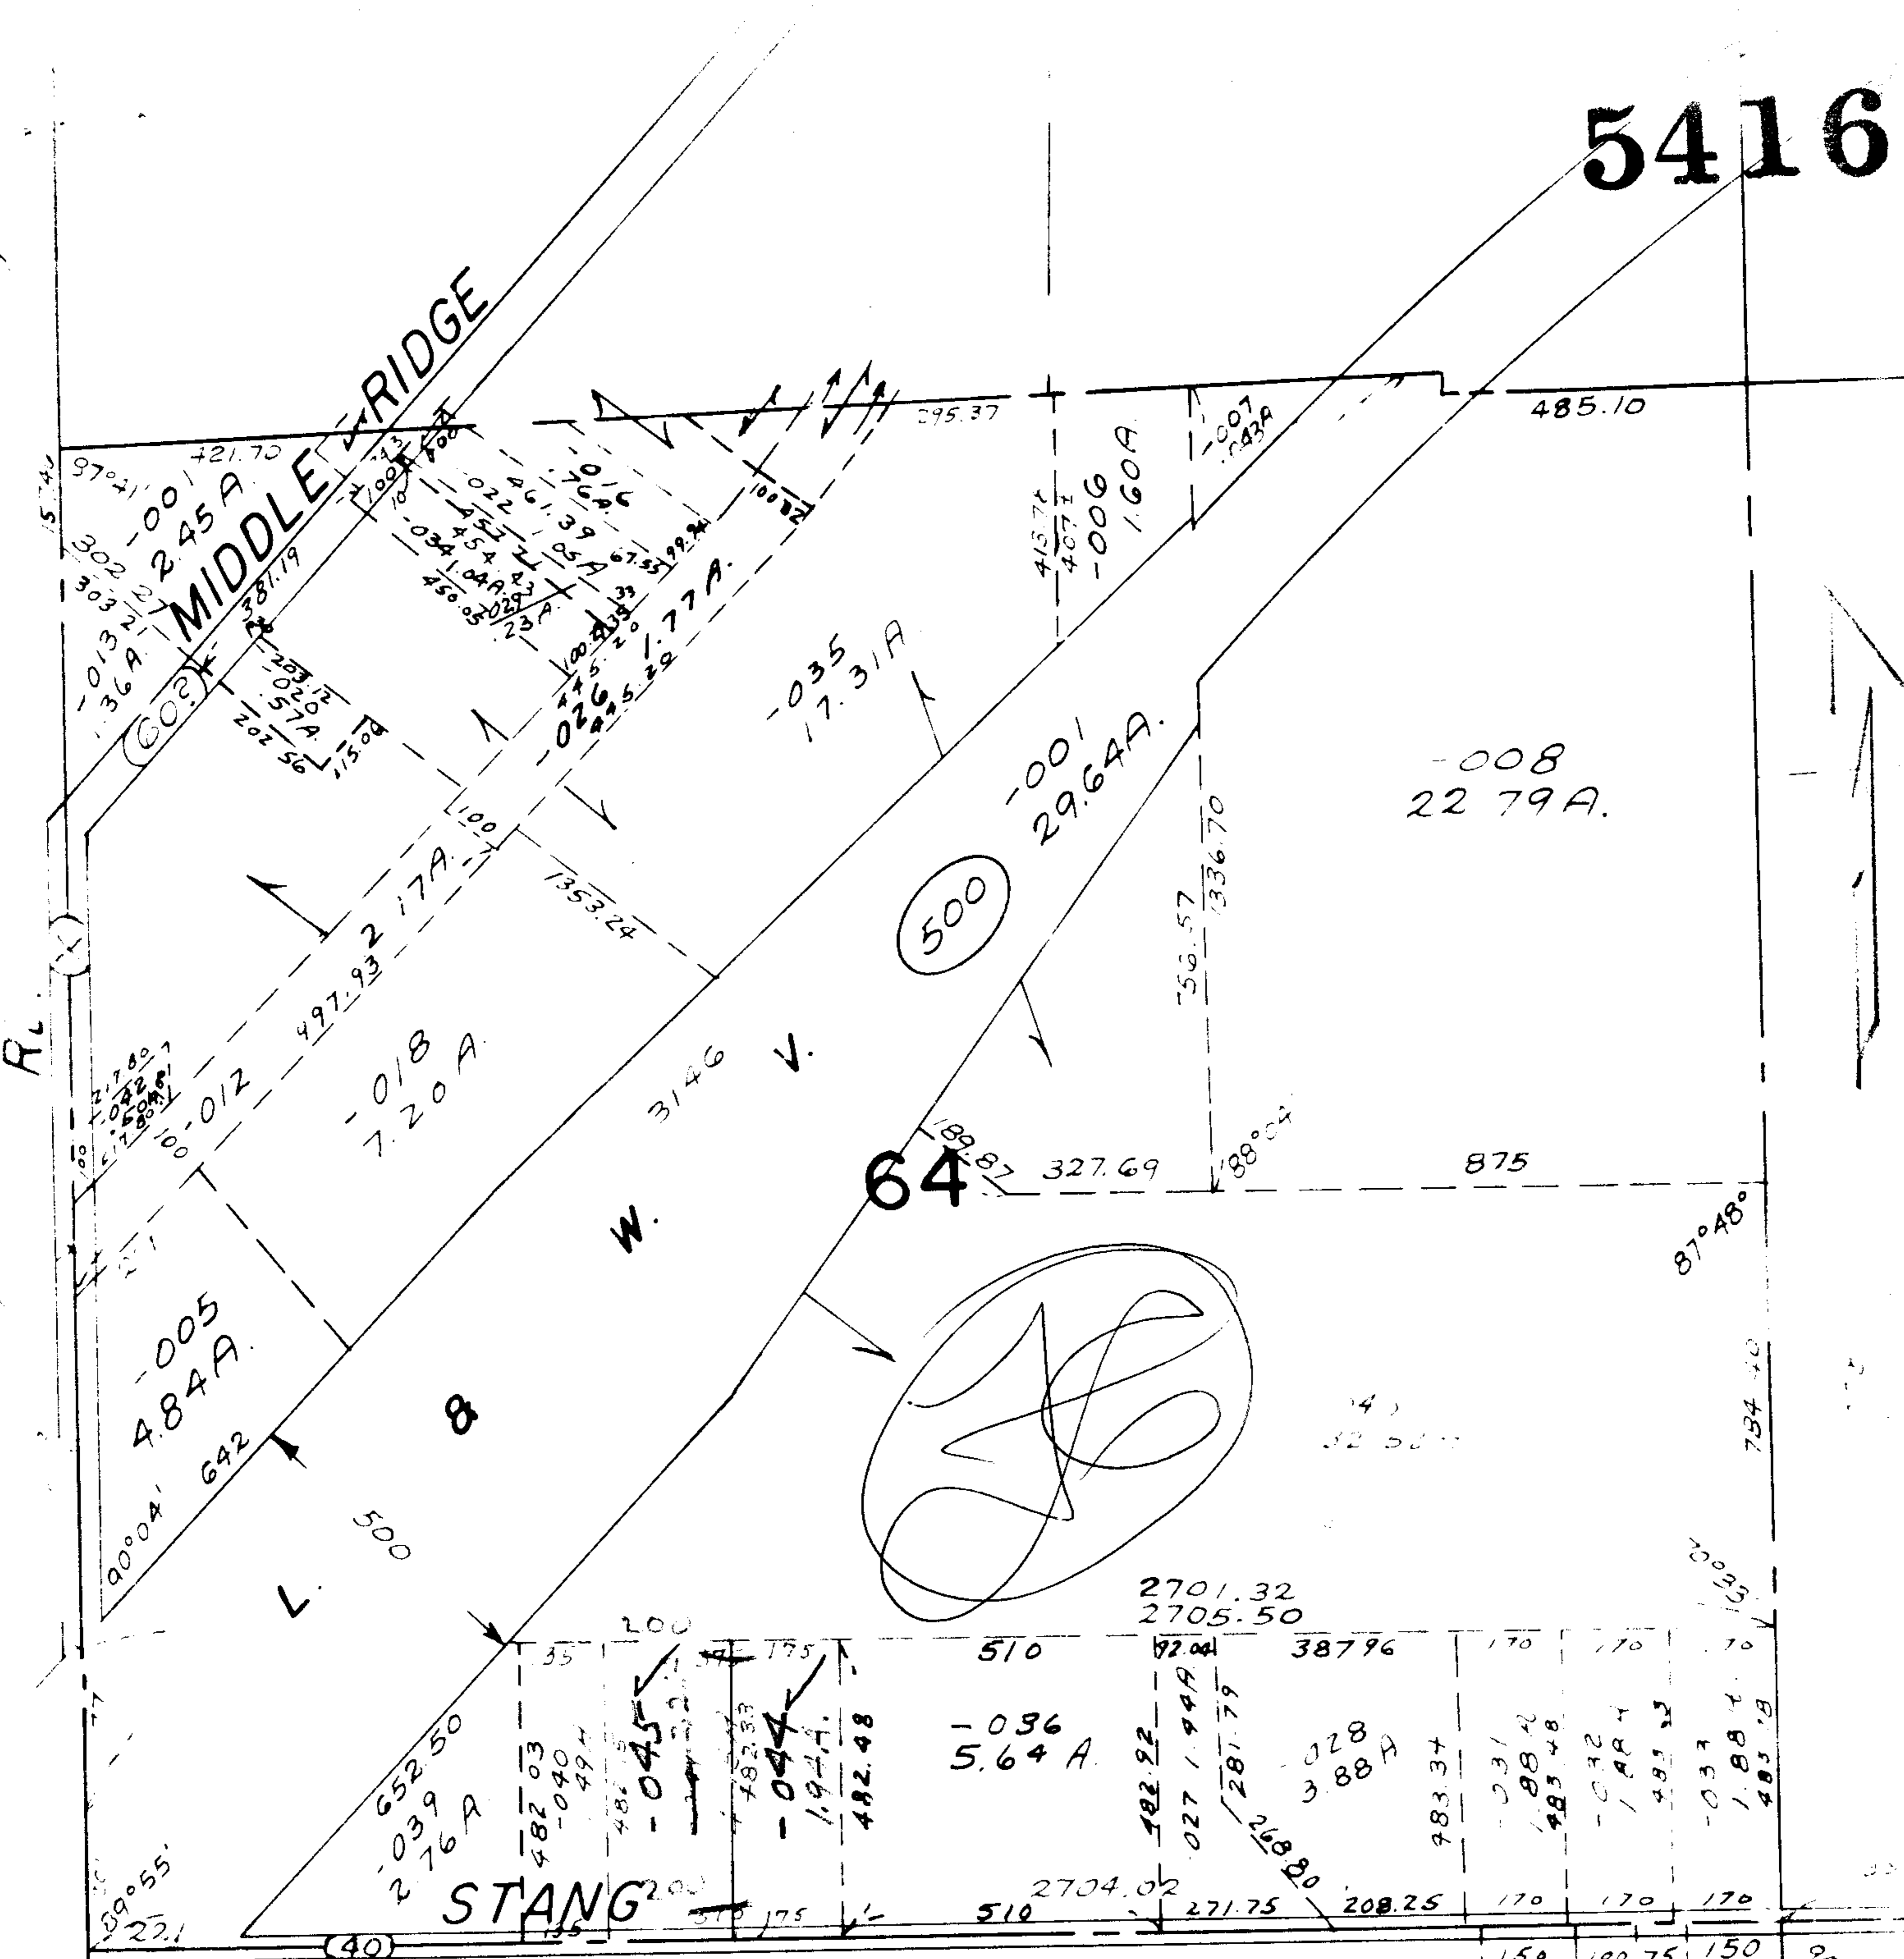

JAN 3 ENT'D

APPROVED  
 LORAIN CO.  
 MAP DEPT.  
 DATE 1/22/11  
 5-D  
 BY R. V. Rebling

7.7  
98-81-L