


A.  
N  
JAN 3 1970

101

5421  
APPROVED  
LORAIN CO.  
MAP DEPT.  
DATE 1/23/71  
5-20-097A  
BY [Signature]

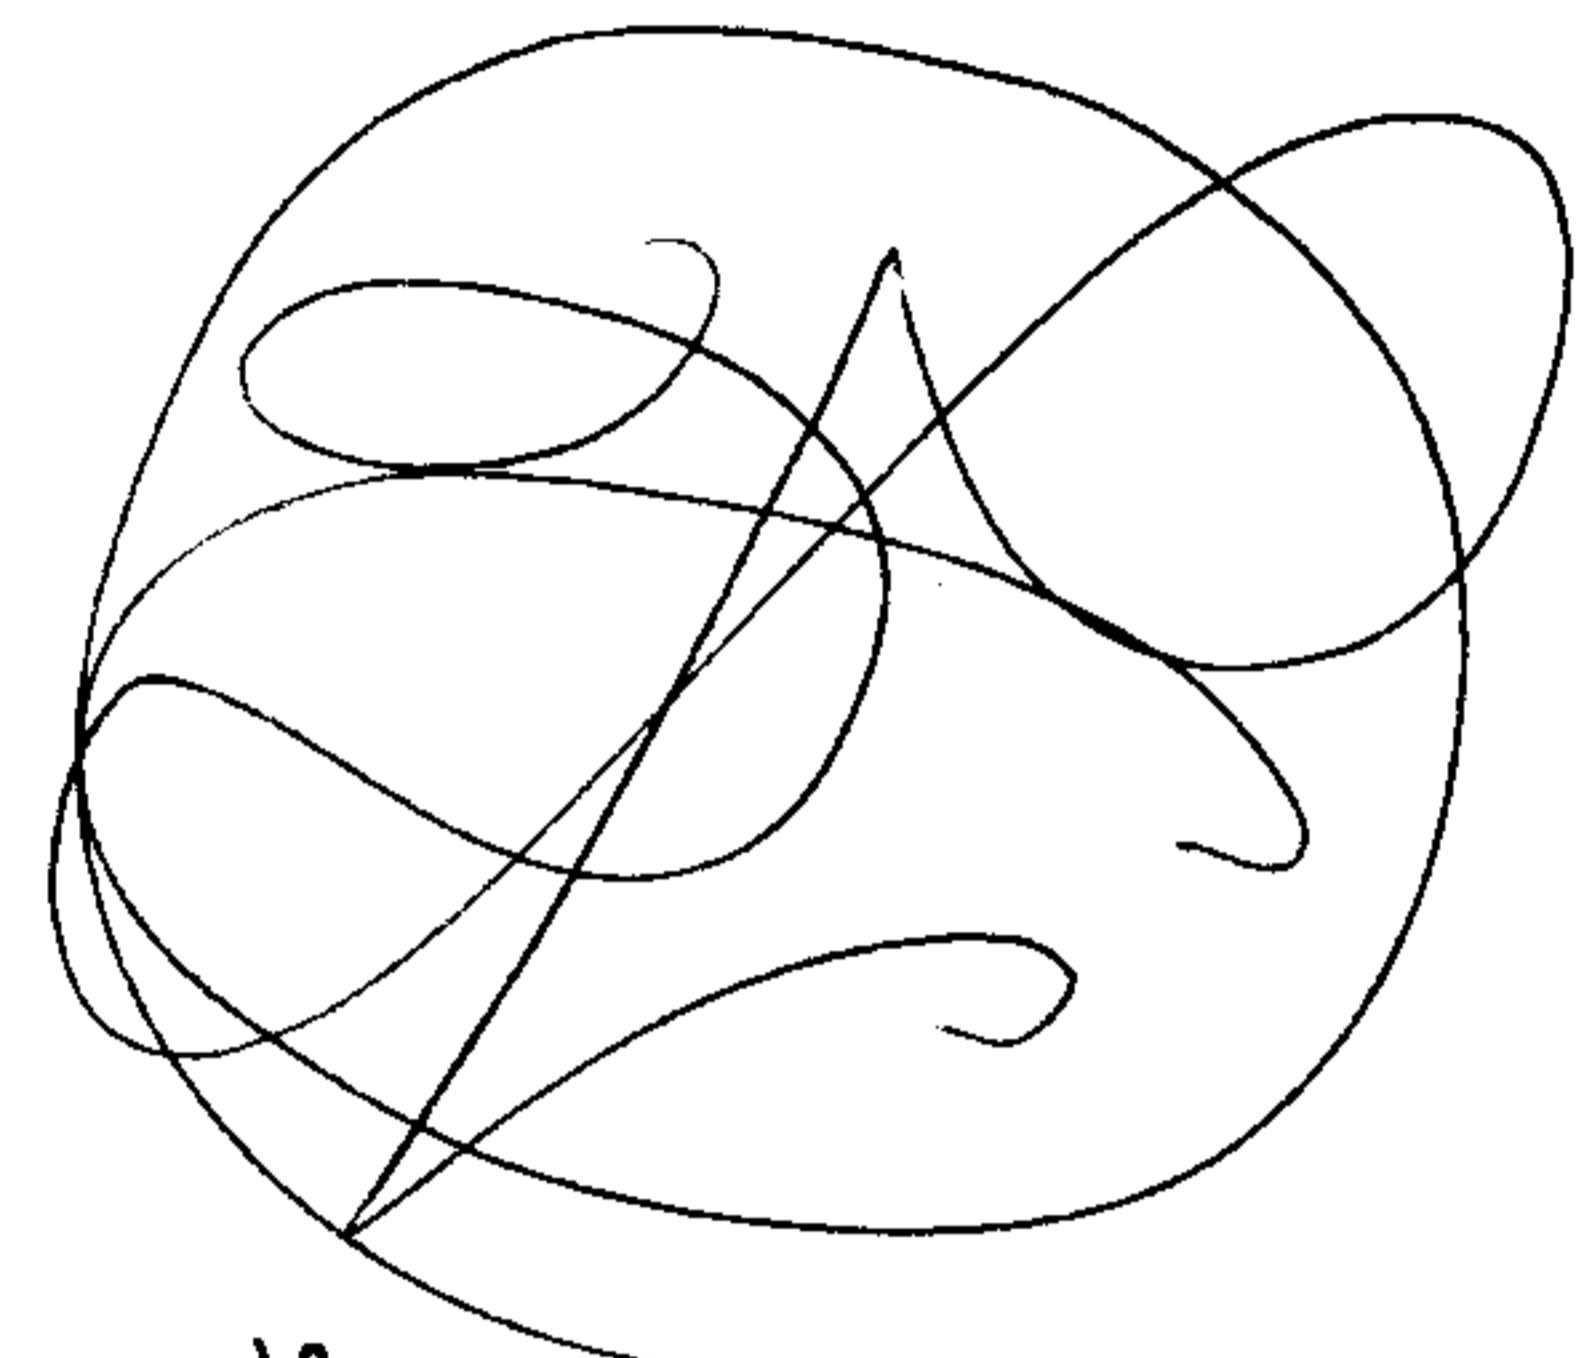

~~76.12~~  
~~60.37~~  
~~55.5~~

7-18-86  
L.L.

231.0  
246.82  
87°

125.4  
135°

-009  
0.70A  
435.87

-010  
0.73A  
454.75

-011  
1.02A  
419.63

-012  
1.07A

-013  
0.79A  
343.50

-014  
0.81A  
283.35

-018  
1.28A

-017  
0.55A  
SET

-016  
0.57A

-020  
0.58A

-004  
1.00A

001 CROSSING

RD.  
206.25

186.96  
19.72  
206.68

186.96  
19.72  
206.08

5421

SEE 5-5 EES

