


5432

APPROVED
LORAIN CO.
MAP DEPT.
DATE 11/26/71
300-112-A
BY R. V. Kelling

DEC 29 ENTD

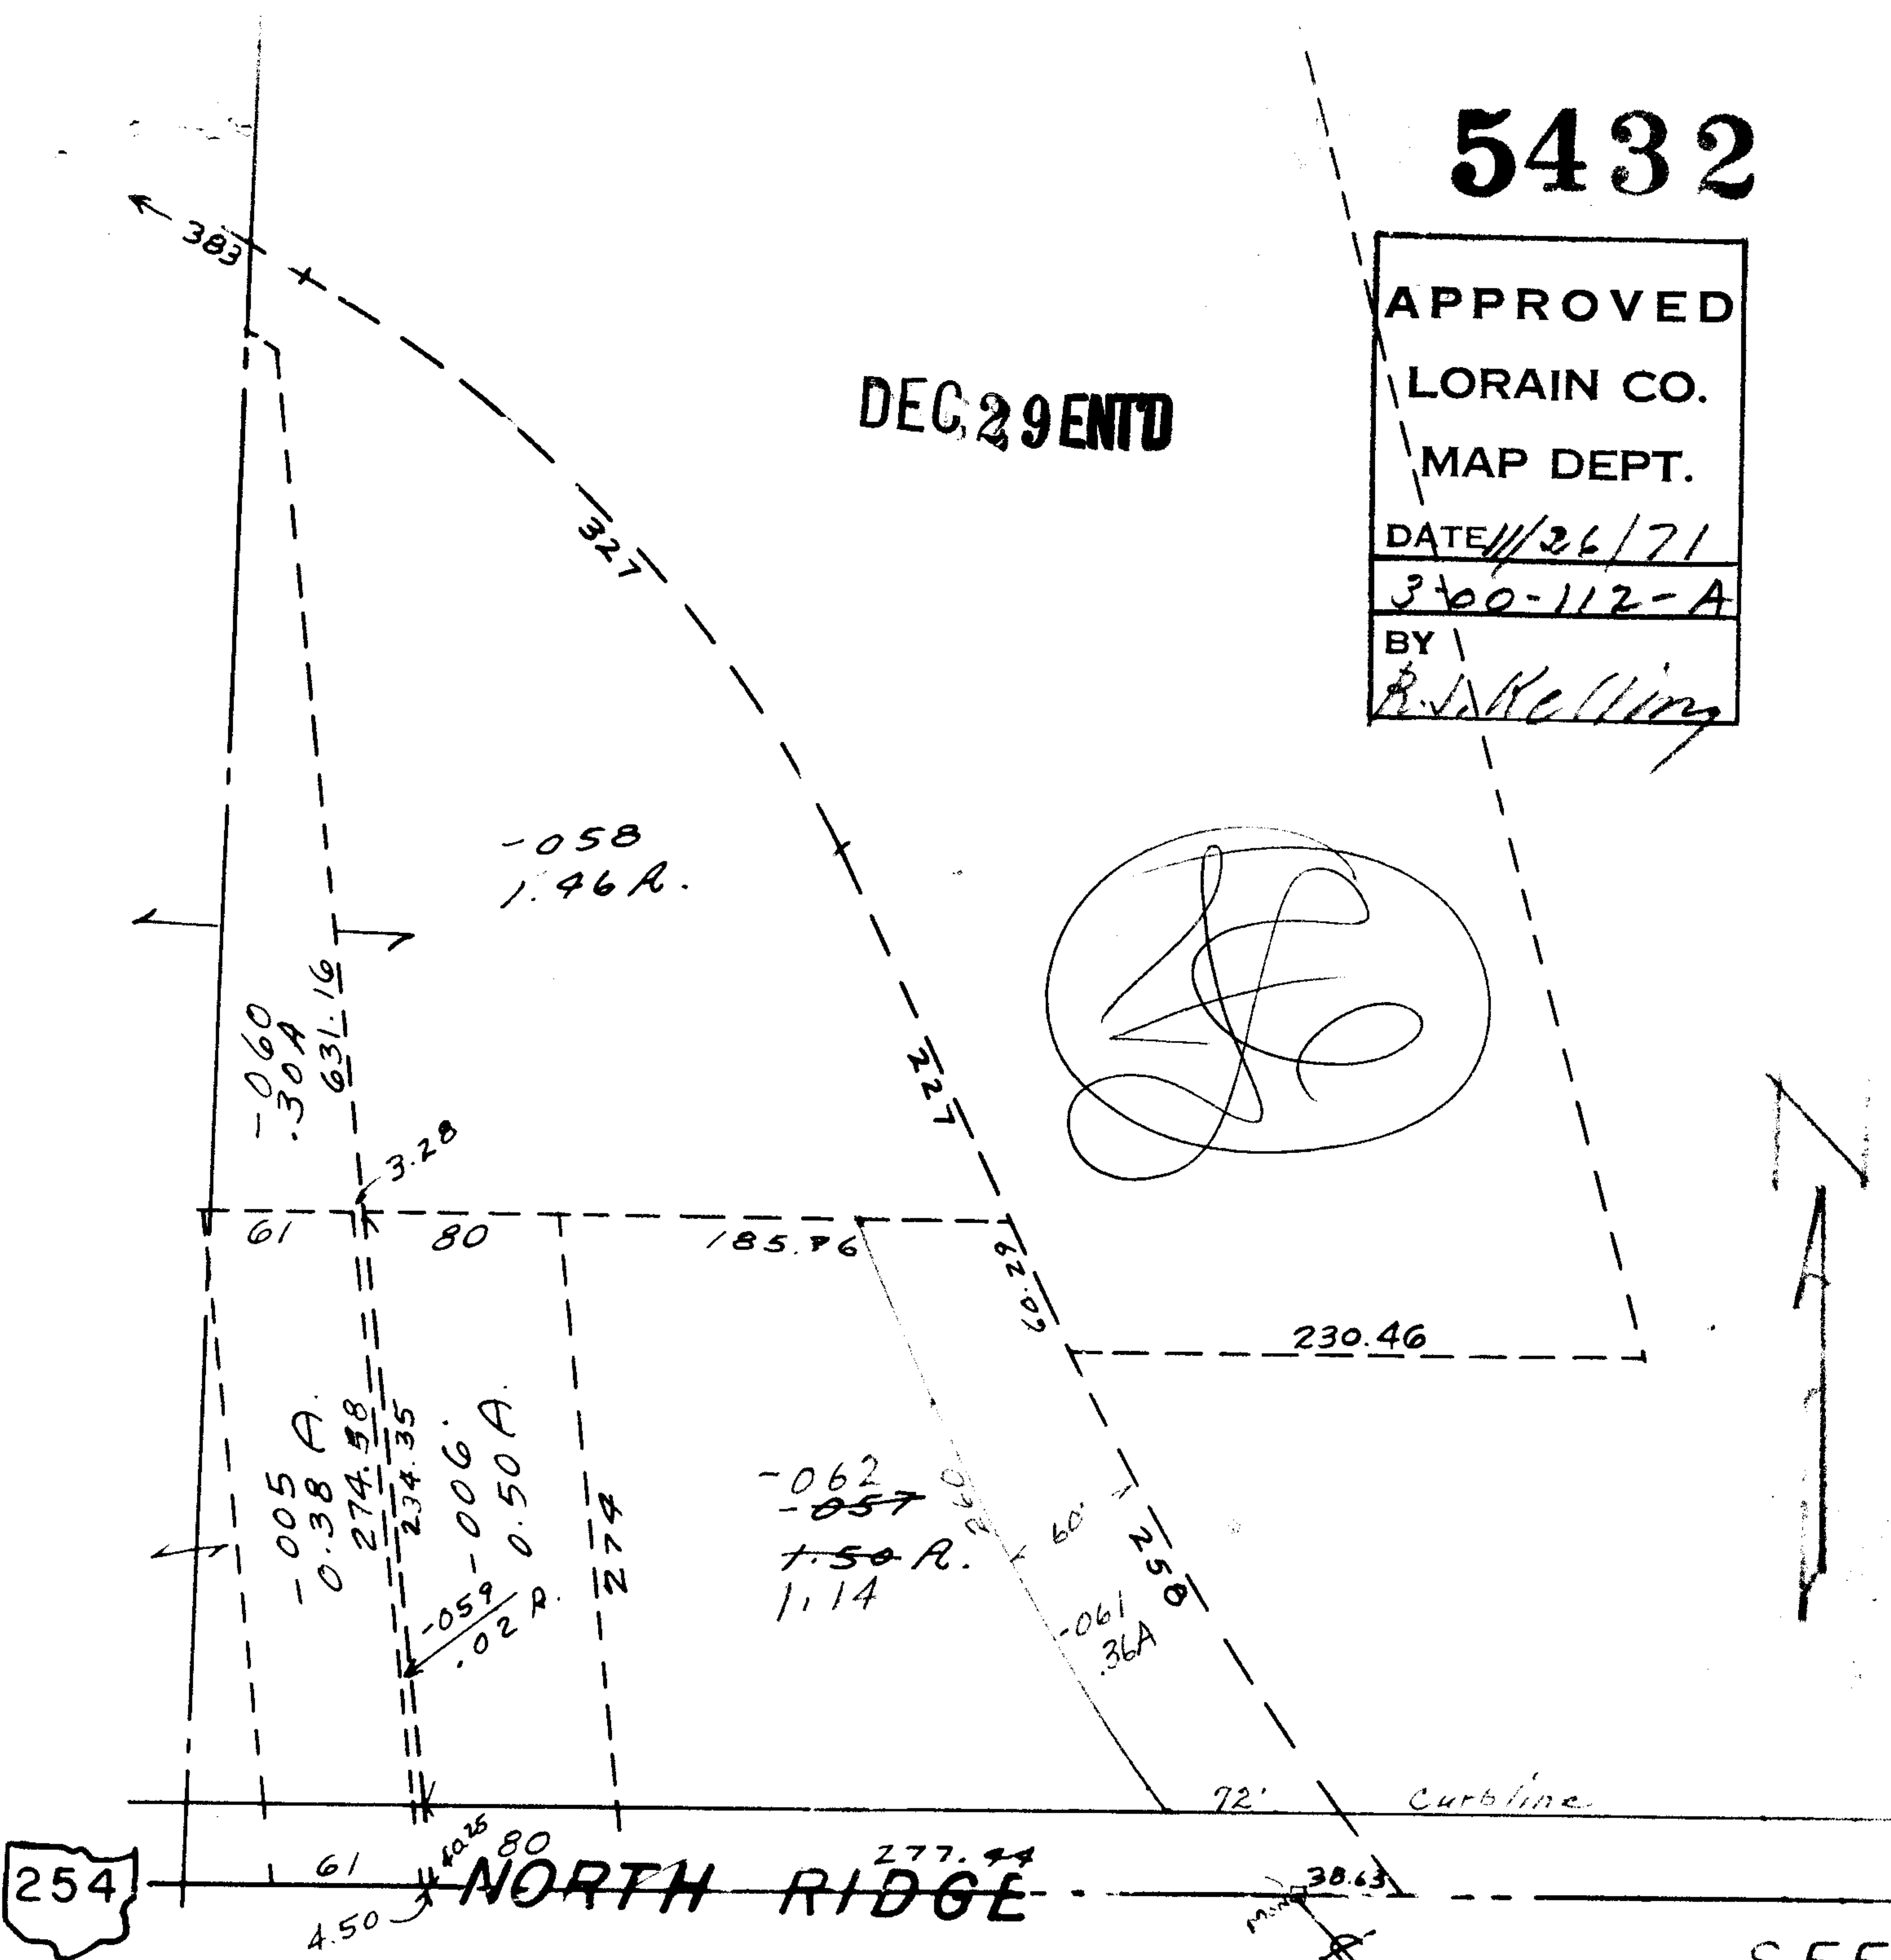

SEE

This split shown on map made Nov 13 1967
 Note This Parcel not on map since 11-13-67
 D.V. 735 - 721
 Error Made By and Title Sec To #4-11-13 71

SHEFFIELD TWP.

SCALE: 1" = 100'