


5436

038-B

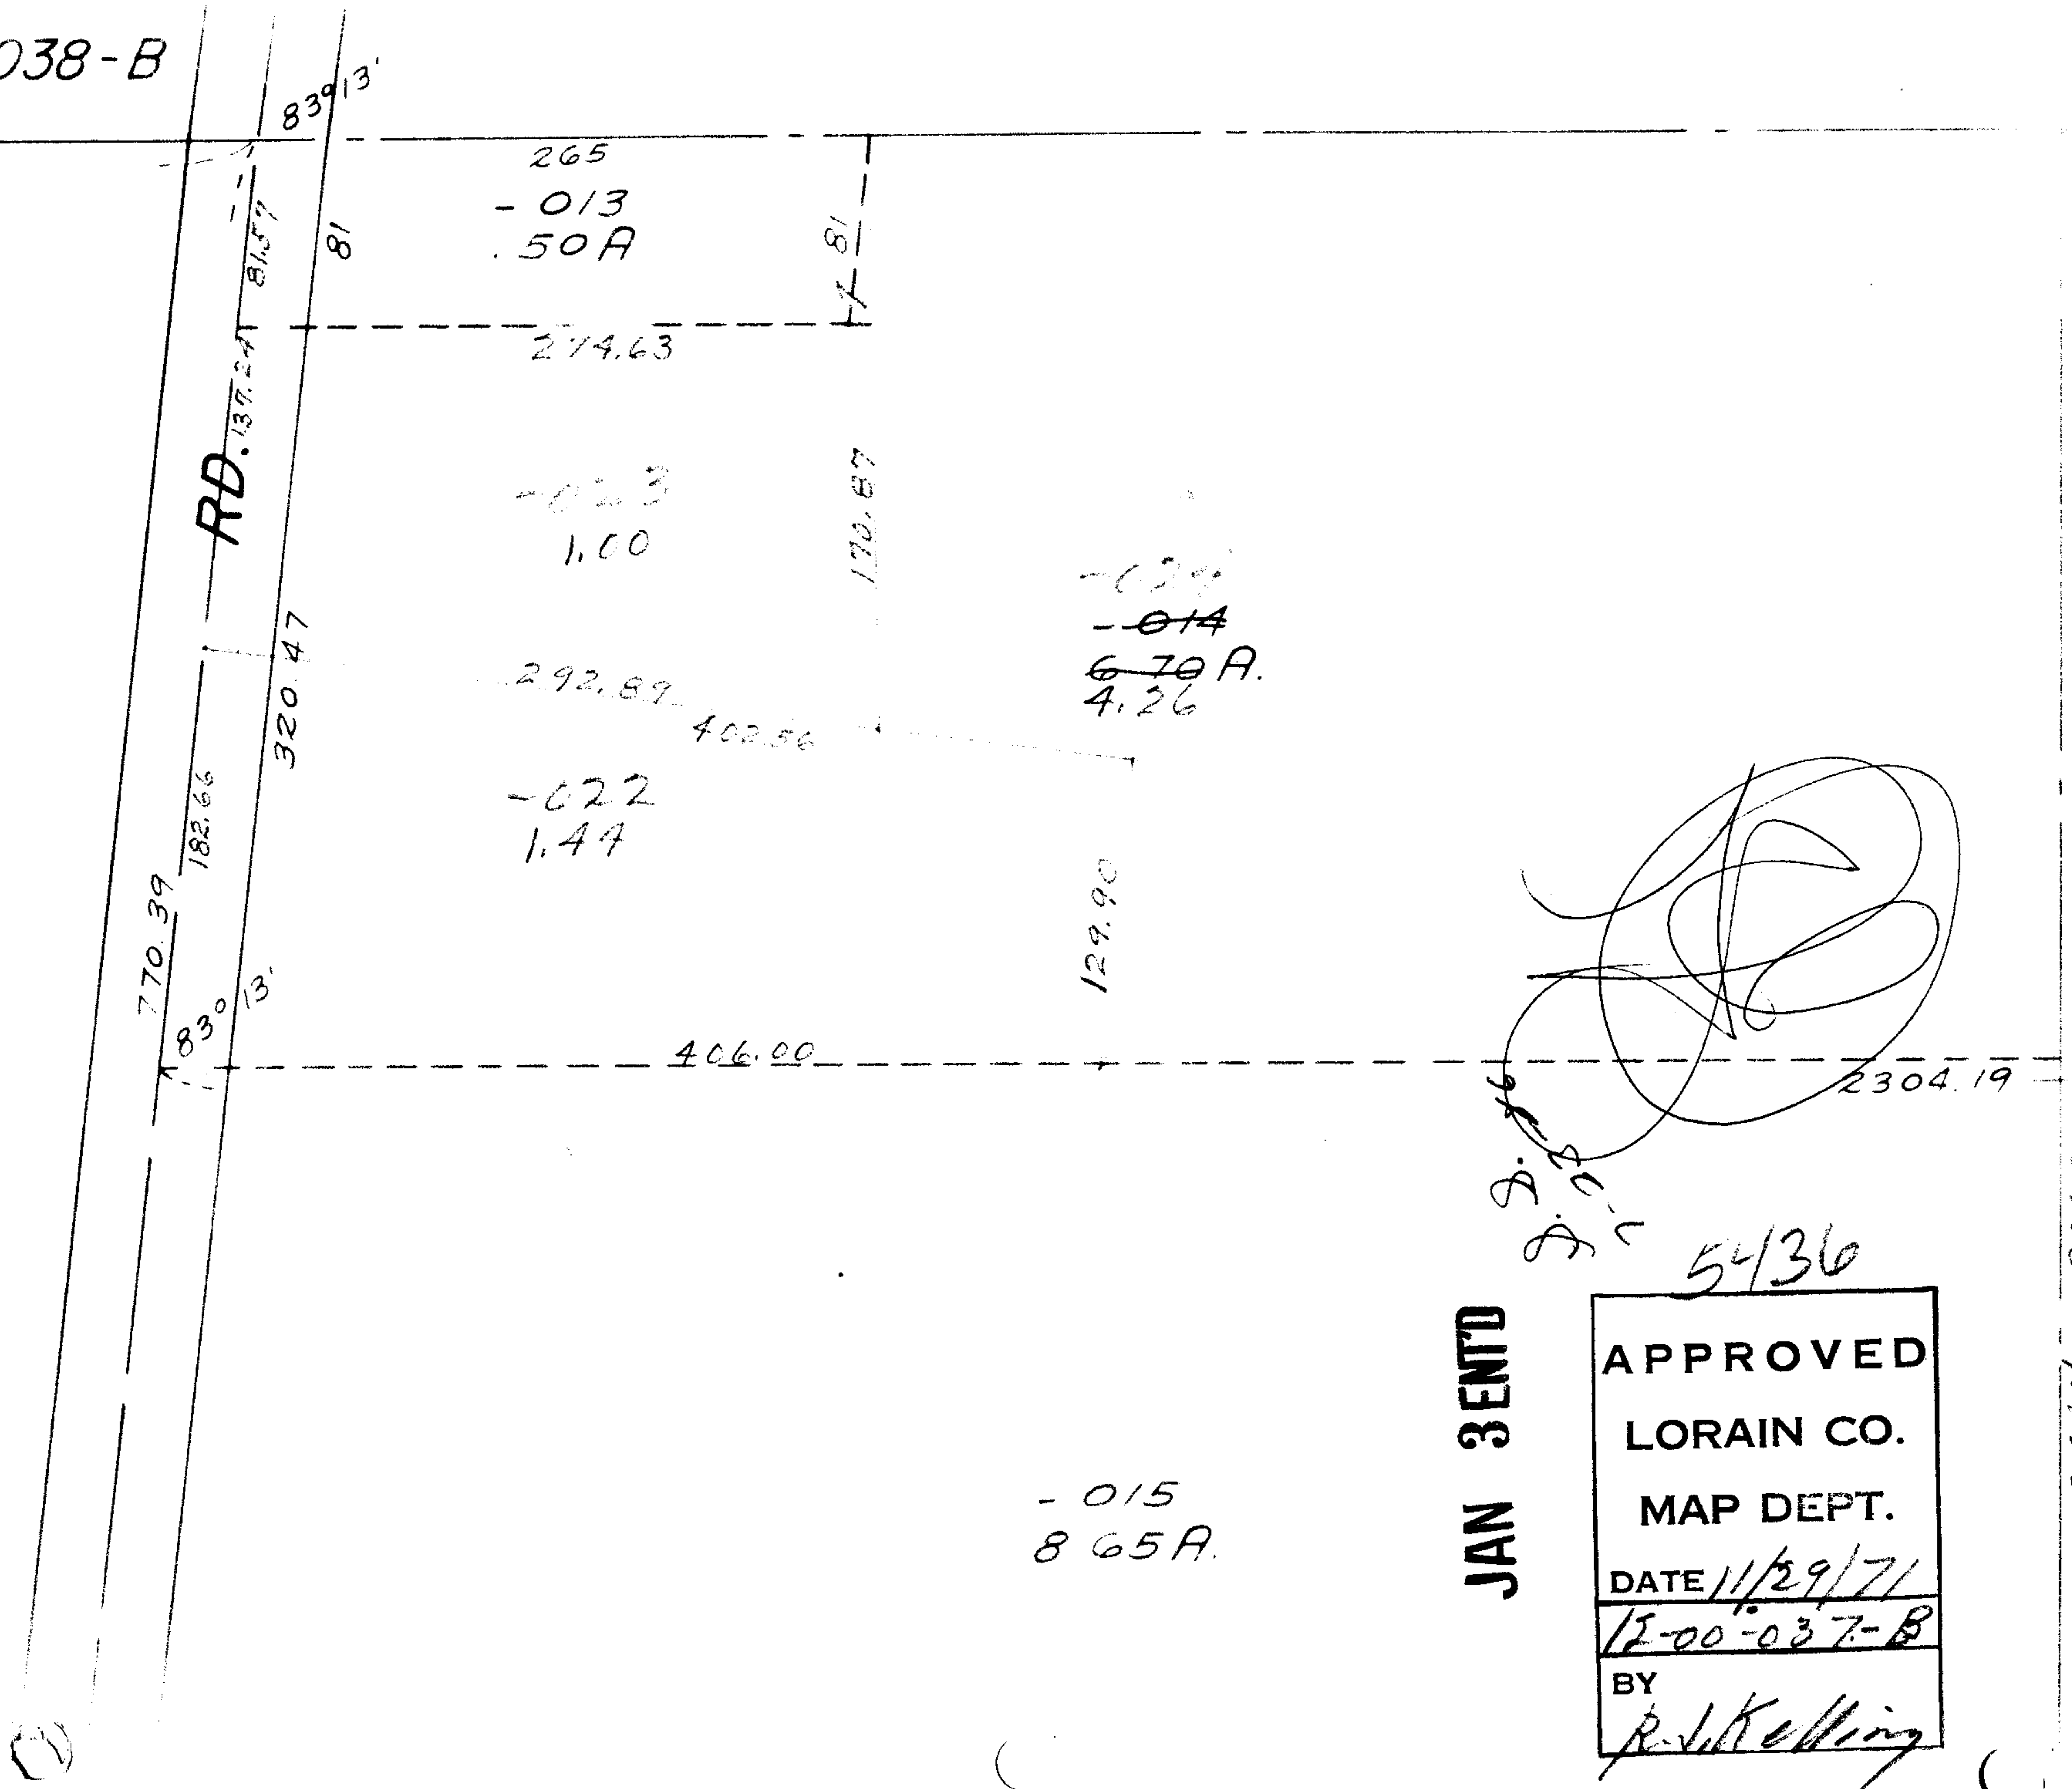

JAN 3 1971

APPROVED
LORAIN CO.
MAP DEPT.

DATE 11/29/71

12-00-037-B

BY

R. J. Kelling

5436

12.64chs = 834

