


5439

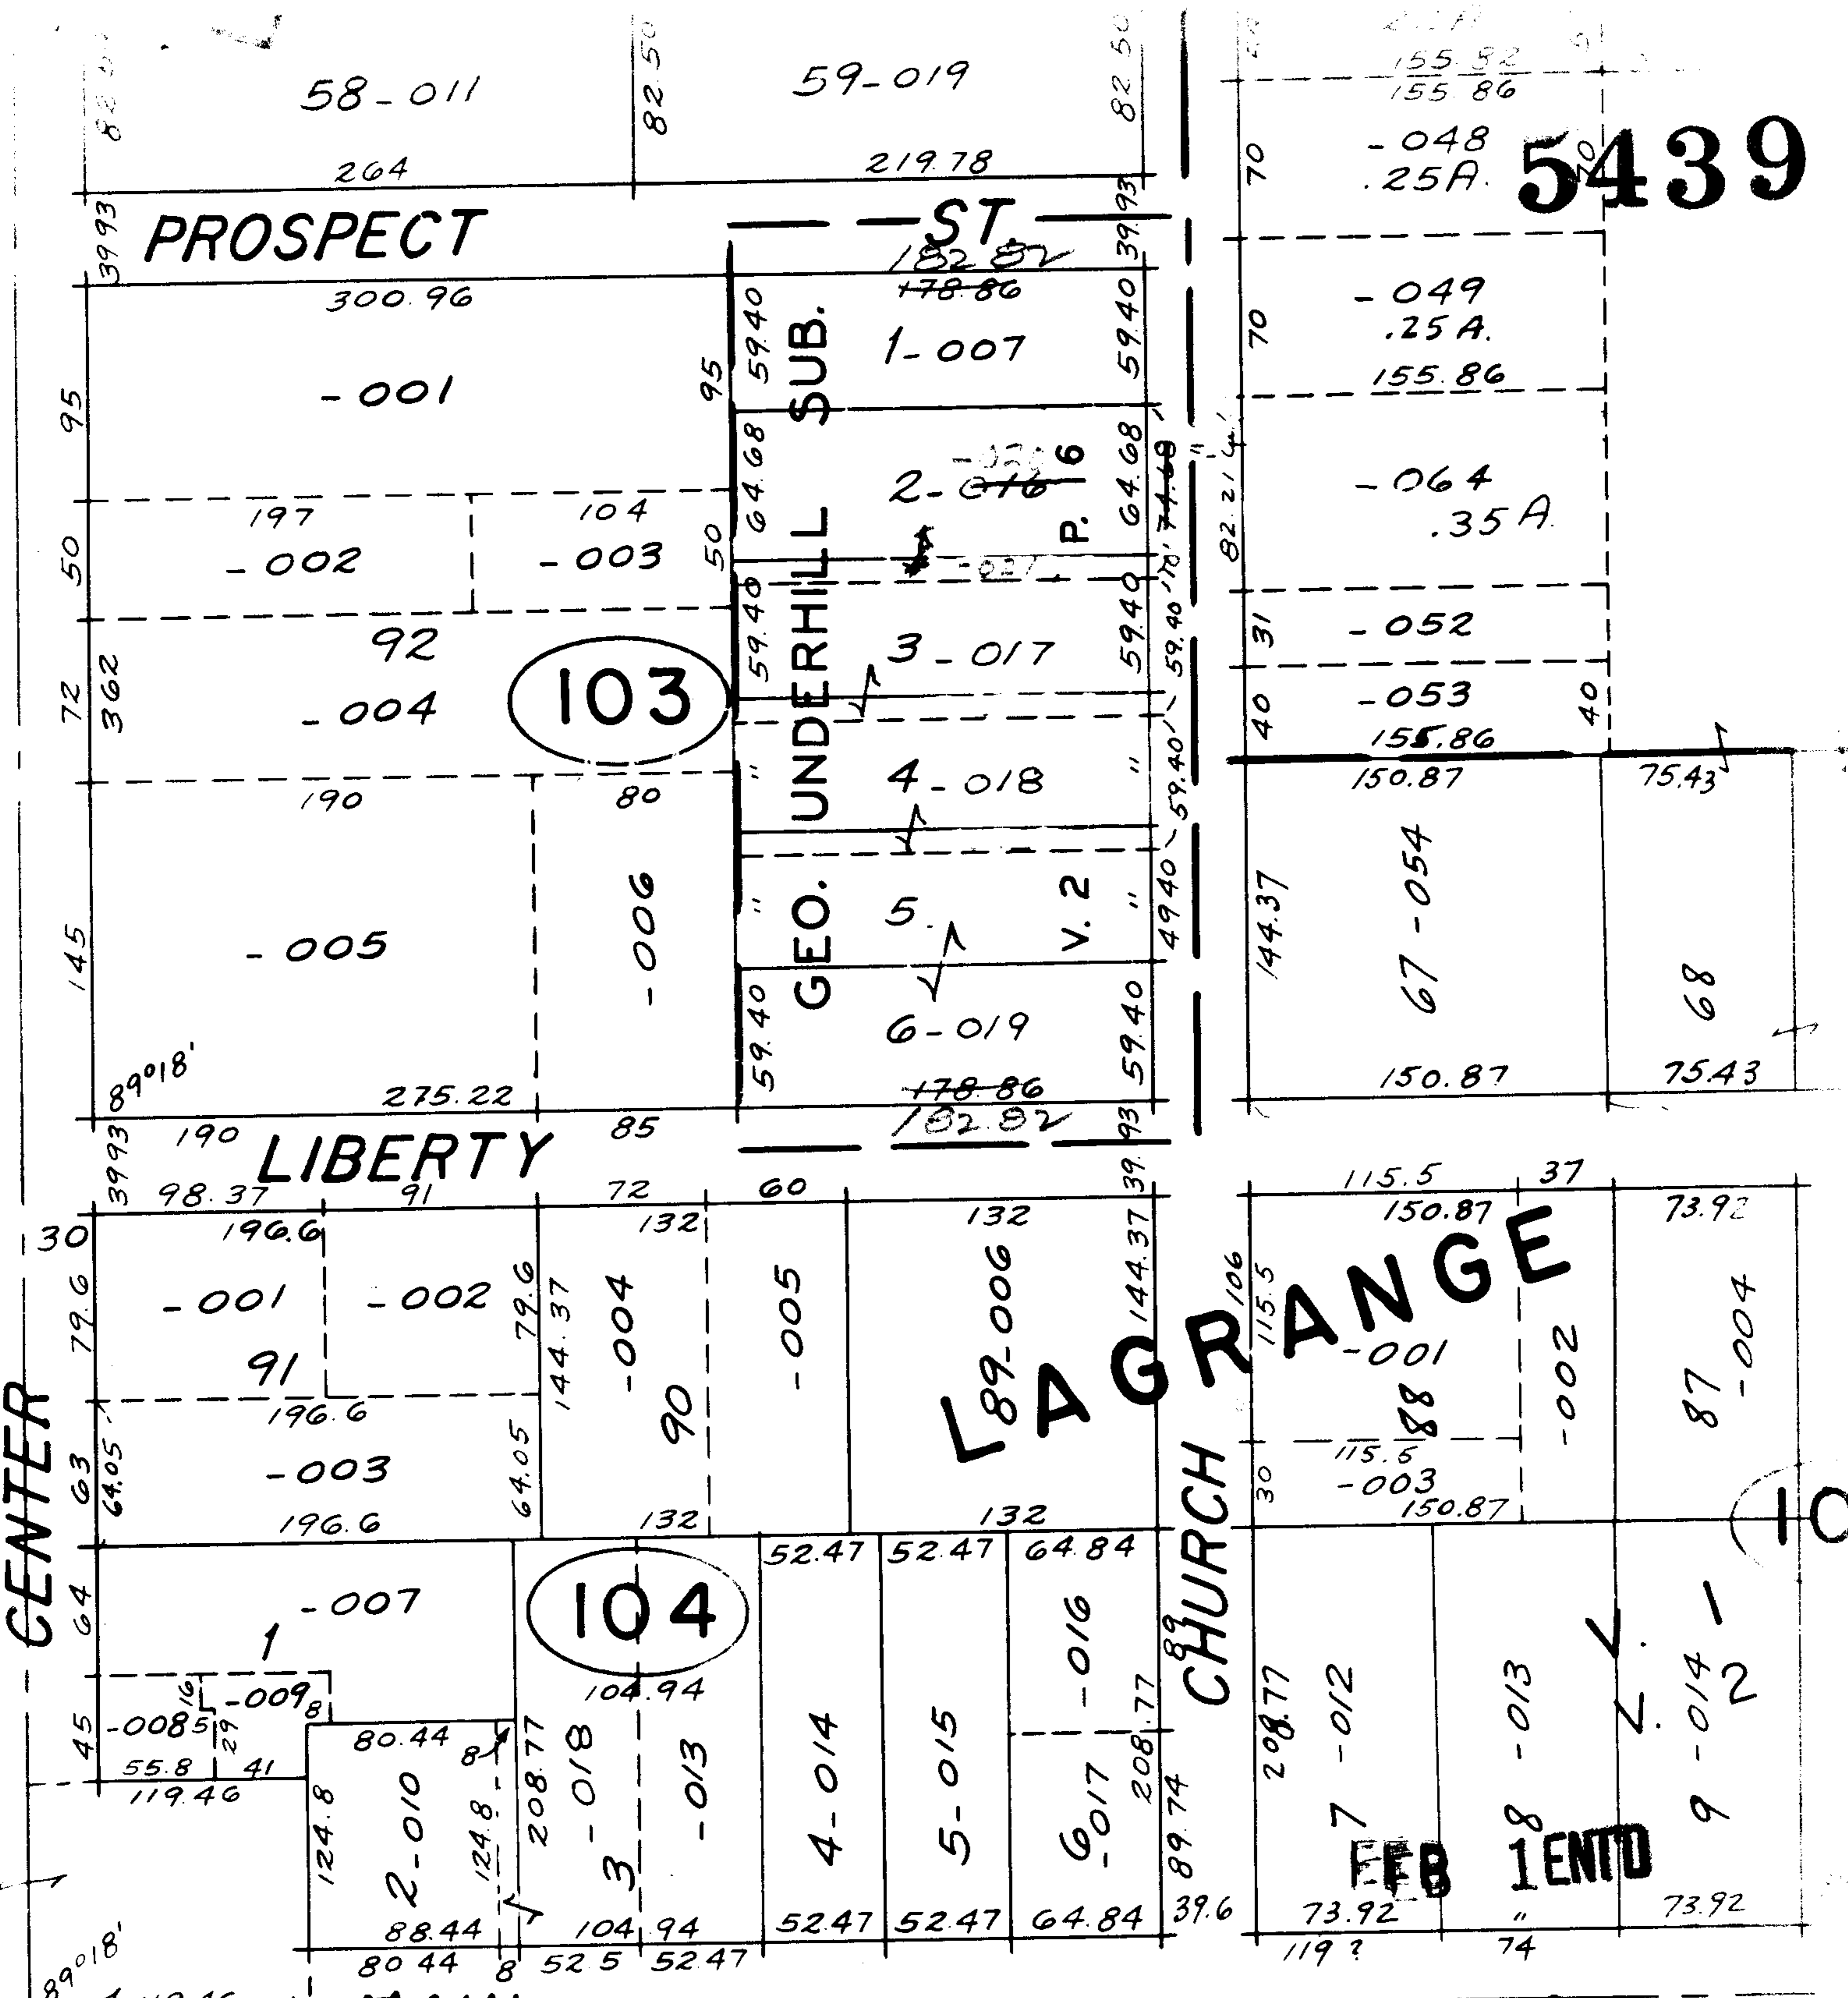

Note Correction 104 Dept  
 Geo Underhill Sub  
 Change 178.84 To 182.82  
 See Plat Vol 2 - Pg 14

# LAGRANGE TWP.

SCALE 1" = 100'

7-28-86

APPROVED 15-  
 LORAIN CO.  
 MAP DEPT.  
 DATE 11/30/71  
 15-00-033-A  
 BY  
 R. McHenry