

07-00-014-105-015

5441




~~847A~~ -027
6.124

-026
2.35A ✓

-001
~~4.38A~~
2.47 ✓
SUF.

-002
0.91A

10A

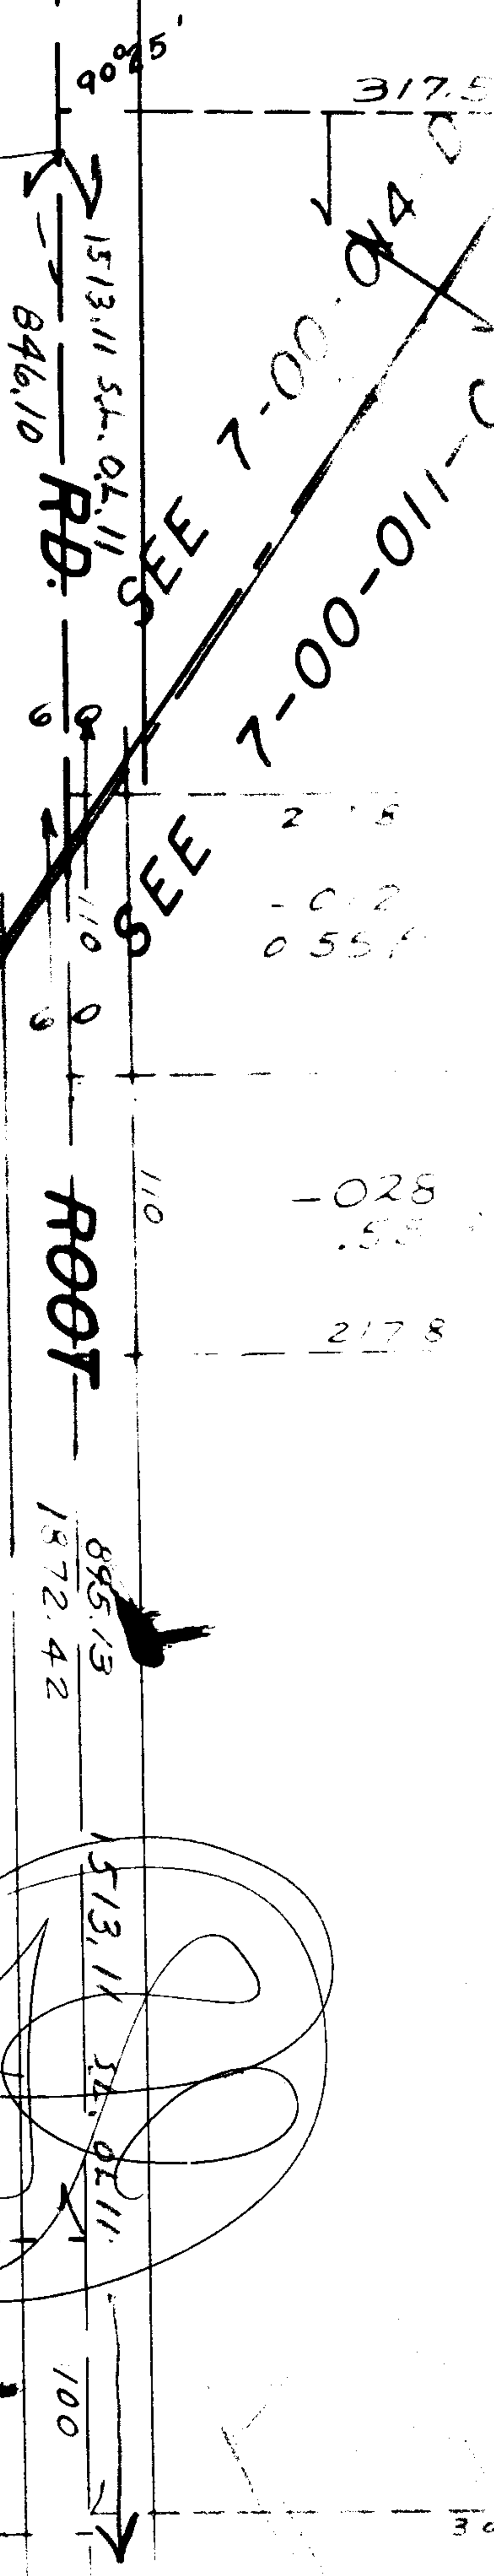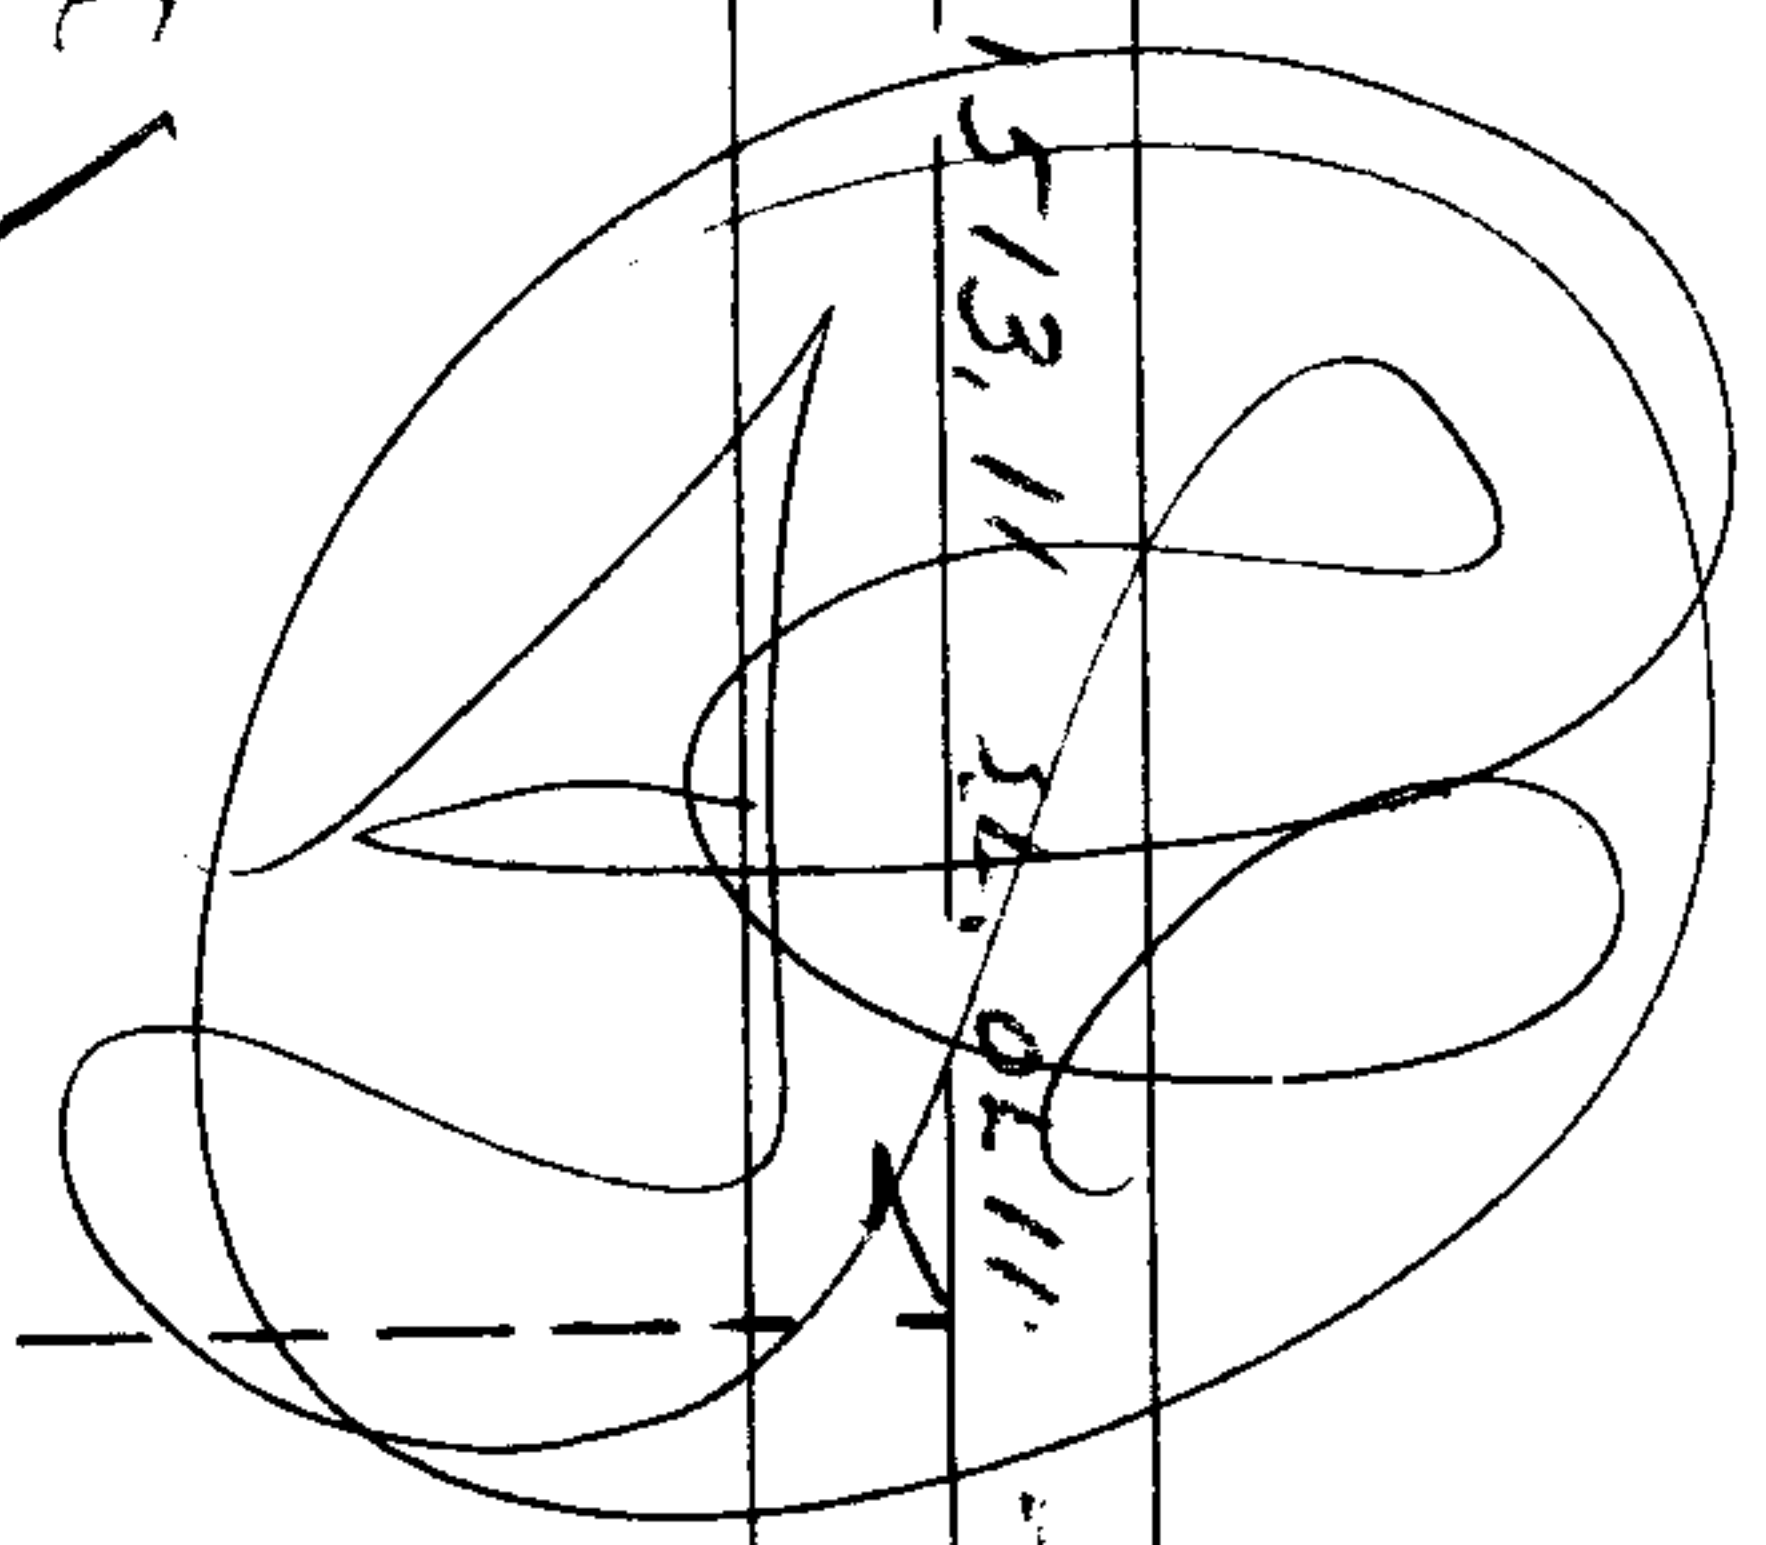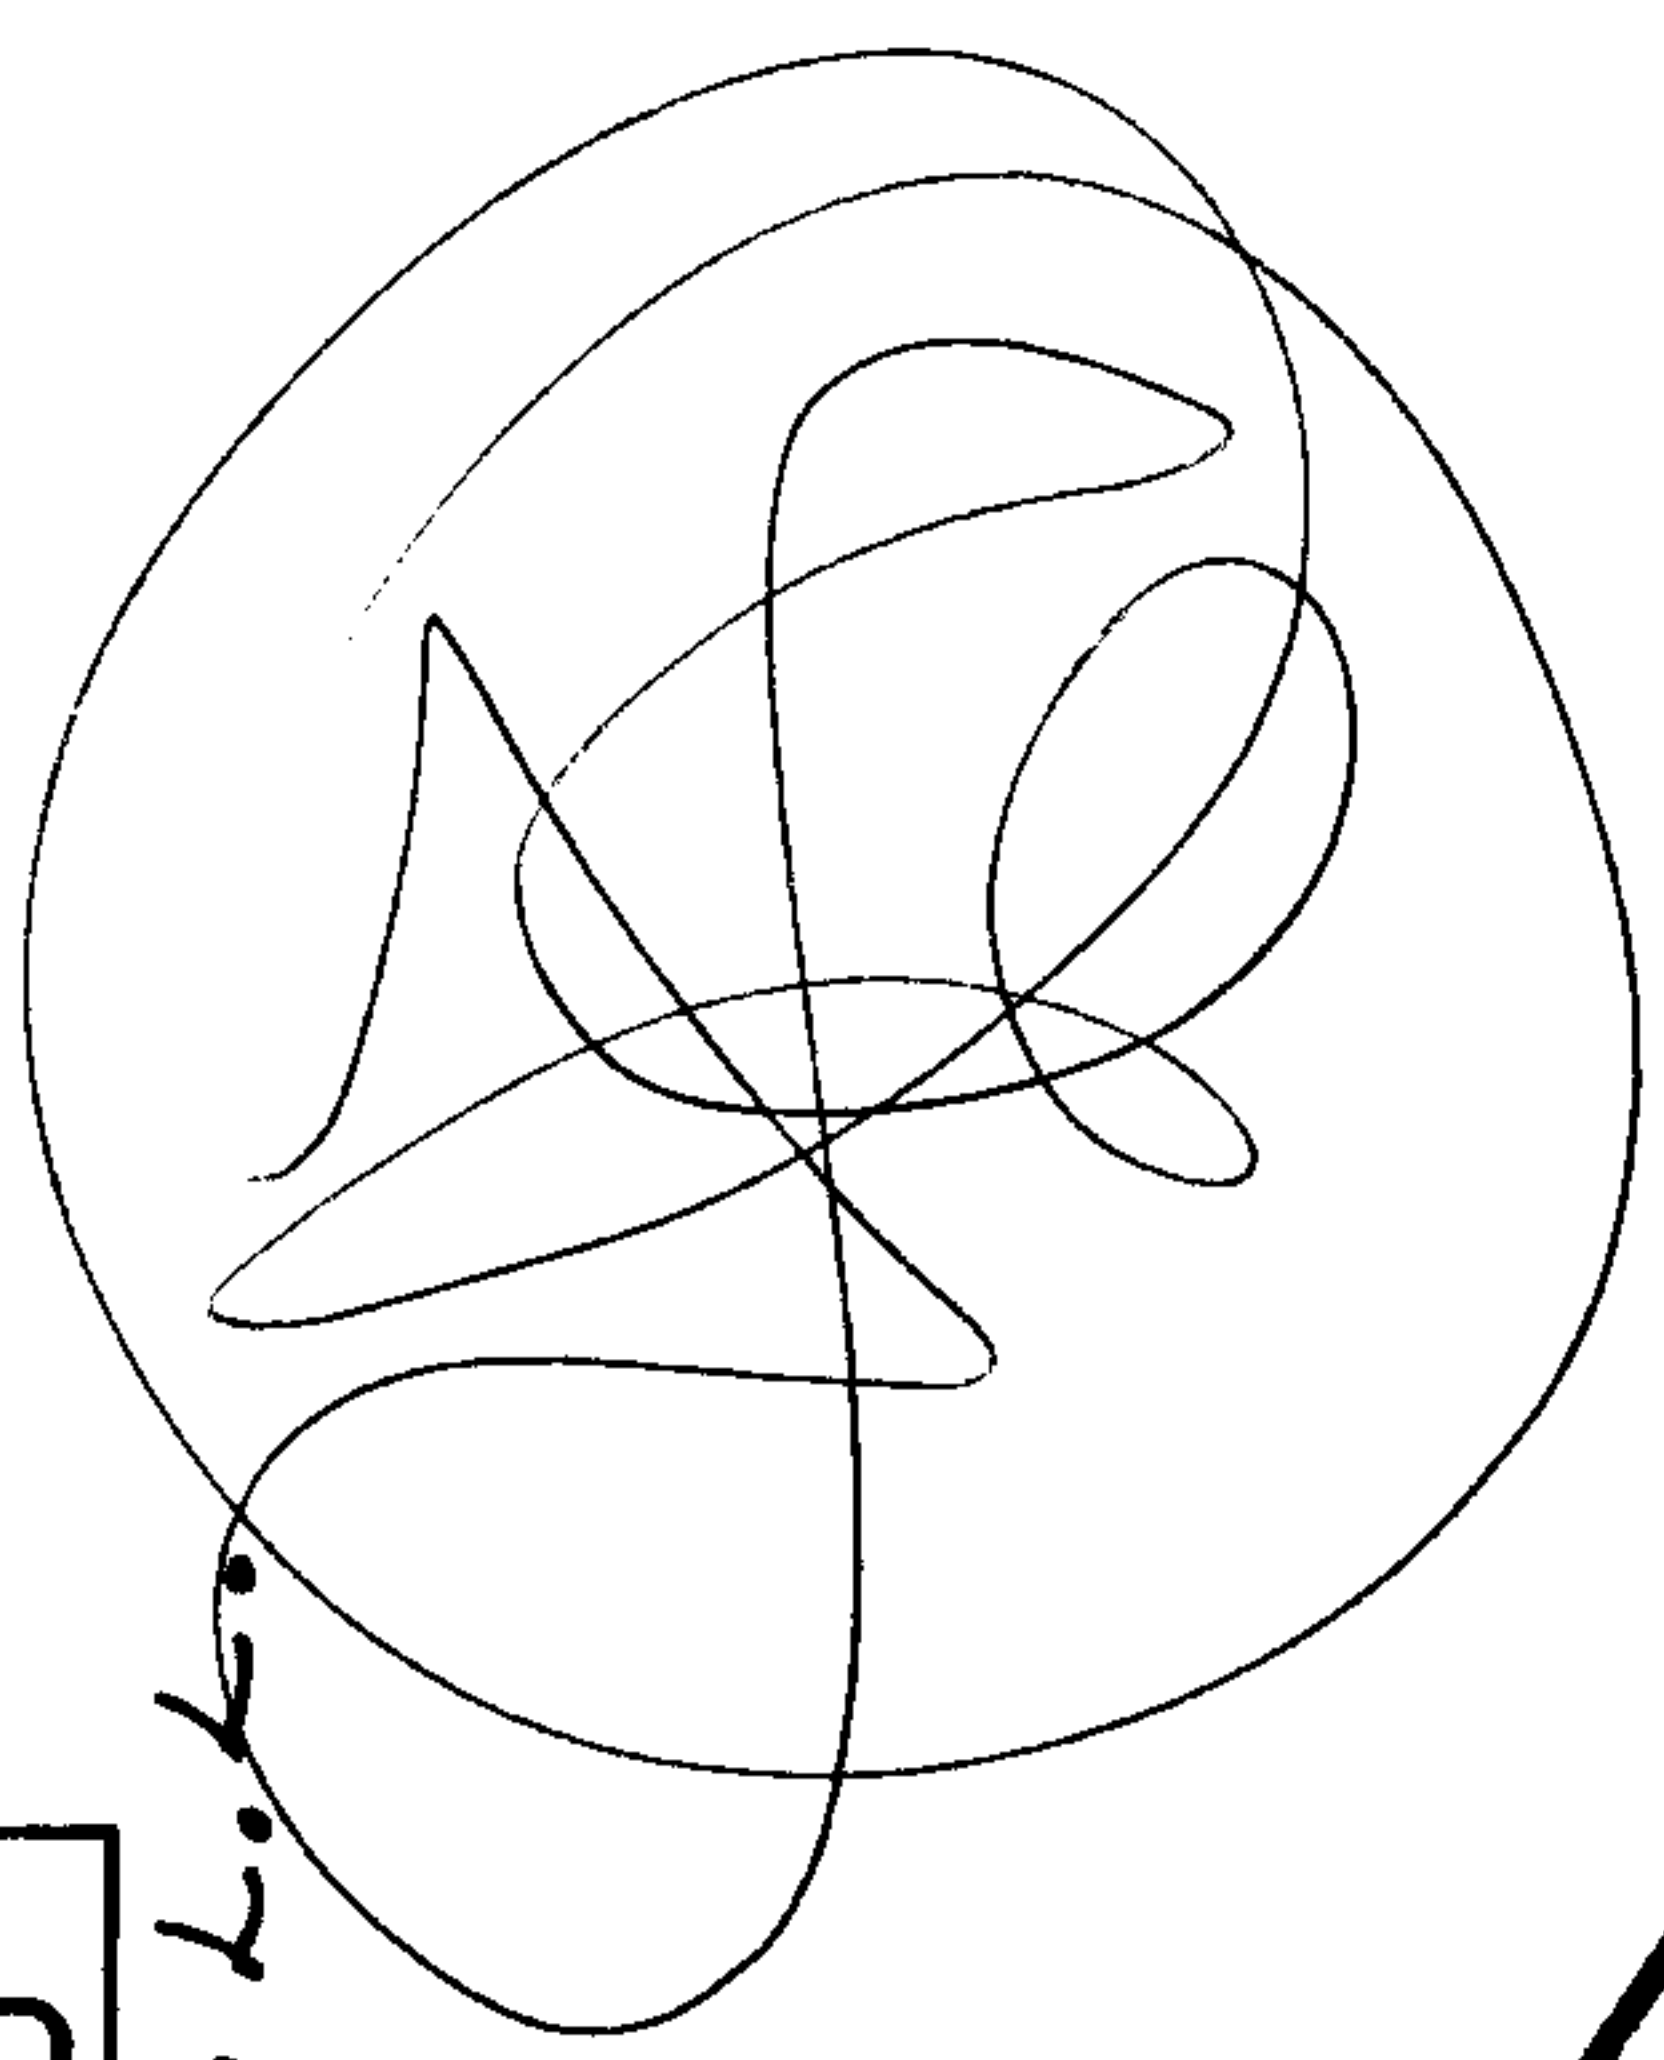

JAN 28 ENTD

5441

7-18-86 L.K.

APPROVED
LORAIN CO.
MAP DEPT.
DATE 12/1/71
07-00-011-C
07-00-014-D
BY R. J. Kelling