


5445
5445

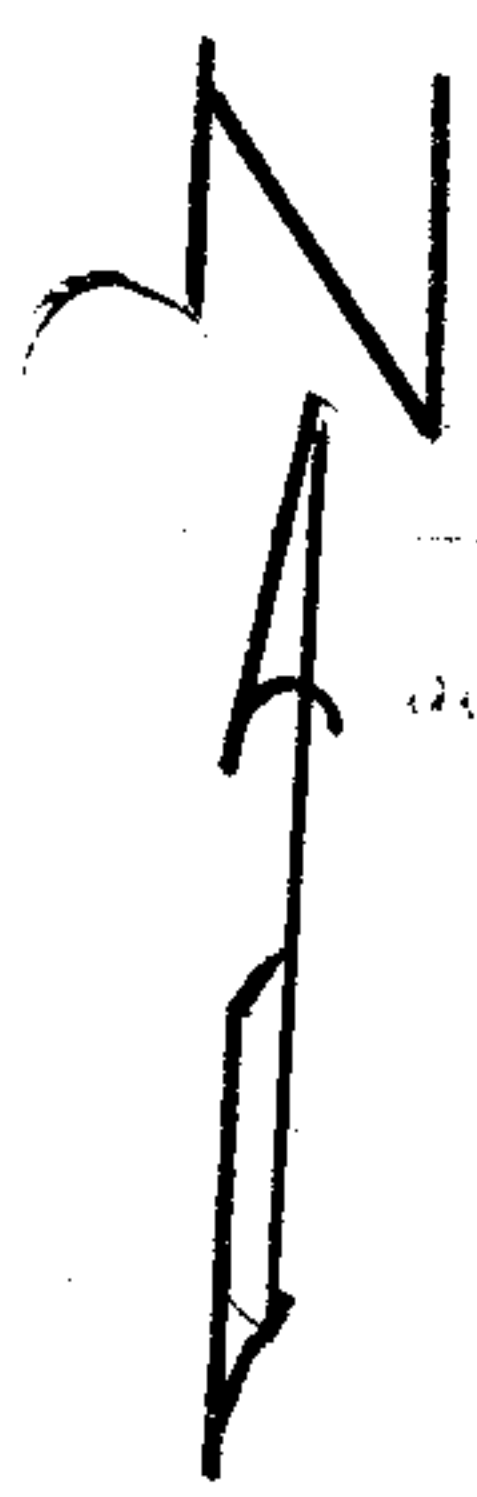

150
400
-006
138A
400
150

-007
~~-007~~
39.50 A
38.12

-002
39.50 A

3723
63

-003
42.34 A

3723.7
-004
8 32 A


-005
32 34 A

FEB 1 ENT'D

3724.5 RD.

7-28-86 L.L.

APPROVED
LORAIN CO.
MAP DEPT.
DATE 12/1/71
16-E
BY R.L. Kelling

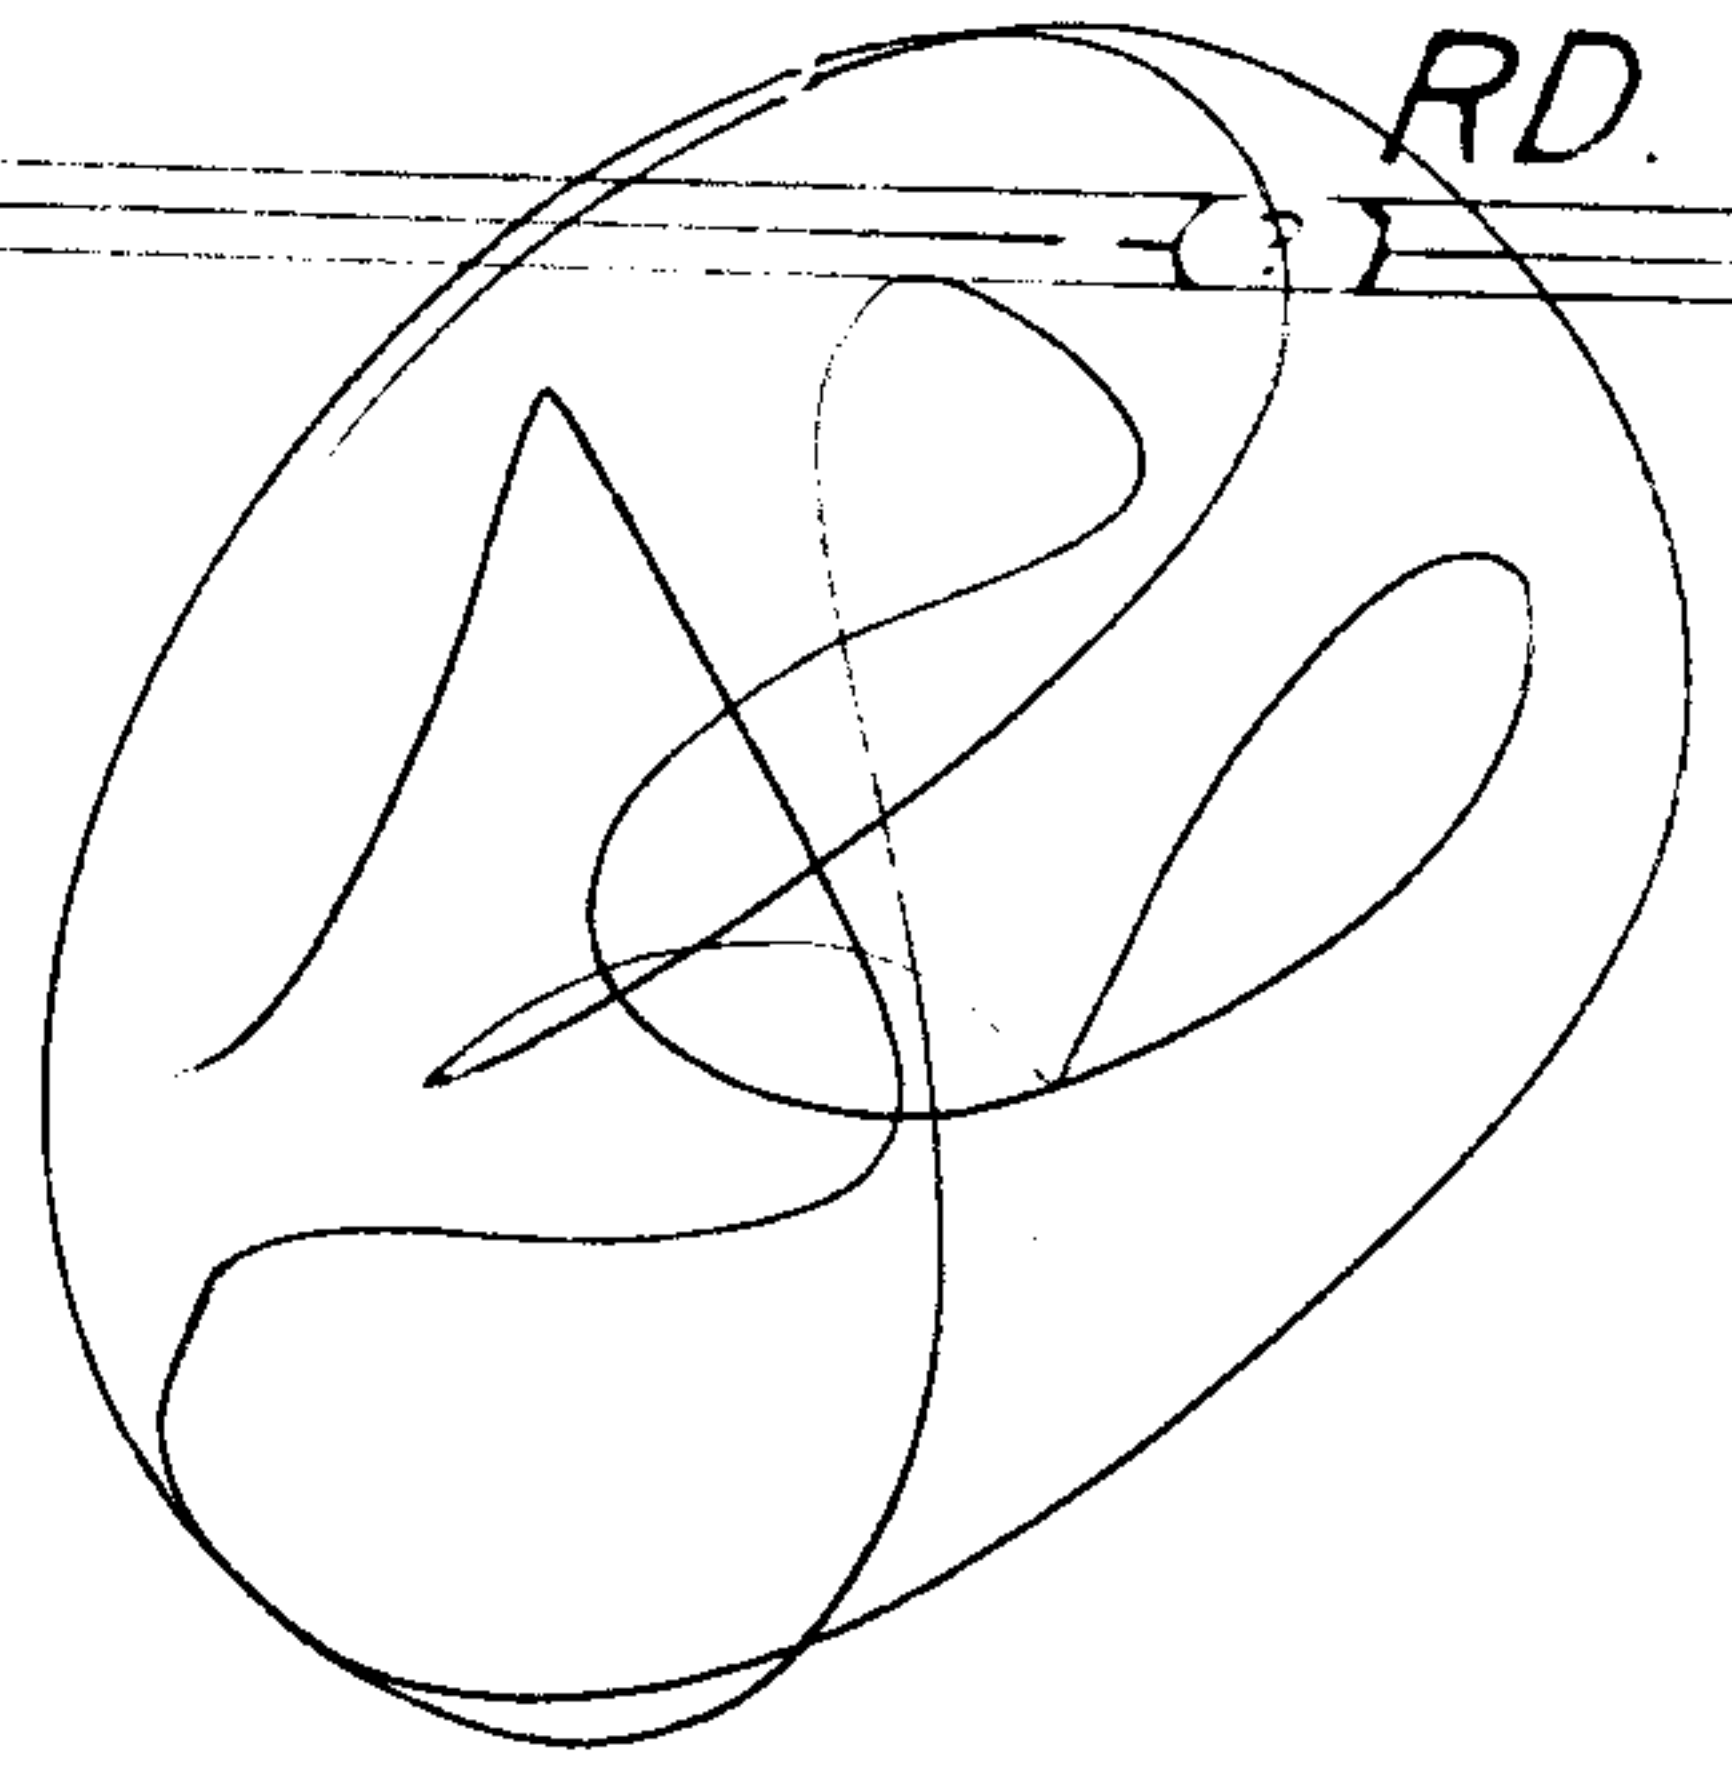

Map
Shop