


5446

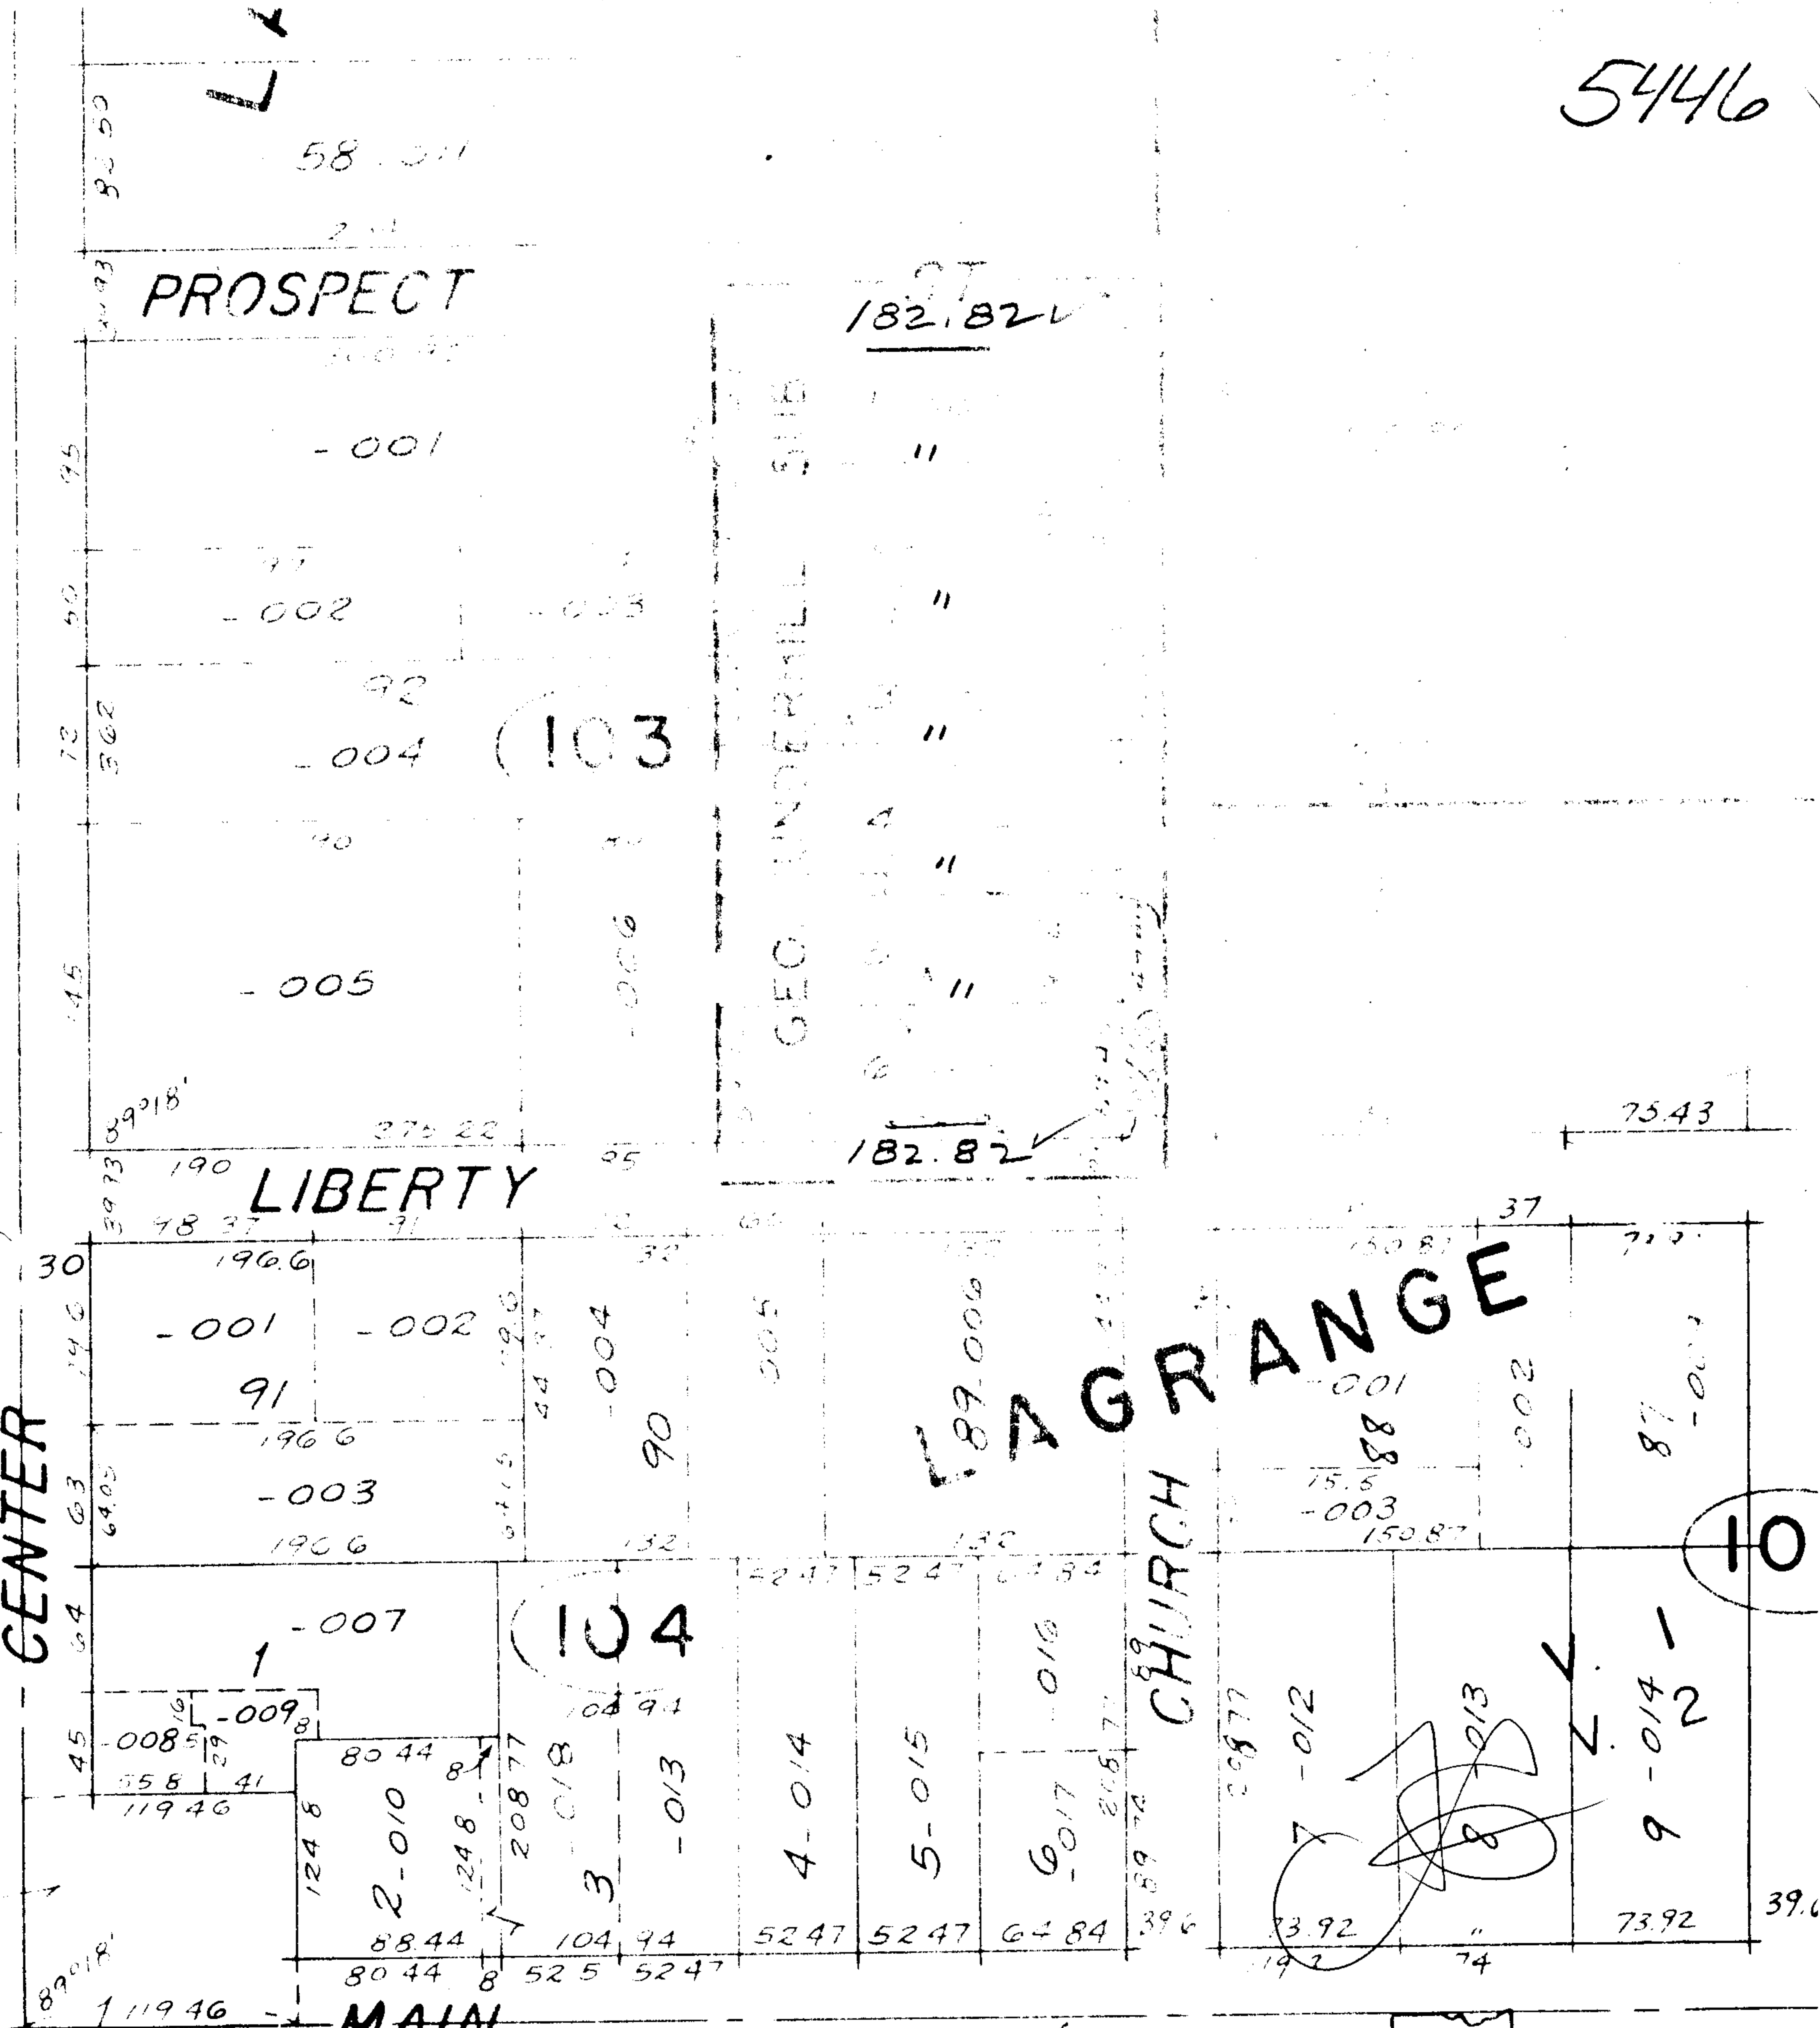

Note Correction Depths
 Geo. UnderHill Sub
 See Plat Vol 2 - Pg 16
 Depth of S/L 2.77 Chains
 $2.77 \times 66 = 182.82$

303 SEE 15-C

Page
 15-00-046A

LAGRANGE TWP.

SCALE 1" = 100'