

A 5A5


5459  
(3317)

- 017  
1.00 A.

- 018  
1.12 A.

- 019  
8.88 A.

029  
- 016  
~~5.23 A.~~  
4.53

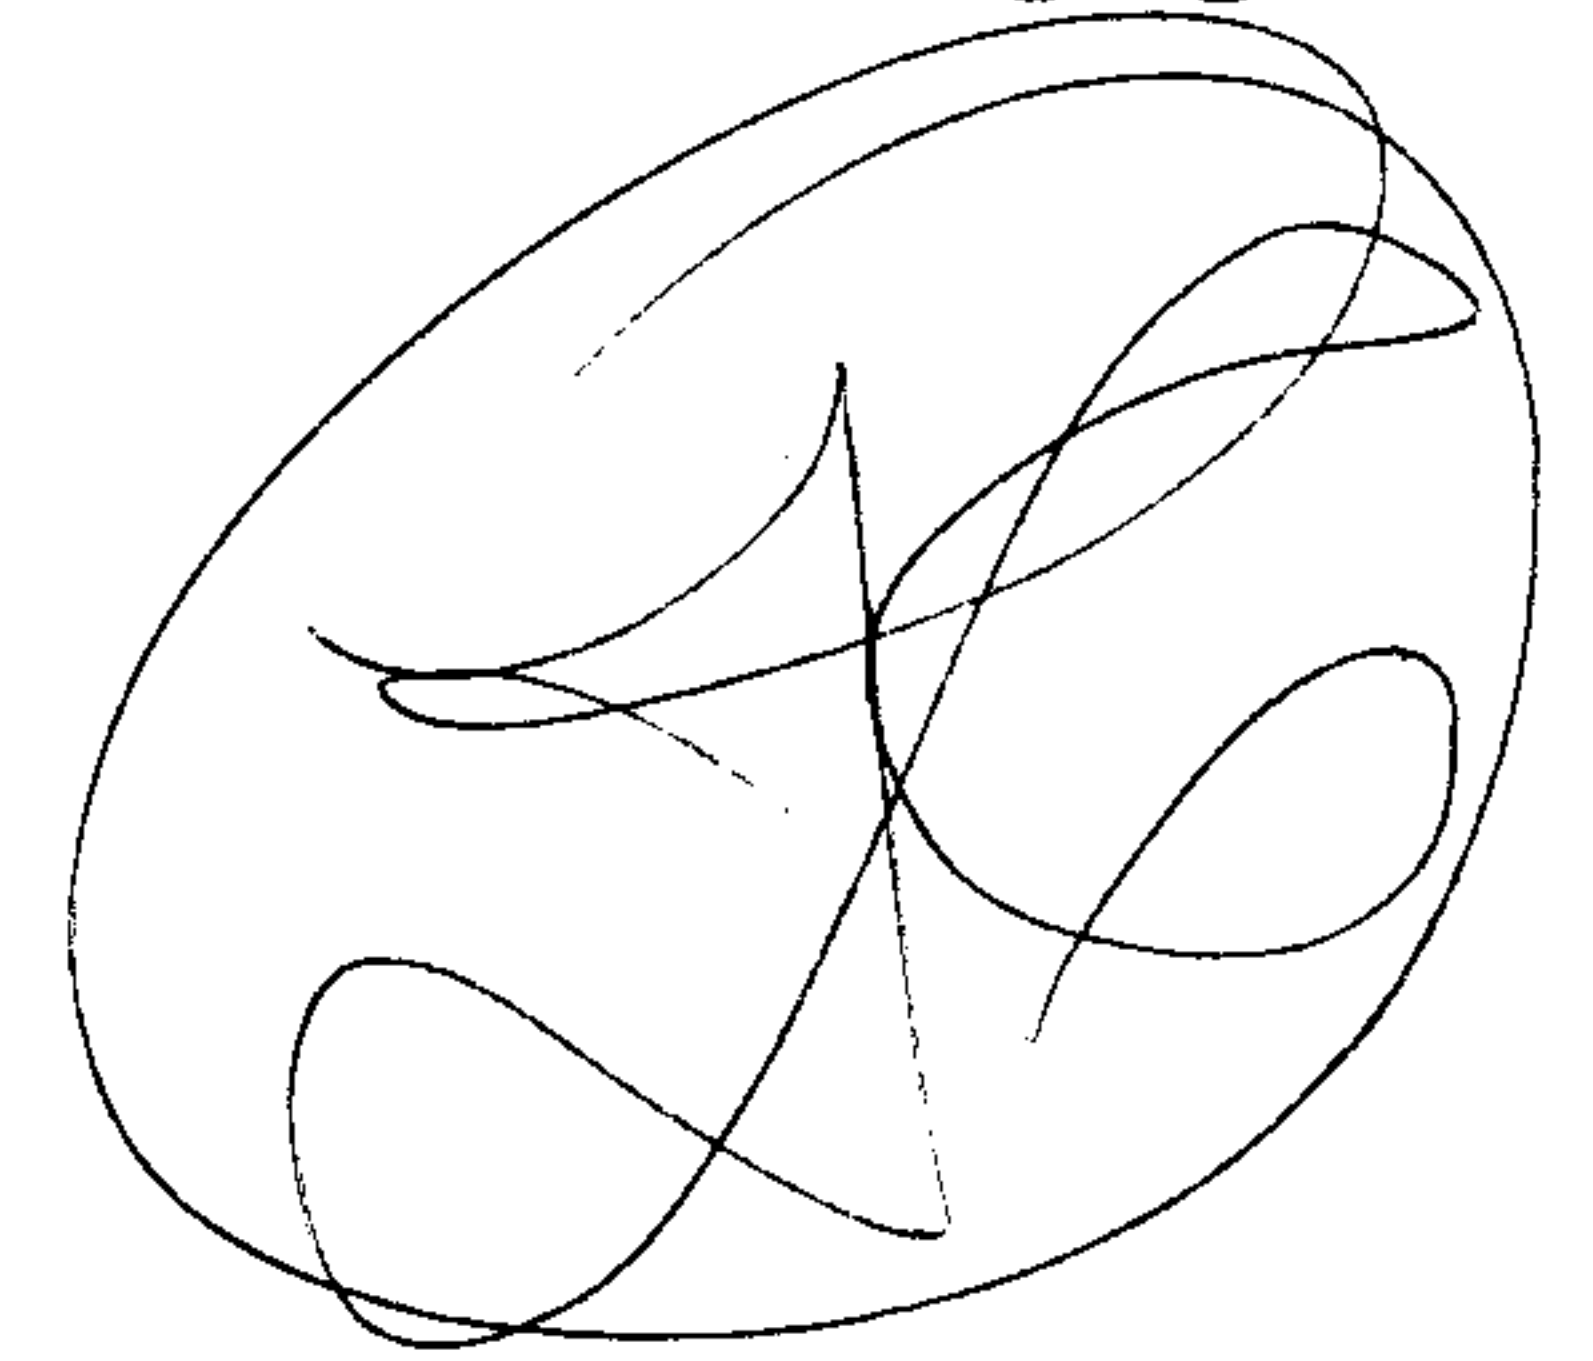

JAN 21 1971

5459


APPROVED
LORAIN CO.
MAP DEPT.
DATE 12-9-71
09-00-080 B
BY LWH

532.03  
- 028 AC  
65' AC  
scaled  
calculated

HALL

60

5459

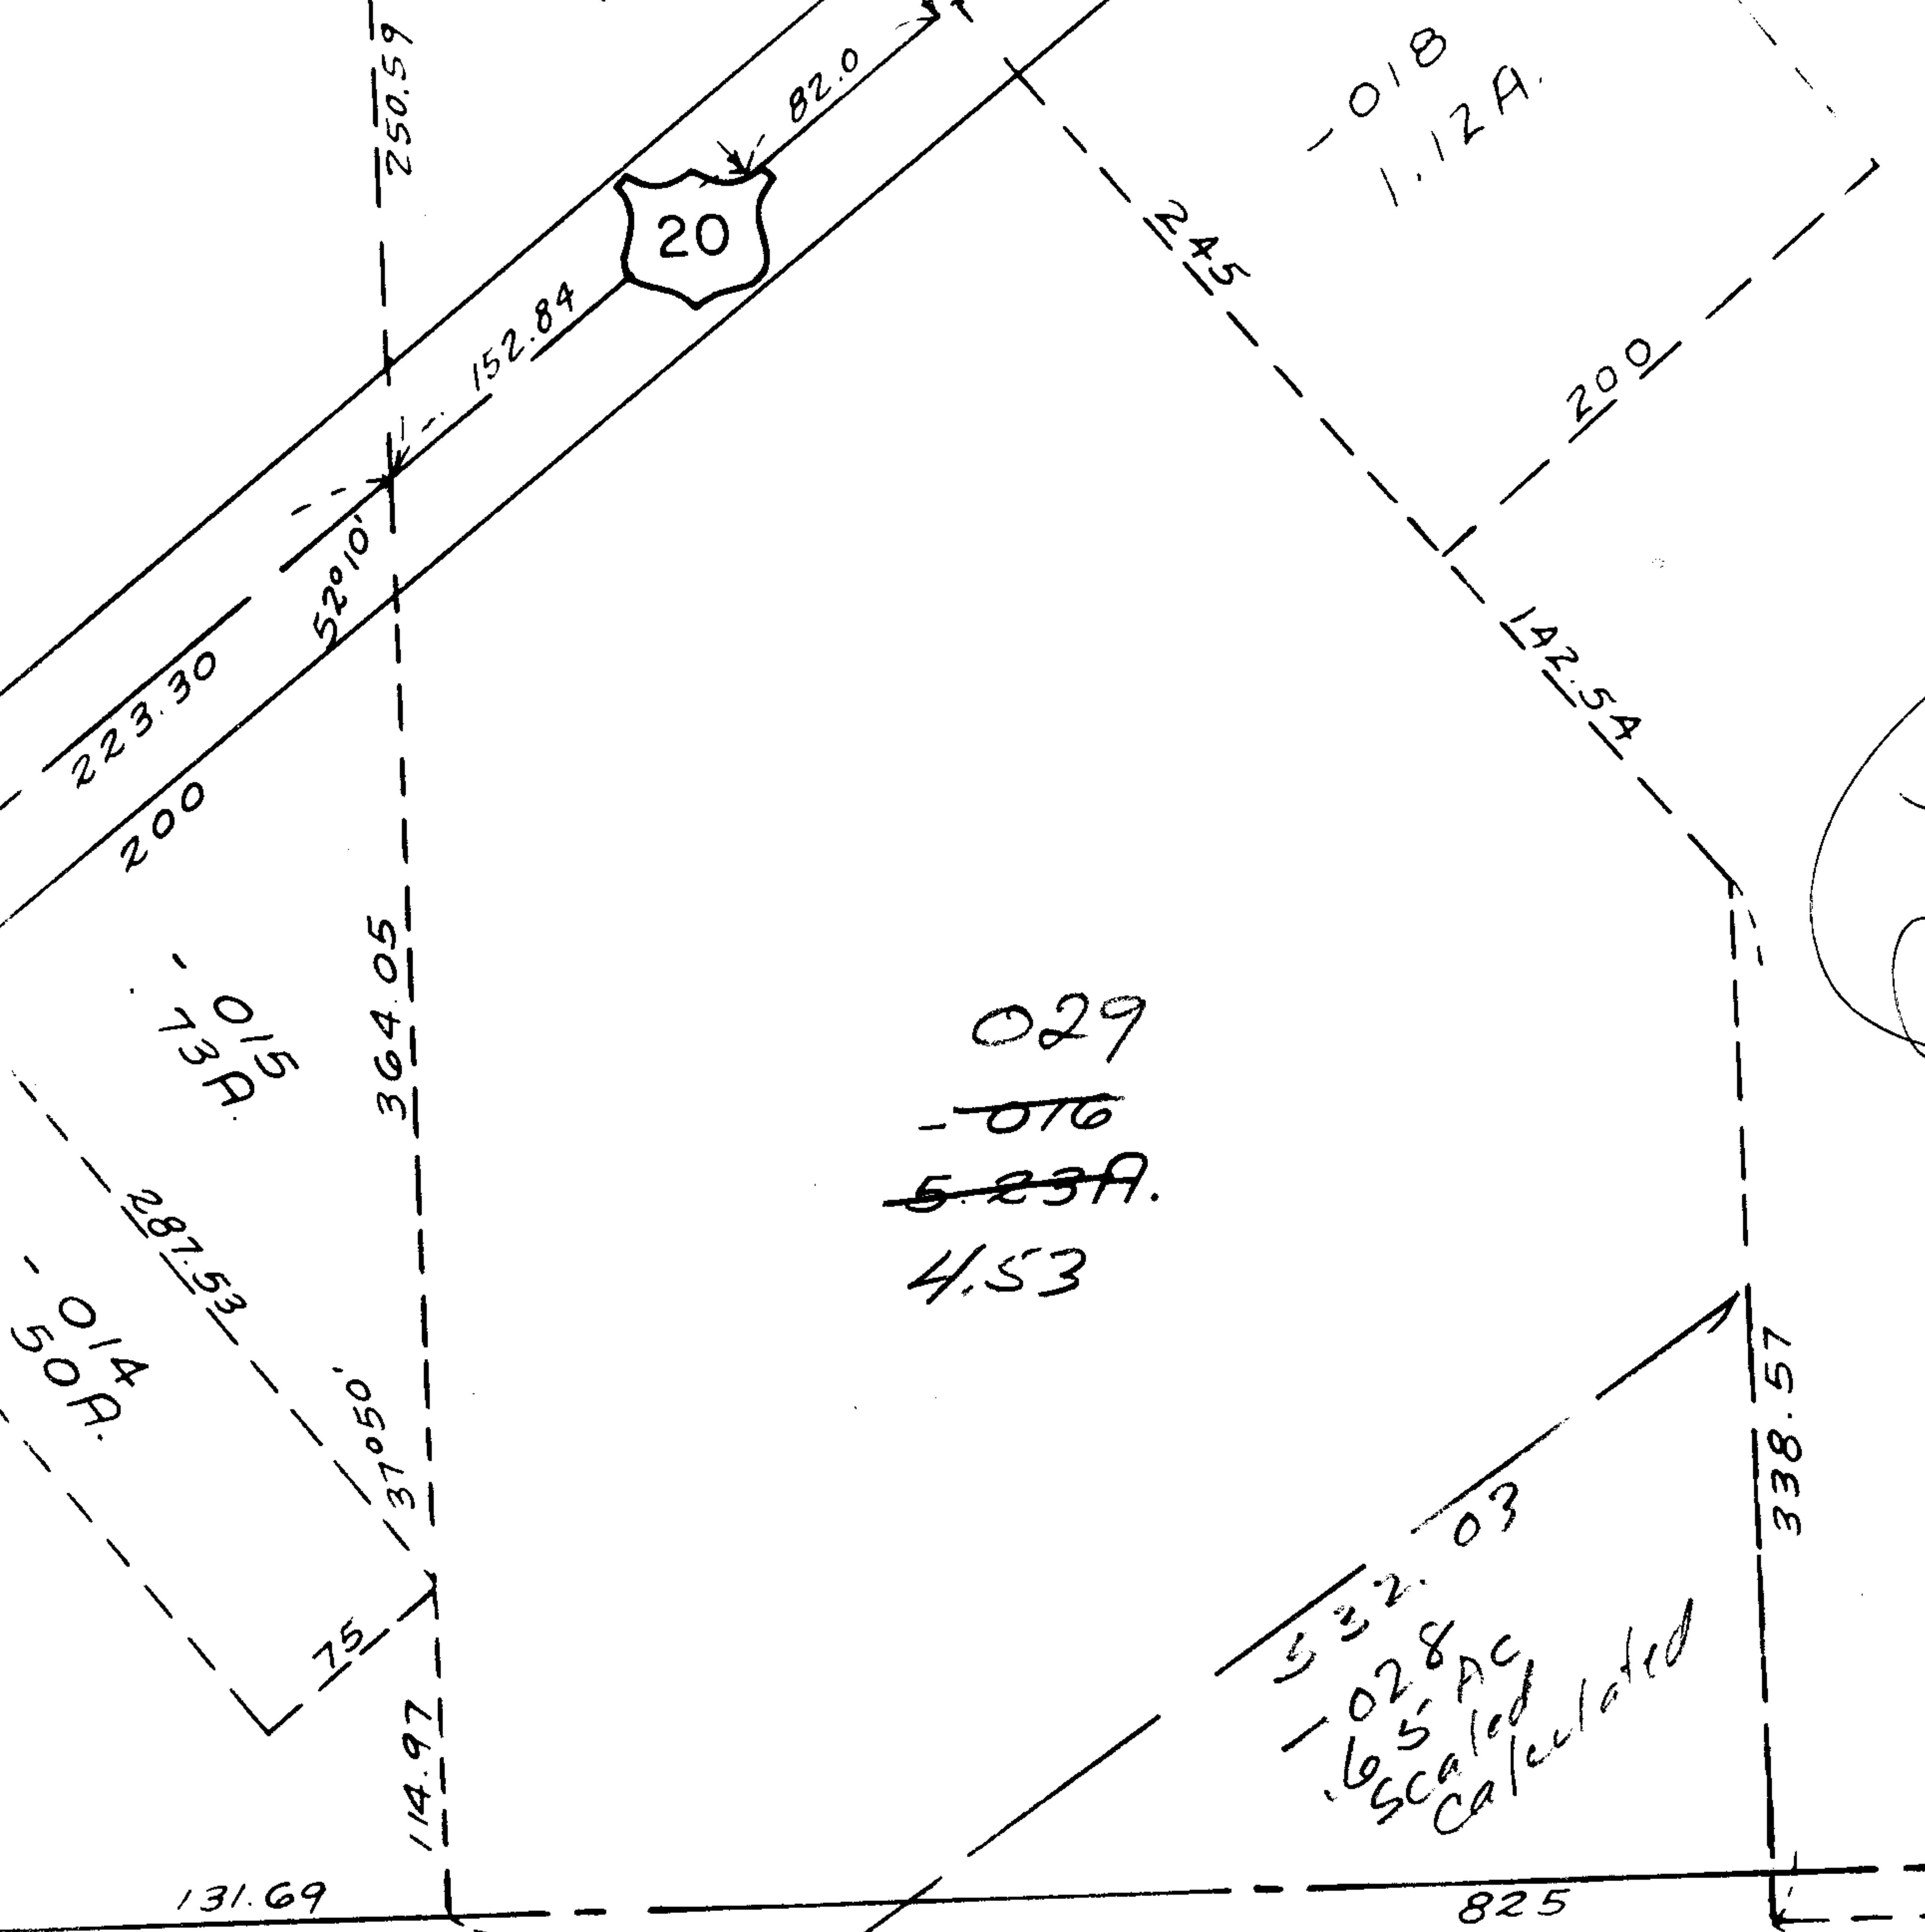

SEE 9-00-090-B

Note See New Page 9-00-090 B To Follow W H

9-00-080 B