


5462

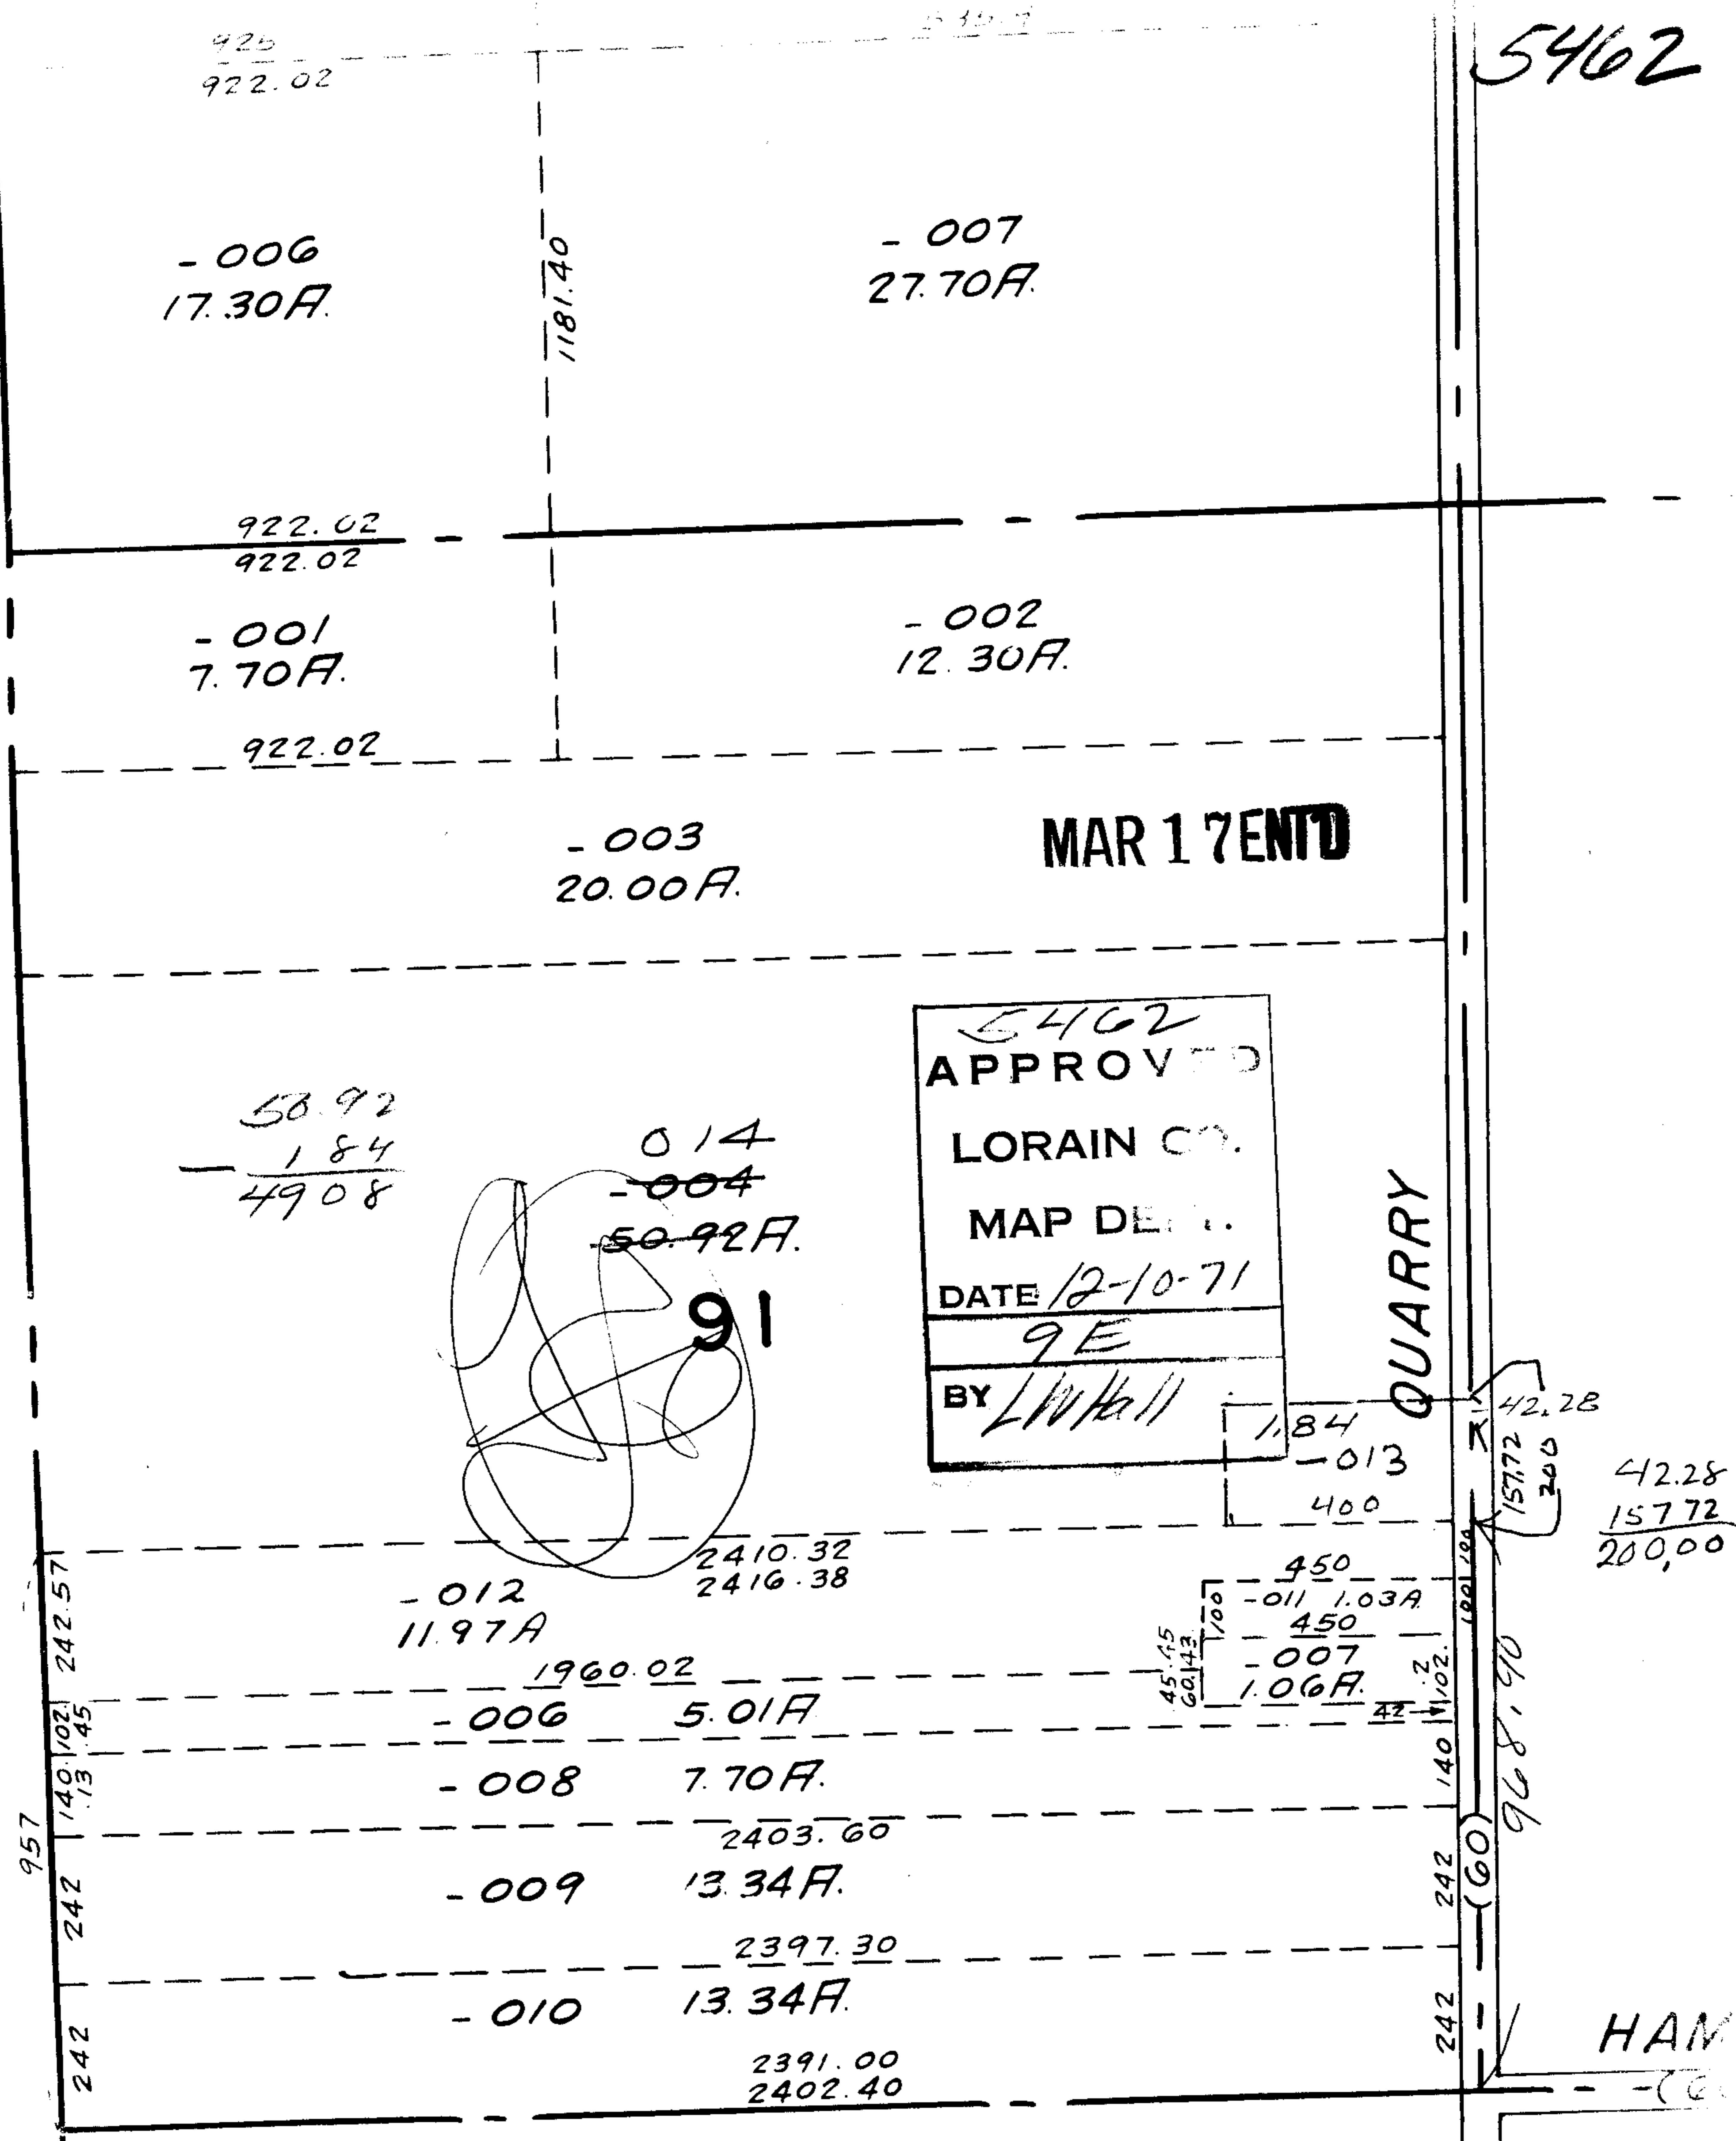

925
922.02

- 006
17.30 A.

- 007
27.70 A.

1181.40

922.02
922.02

- 001
7.70 A.

- 002
12.30 A.


922.02

- 003
20.00 A.

MAR 17 ENT'D

50.92
- 1.84
49.08

0.14
- 004
50.92 A.

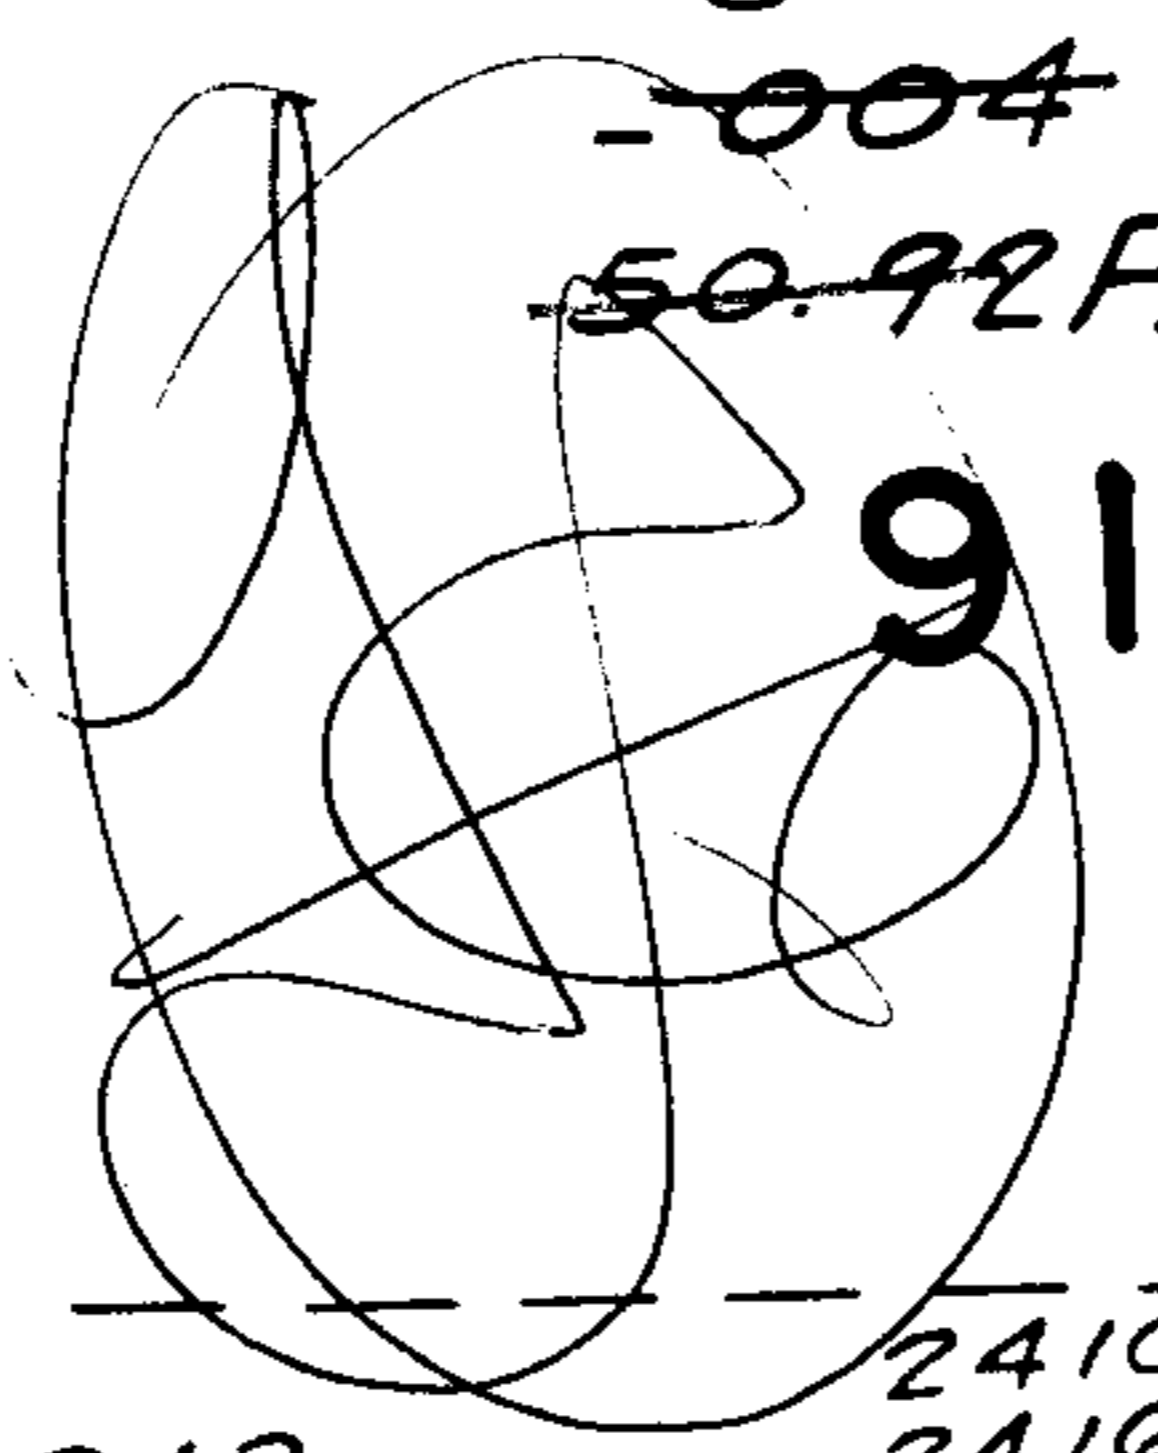

91

5462
 APPROVED
 LORAIN CO.
 MAP DEPT.
 DATE 12-10-71
 9E
 BY LWHall

QUARRY

1.84
- 013
400

42.28
157.72
300

42.28
157.72
200.00

- 012
11.97 A
2410.32
2416.38

1960.02

- 006
5.01 A

- 008
7.70 A.

2403.60

- 009
13.34 A.

2397.30

- 010
13.34 A.

2391.00
2402.40

957
242
140.102
140.13
242.57
242

45.45
60.43
1.00
450
- 011 1.03 A
450
- 007
1.06 A.

157.72
42.28
968.90
242
140
242
242
(60)

HAM

SEE INSERT

Copyright 1963

7-24-70

9-E

RUSSIA TWP.

SCALE: 1" = 400'