

325  
164  
164

SEE 12-00-081-B

50  
RD 764.88  
164.88  
259.66  
164.68  
100

164.87

164.87

1323.52

-038  
5.01 A.

1323.92

~~-035~~  
14.99 A.

~~14.99~~  
~~9.99~~

-039  
4.98 A.


JAN 28 1972

5468

APPROVED
LORAIN CO.
MAP DEPT.
DATE 12-14-71
12-00-082-B
BY <i>[Signature]</i>

1324.32

-034  
5.01 A.

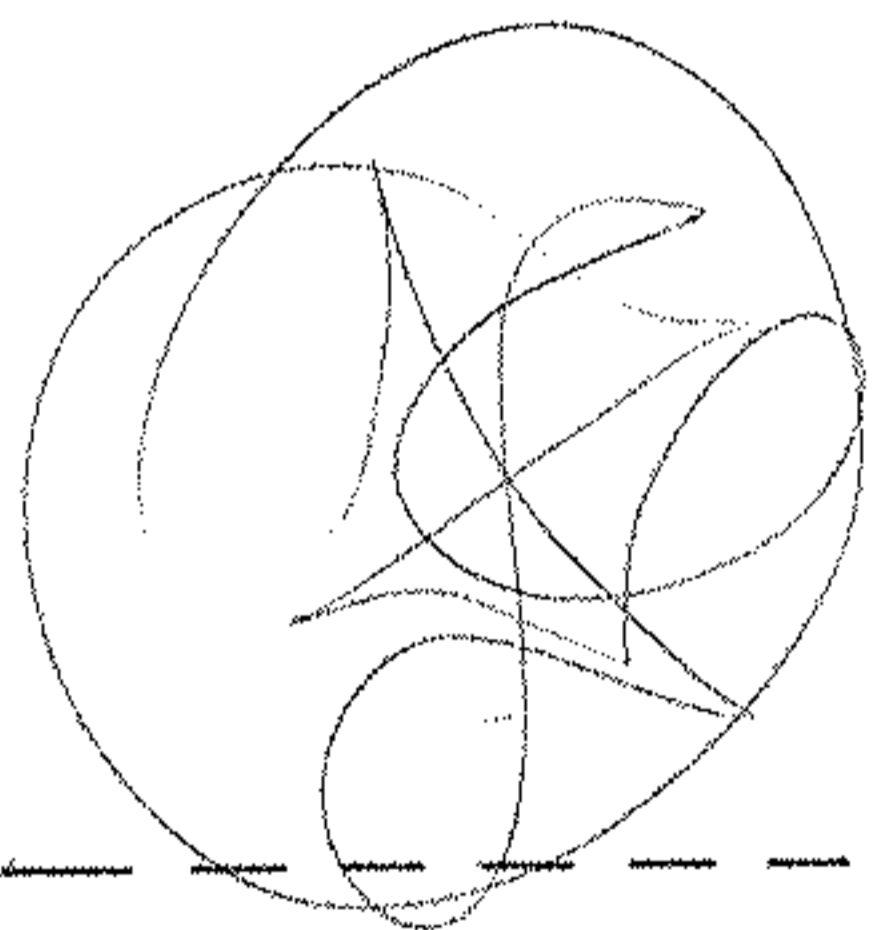

1324.72

350

-029  
1.80 A.

100

5468