


RD.

$$\begin{array}{r} 43.64 \\ 7.75 \\ \hline 35.89 \\ 7.75 \\ \hline 28.14 \end{array}$$

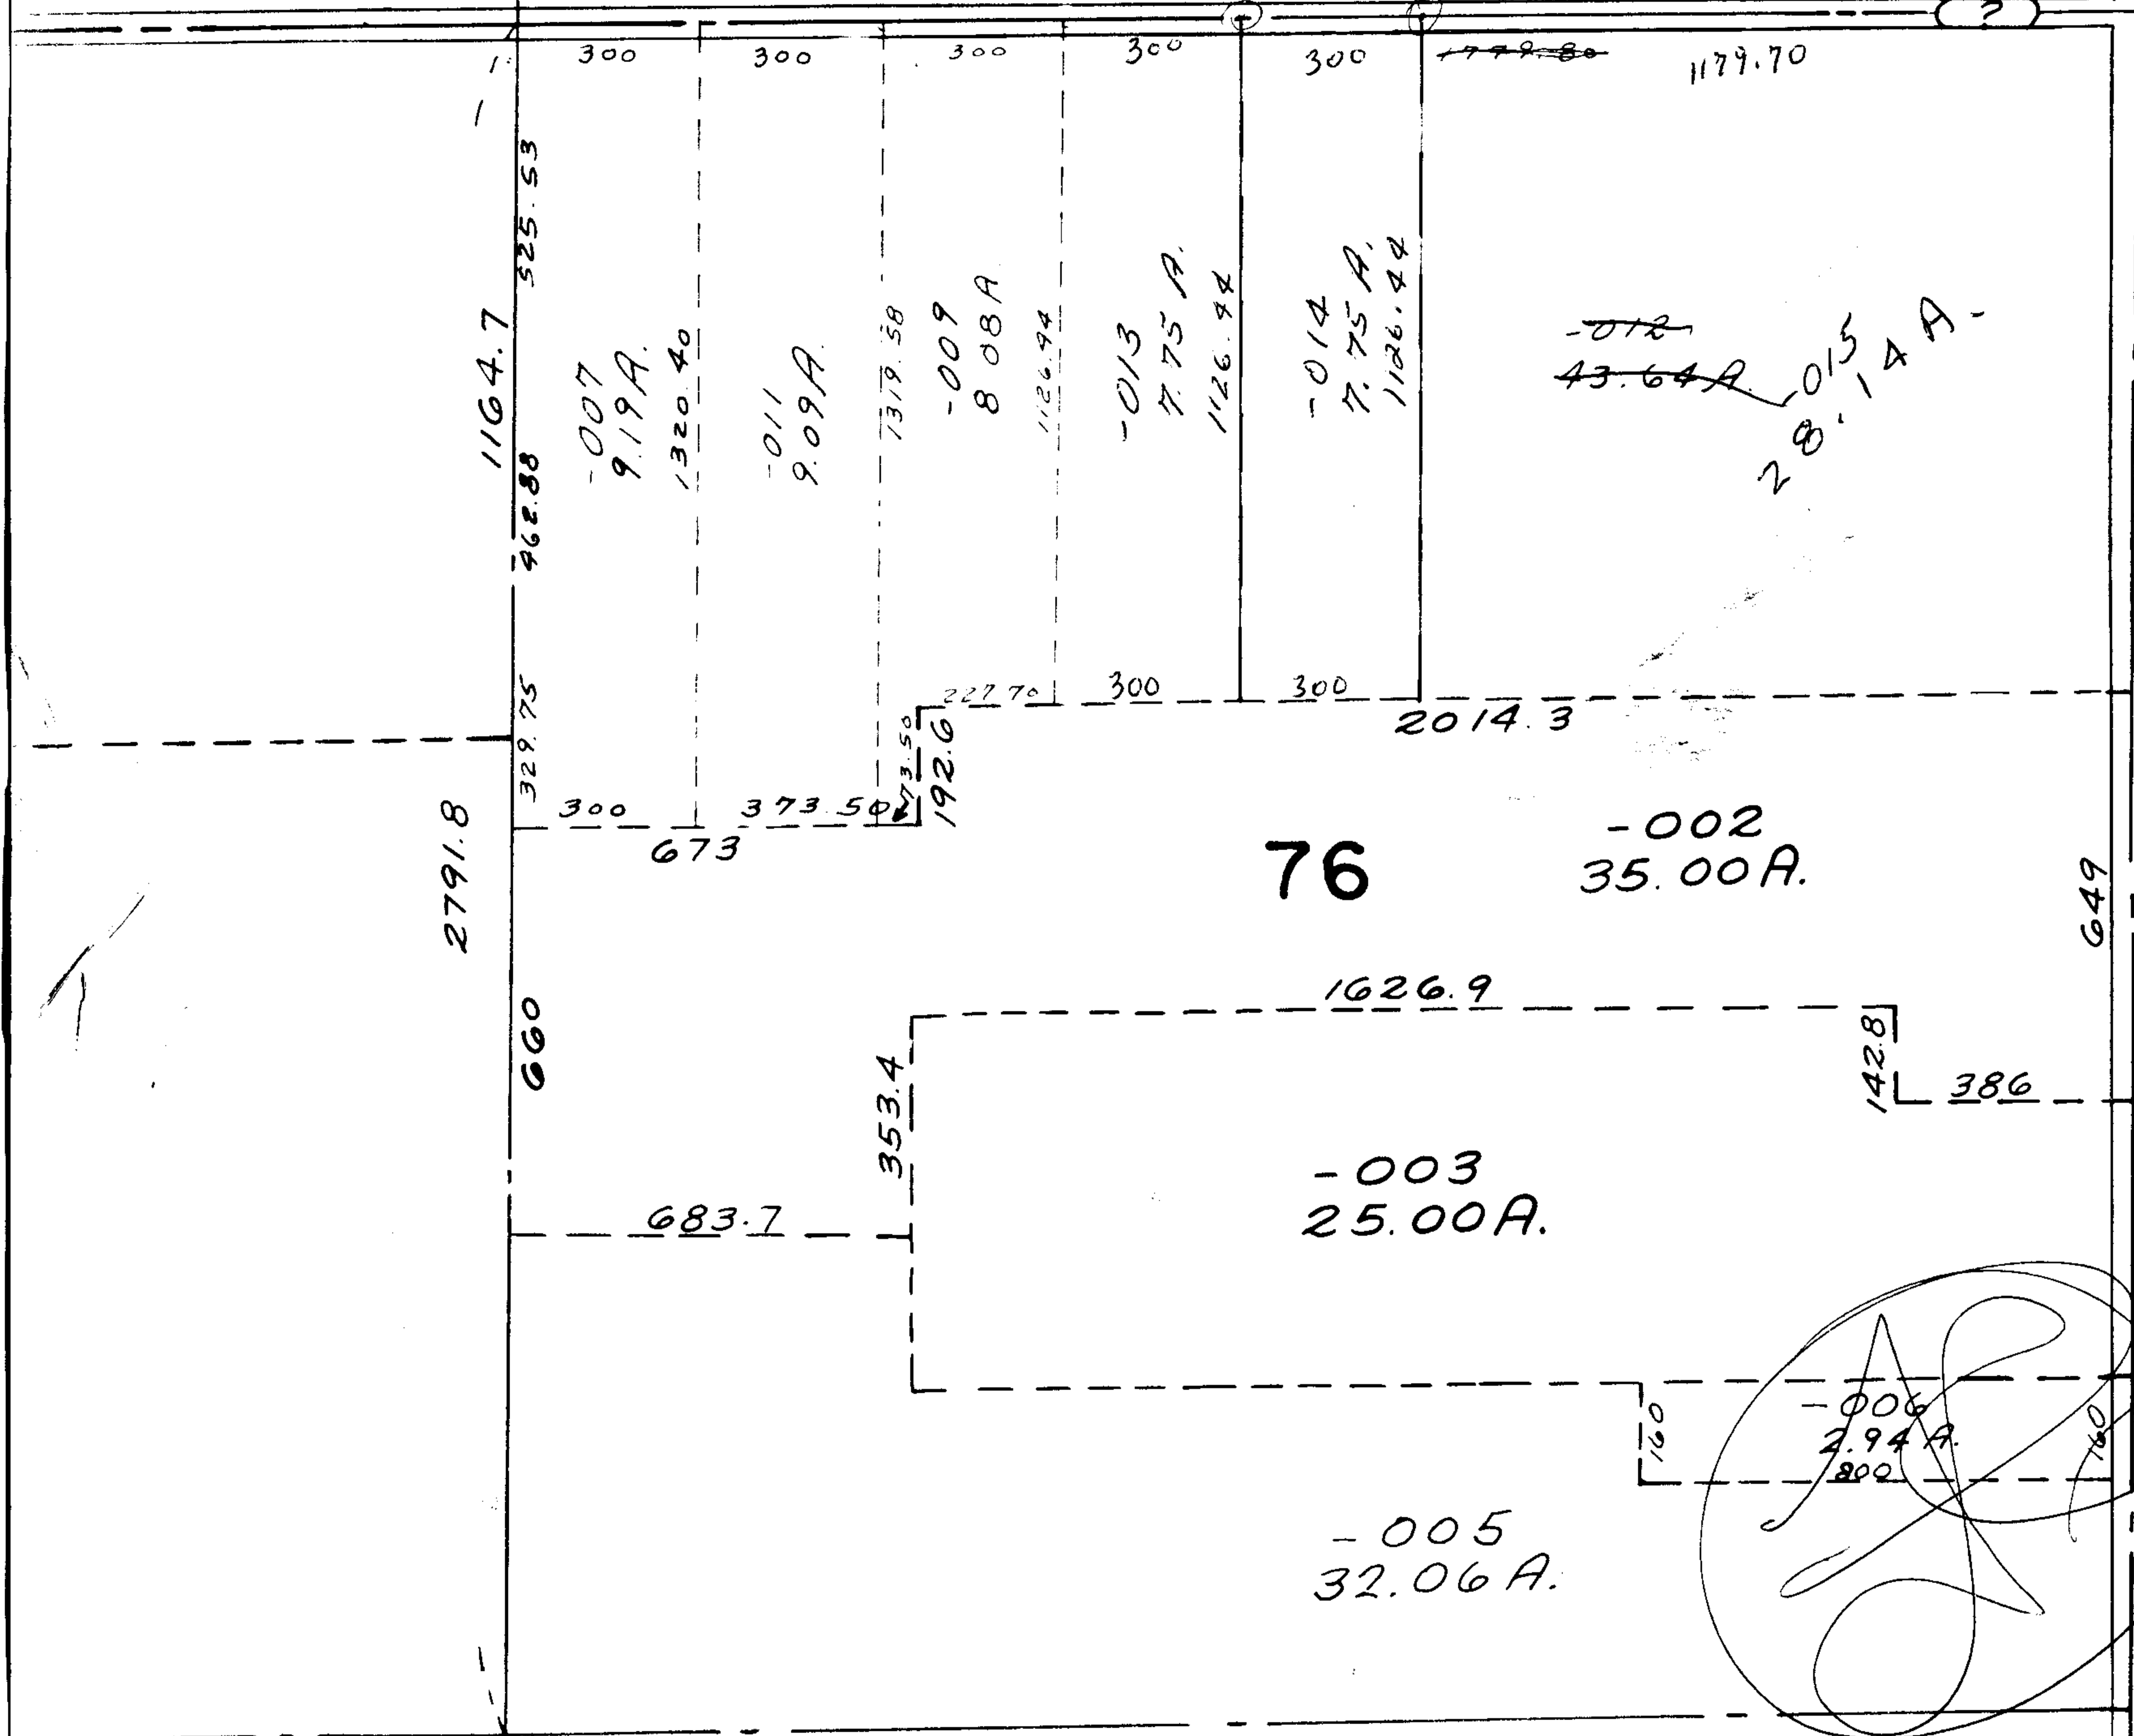

FEB 1 ENT'D

5470
2-28-86

APPROVED
LORAIN CO.
MAP DEPT.
DATE 12-14-71
16-F
BY <i>H. Colby</i>

5470