


5483

- 017  
~~214~~  
~~5400~~  
54.00 AC

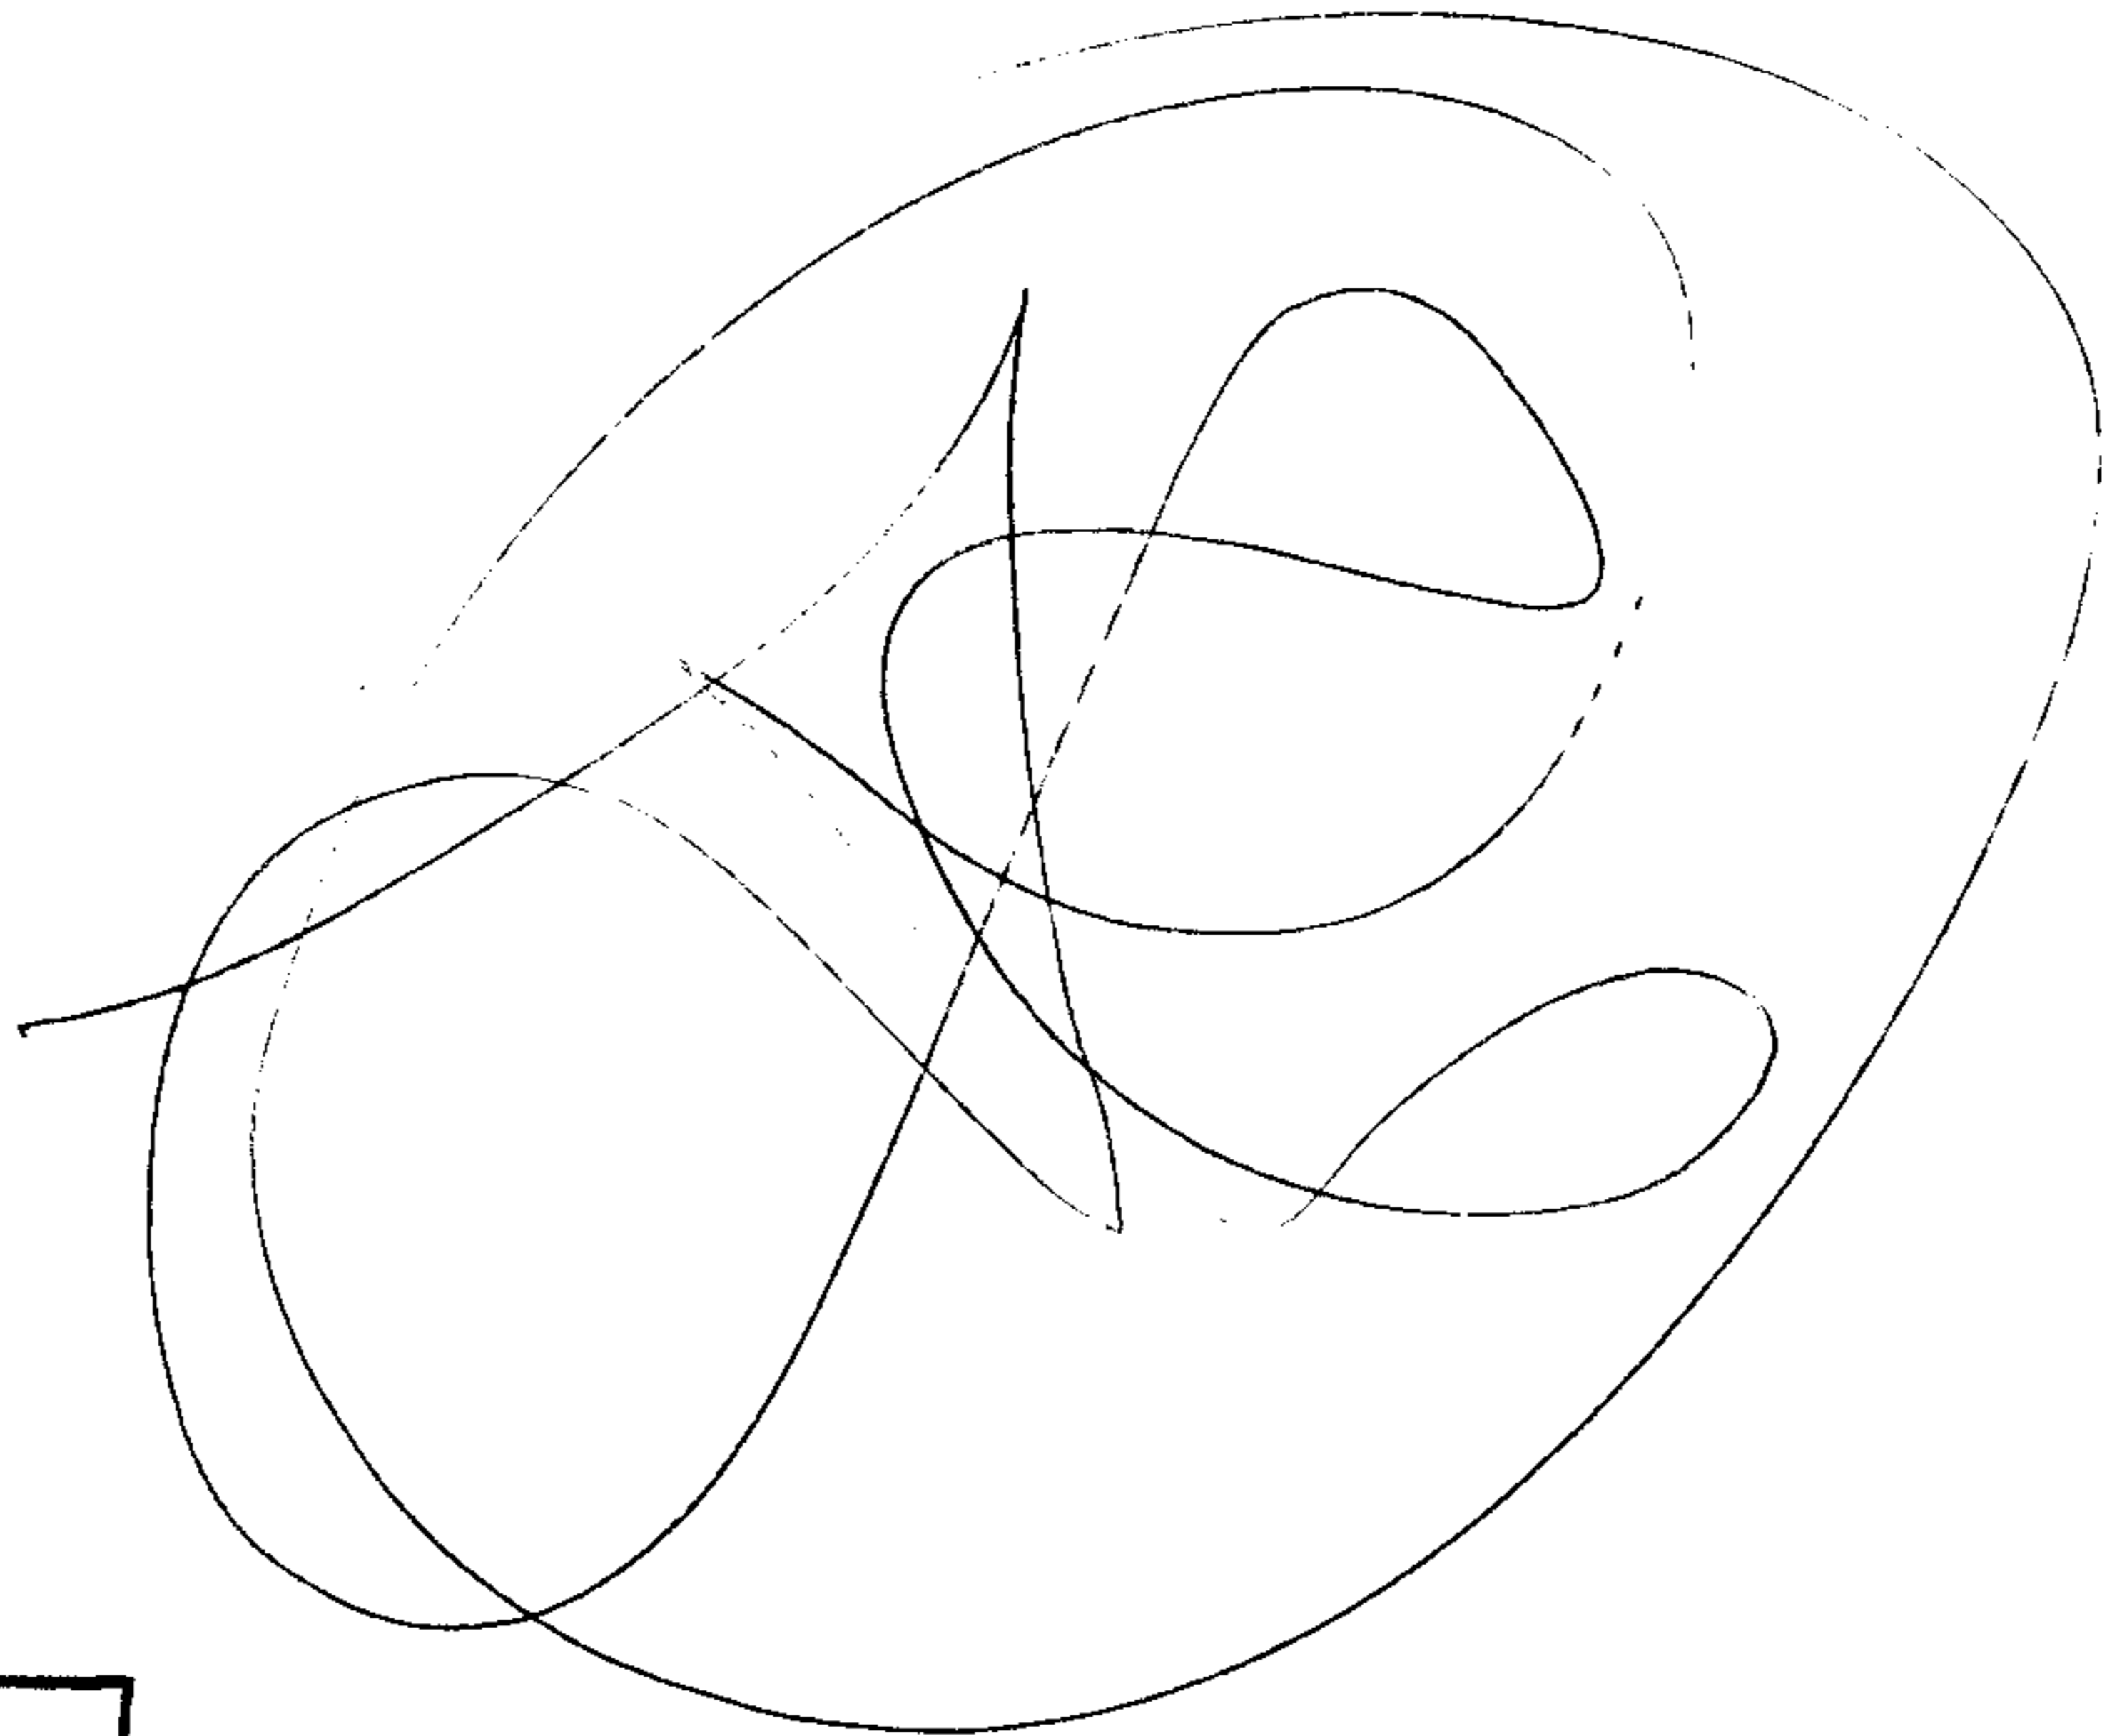


FEB 1970

5483  
APPROVED  
LORAIN CO.  
MAP DEPT.  
DATE 12-21-71  
13-11-017  
BY LWHall

1209.46  
86.39  
1123.07

259.17  
863.90  
1123.07  
259.17  
950.29  
1209.46  
1123.07  
86.39

~~1123.07~~

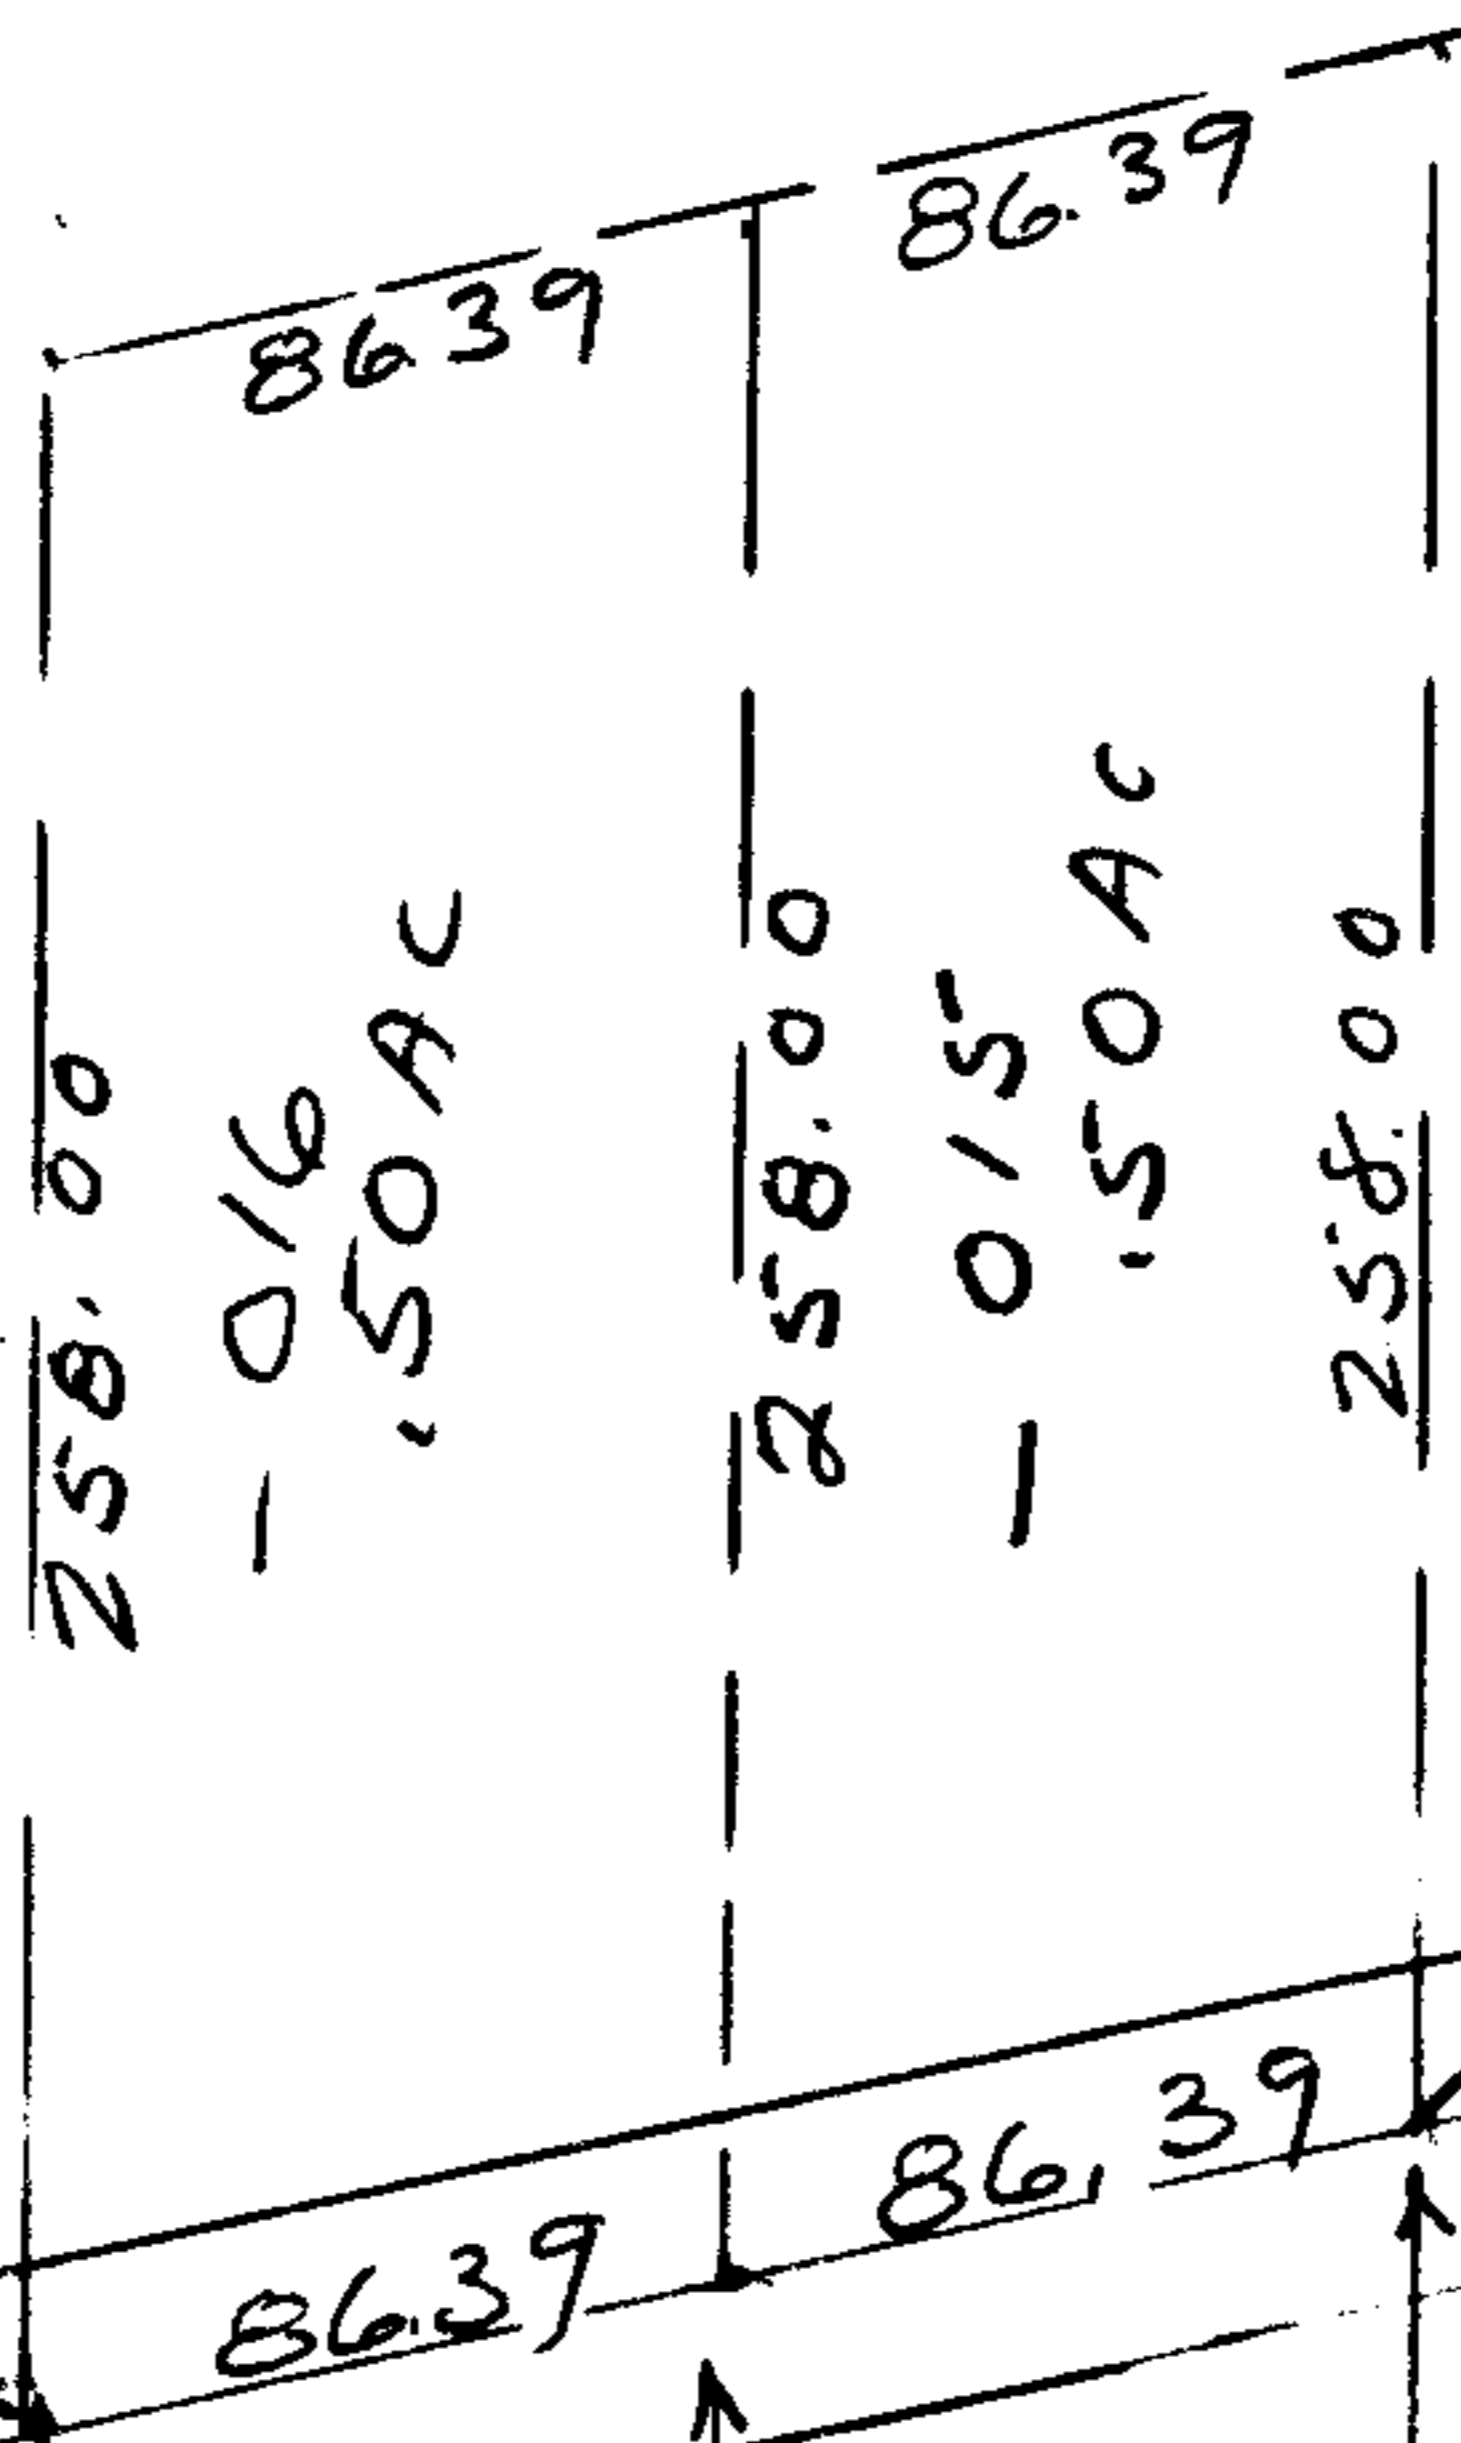

1123.07  
To 06 Line

500

1209.46  
St. Line  
OL 17  
E.  
1123.07  
St. Line  
OL 17  
E.

13-11-017