


1-035-B

SEE 5-00-035-

#5493

05-00-035-000

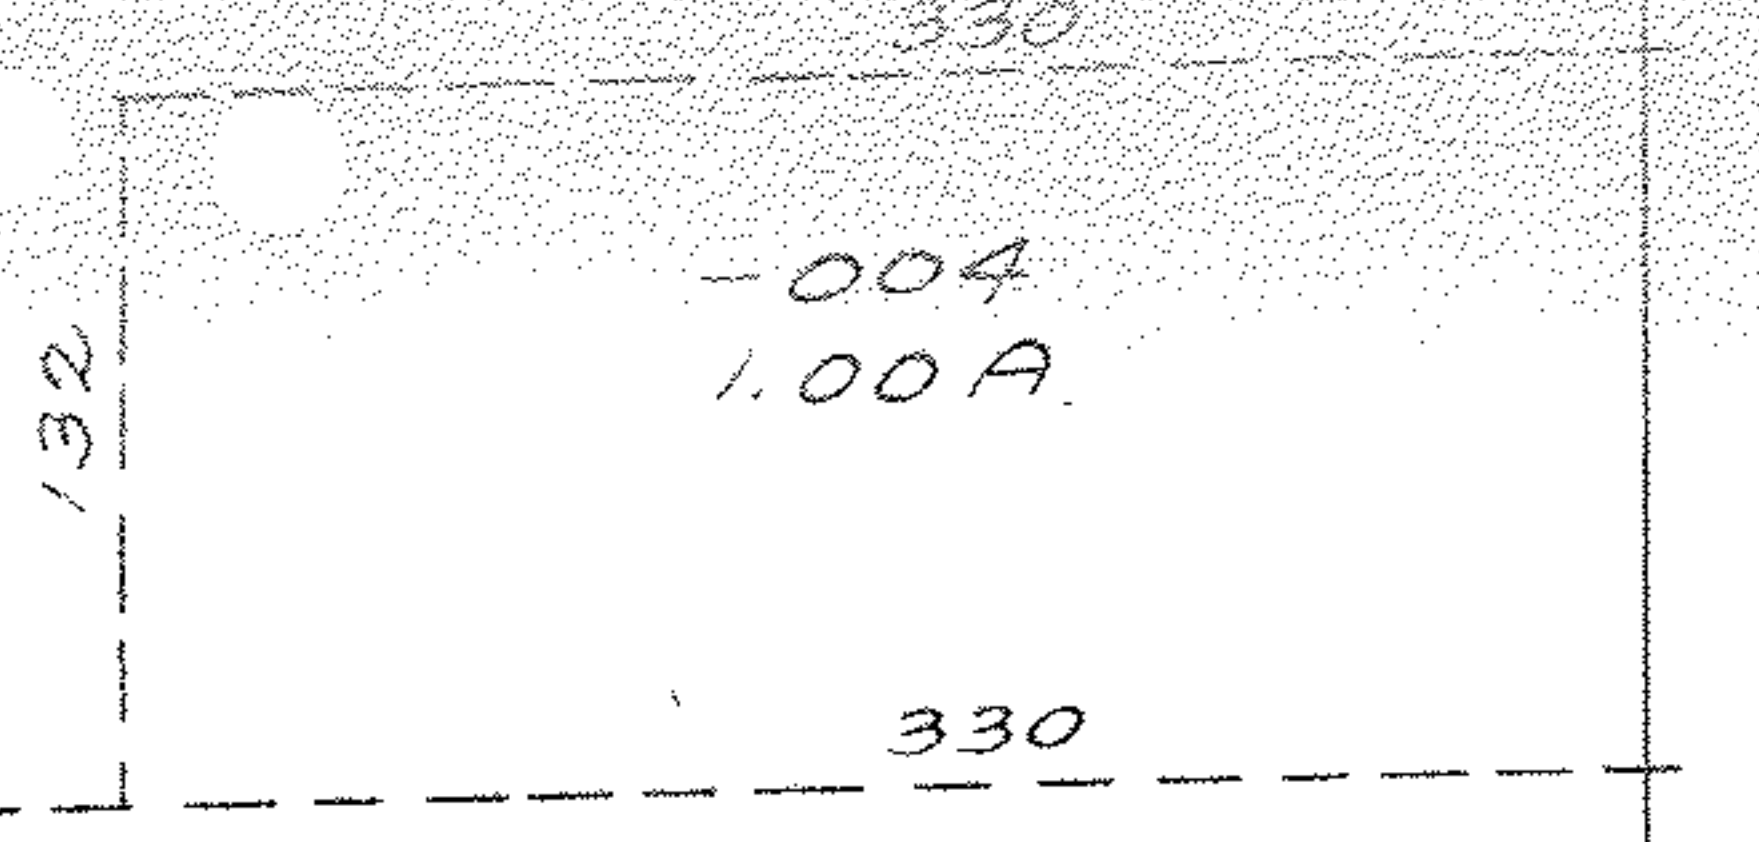

SEE 5-
58

90°33'30"


05-00-035-105-

-013

~~16.54A~~

18.30Ac

5493
 APPROVED
 LORAIN
 MAP DEPT.
 DATE 12-22-71
 05-00-035B
 BY LWHall

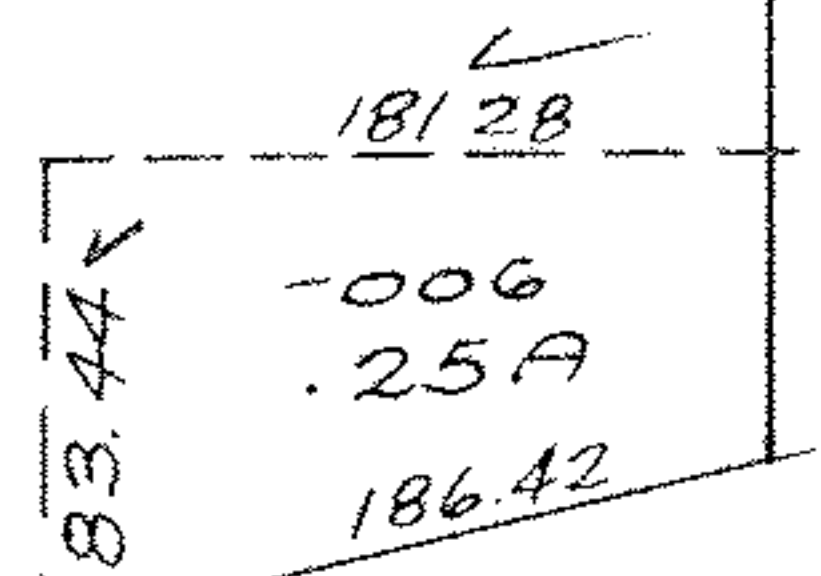


642.22

1216.57

1648.00

-010
11.66A

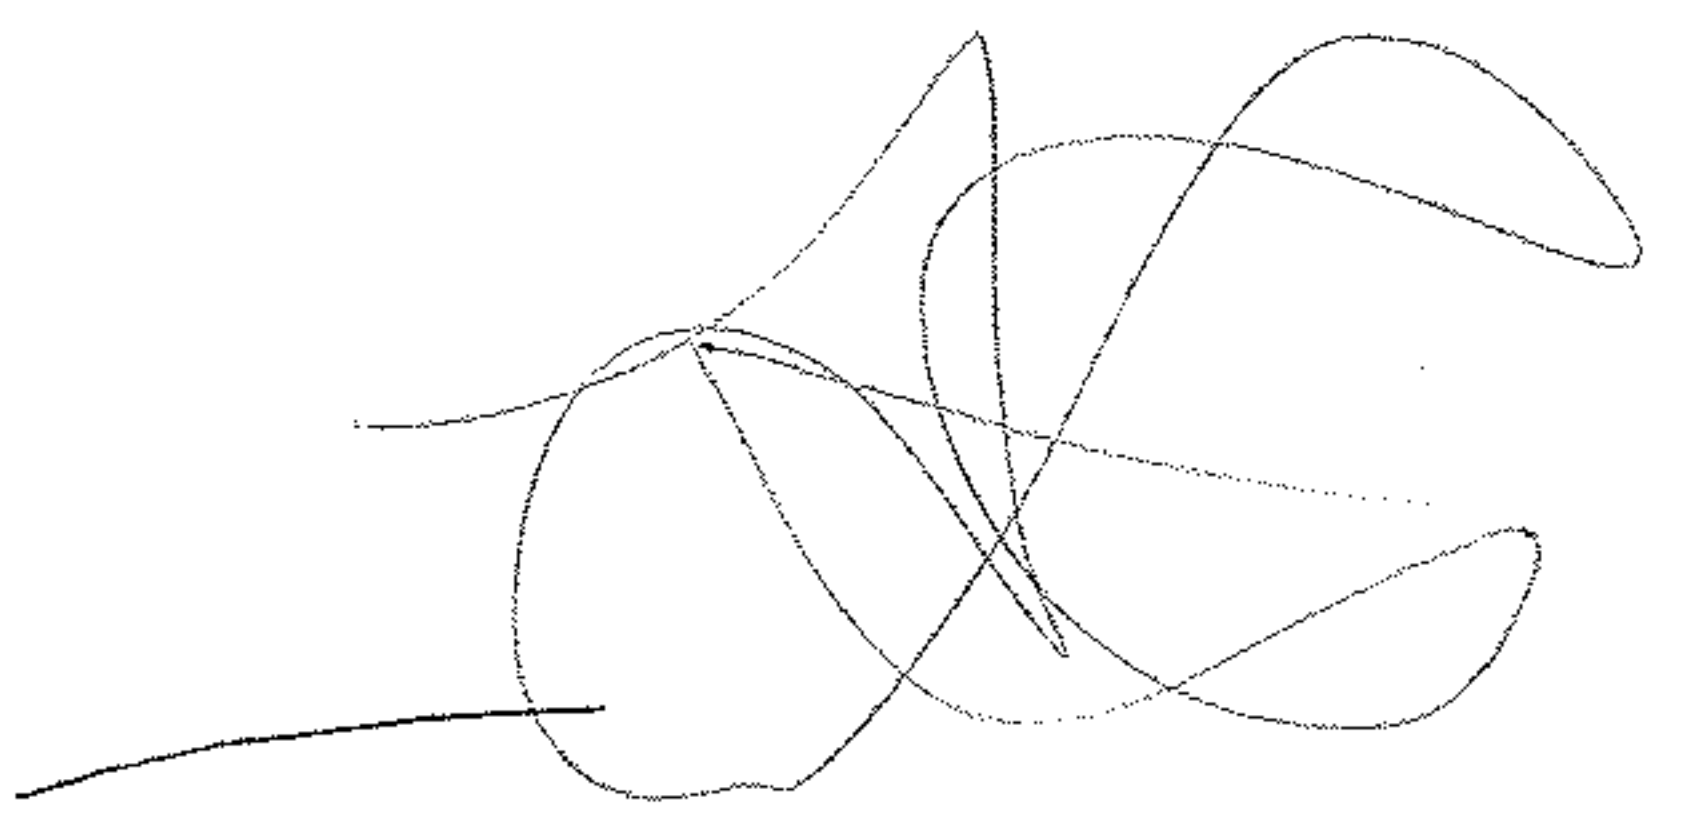

TURNPIKE

125

125

90

211.27

40

5493