


5498

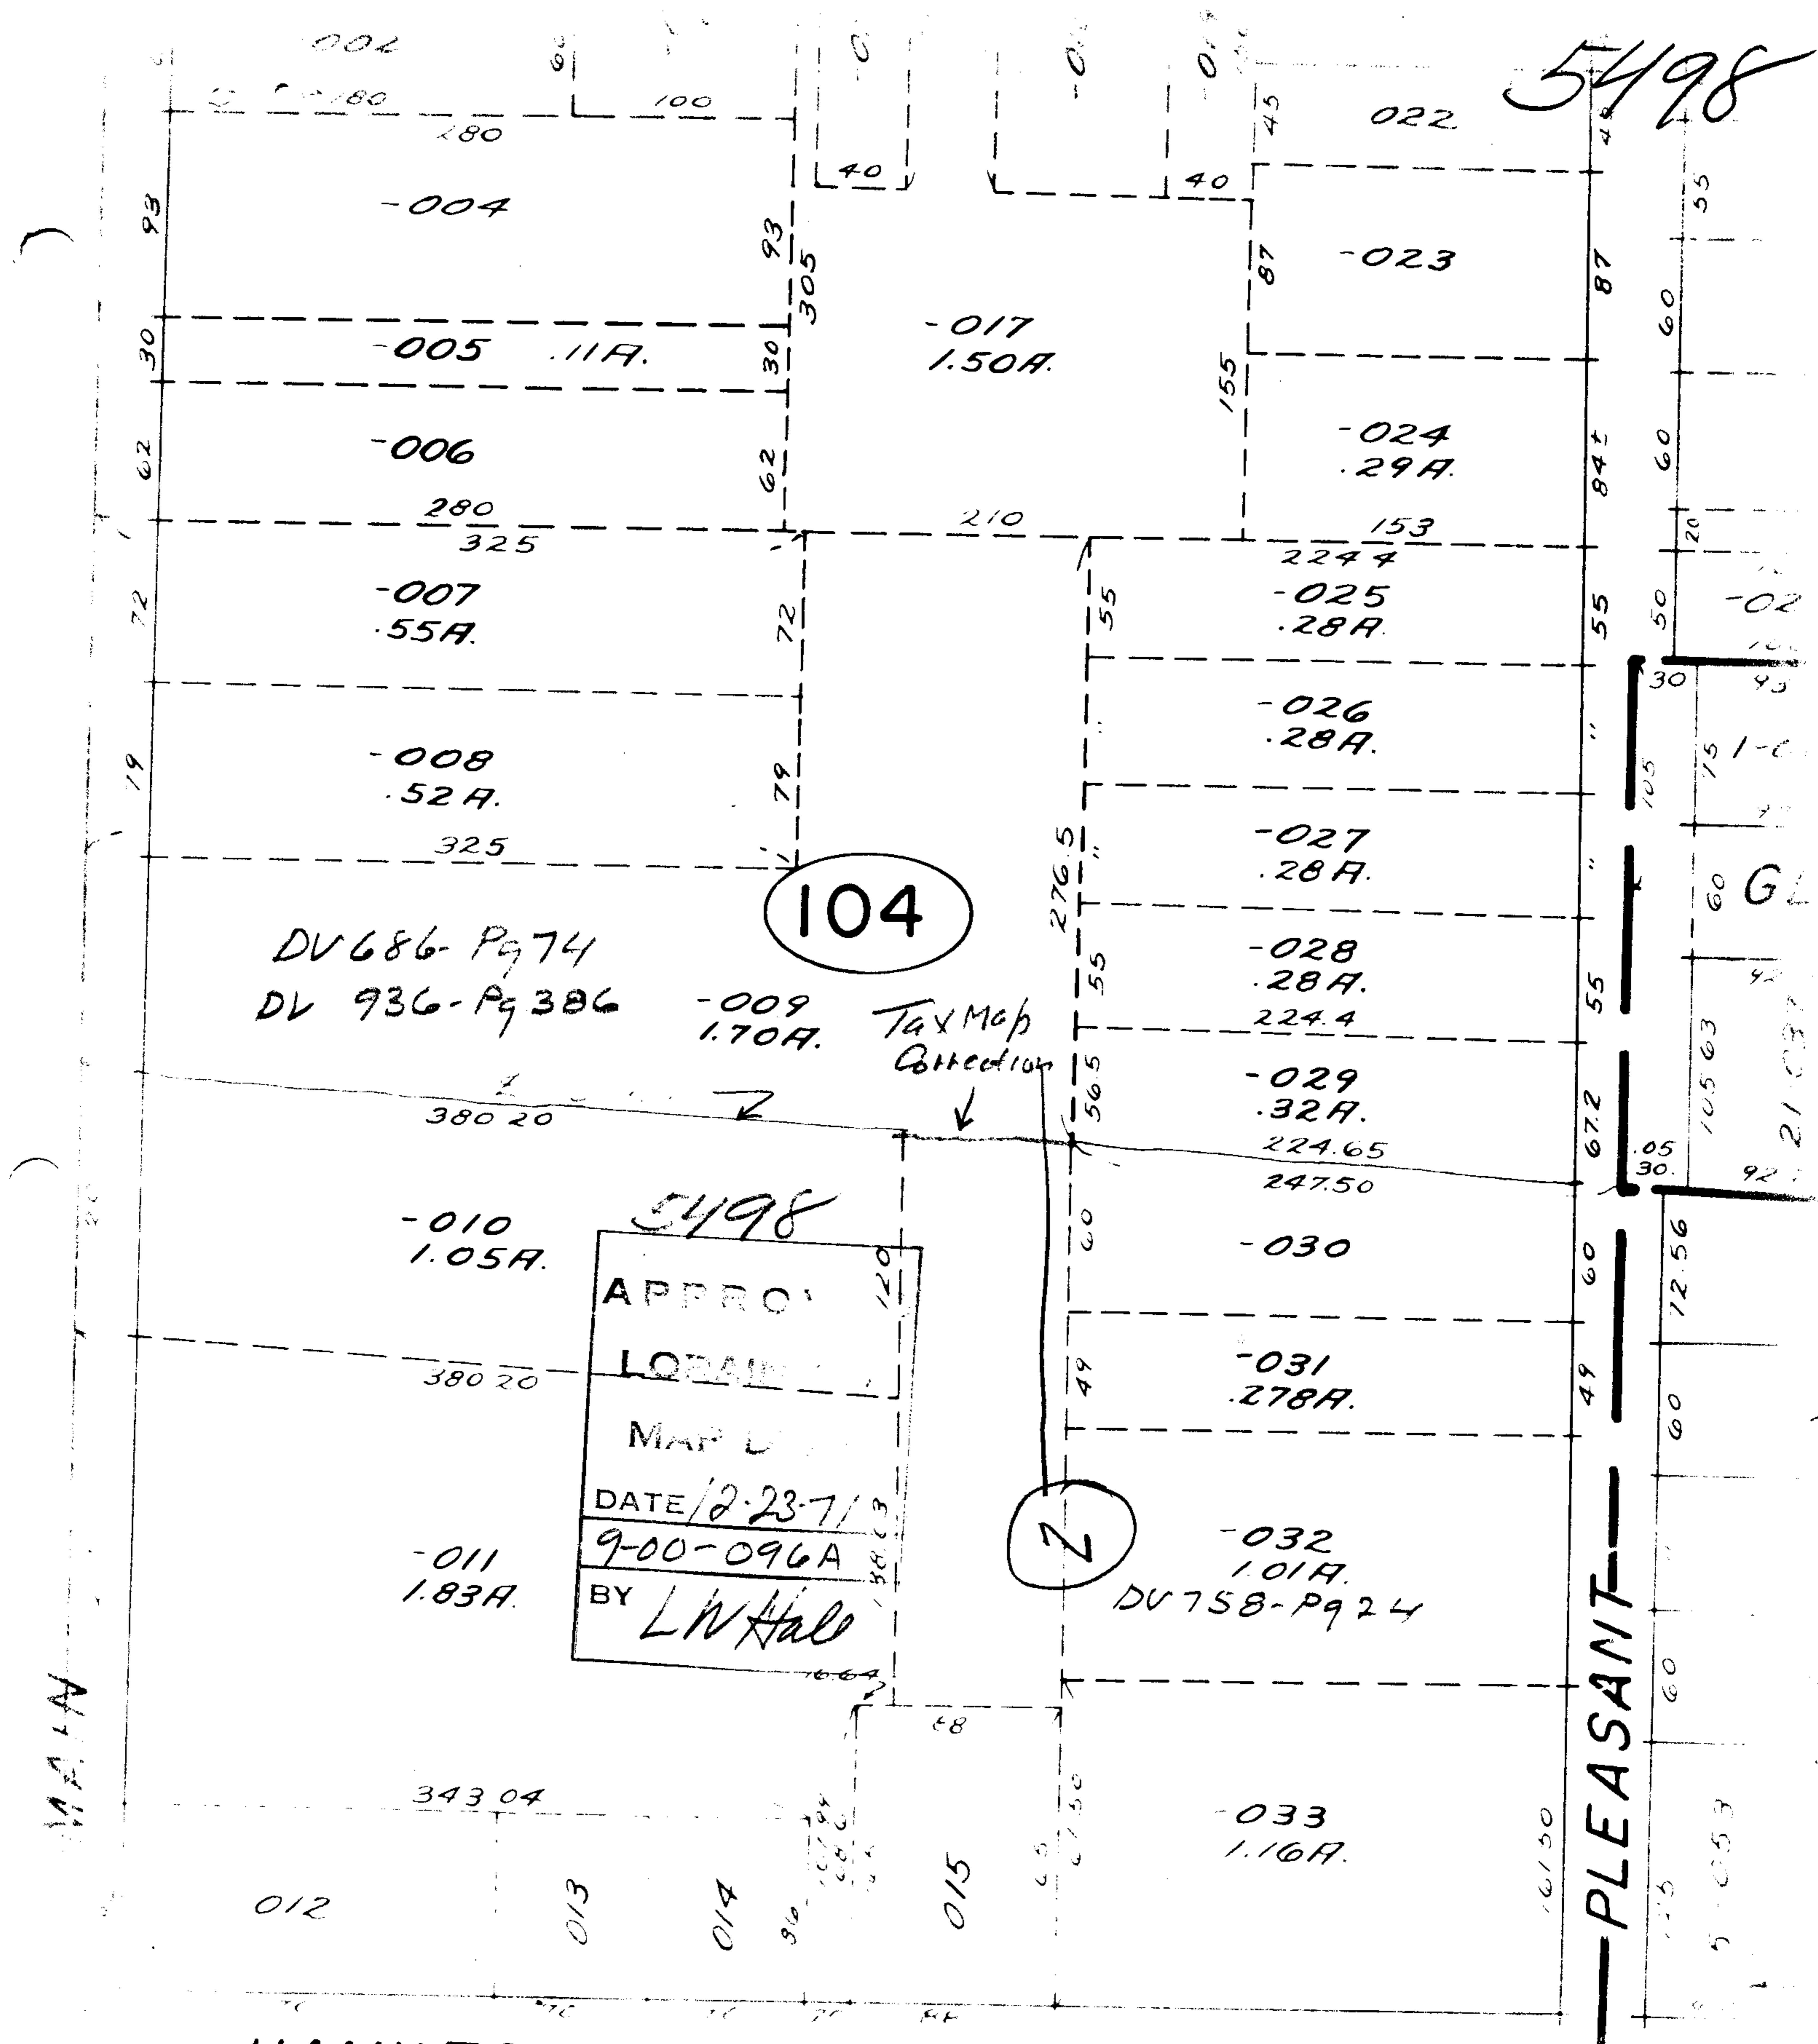

104

DV 686-Pg 74  
DV 936-Pg 386

-009  
1.70A. Tax Map Correction

5498

APPROXIMATE  
LOBBY  
MAP  
DATE 12-23-71  
9-00-096A  
BY L.W. Hall

2

HAMILTON

PLEASANT

Map Correction 9-00-096A

SEE 9-00-100

