

R. R.

-026 B

MAR 10 1950

50

APPROVED

LORAIN CO.

MAP DEPT.

DATE 2/28/71

1-00-023-B

BY R. H. Kelly

5500

-007

577.39
577.43

7-621-58
S.S

01-00-023-000-005
~~PT 01-00-026-000-016~~

PT. 2179 A.
9.62

Changed Part # to
fit lot.

47.38
786.51

#2


696.62

PT 01-00-024-000

9.

1

1937 75789

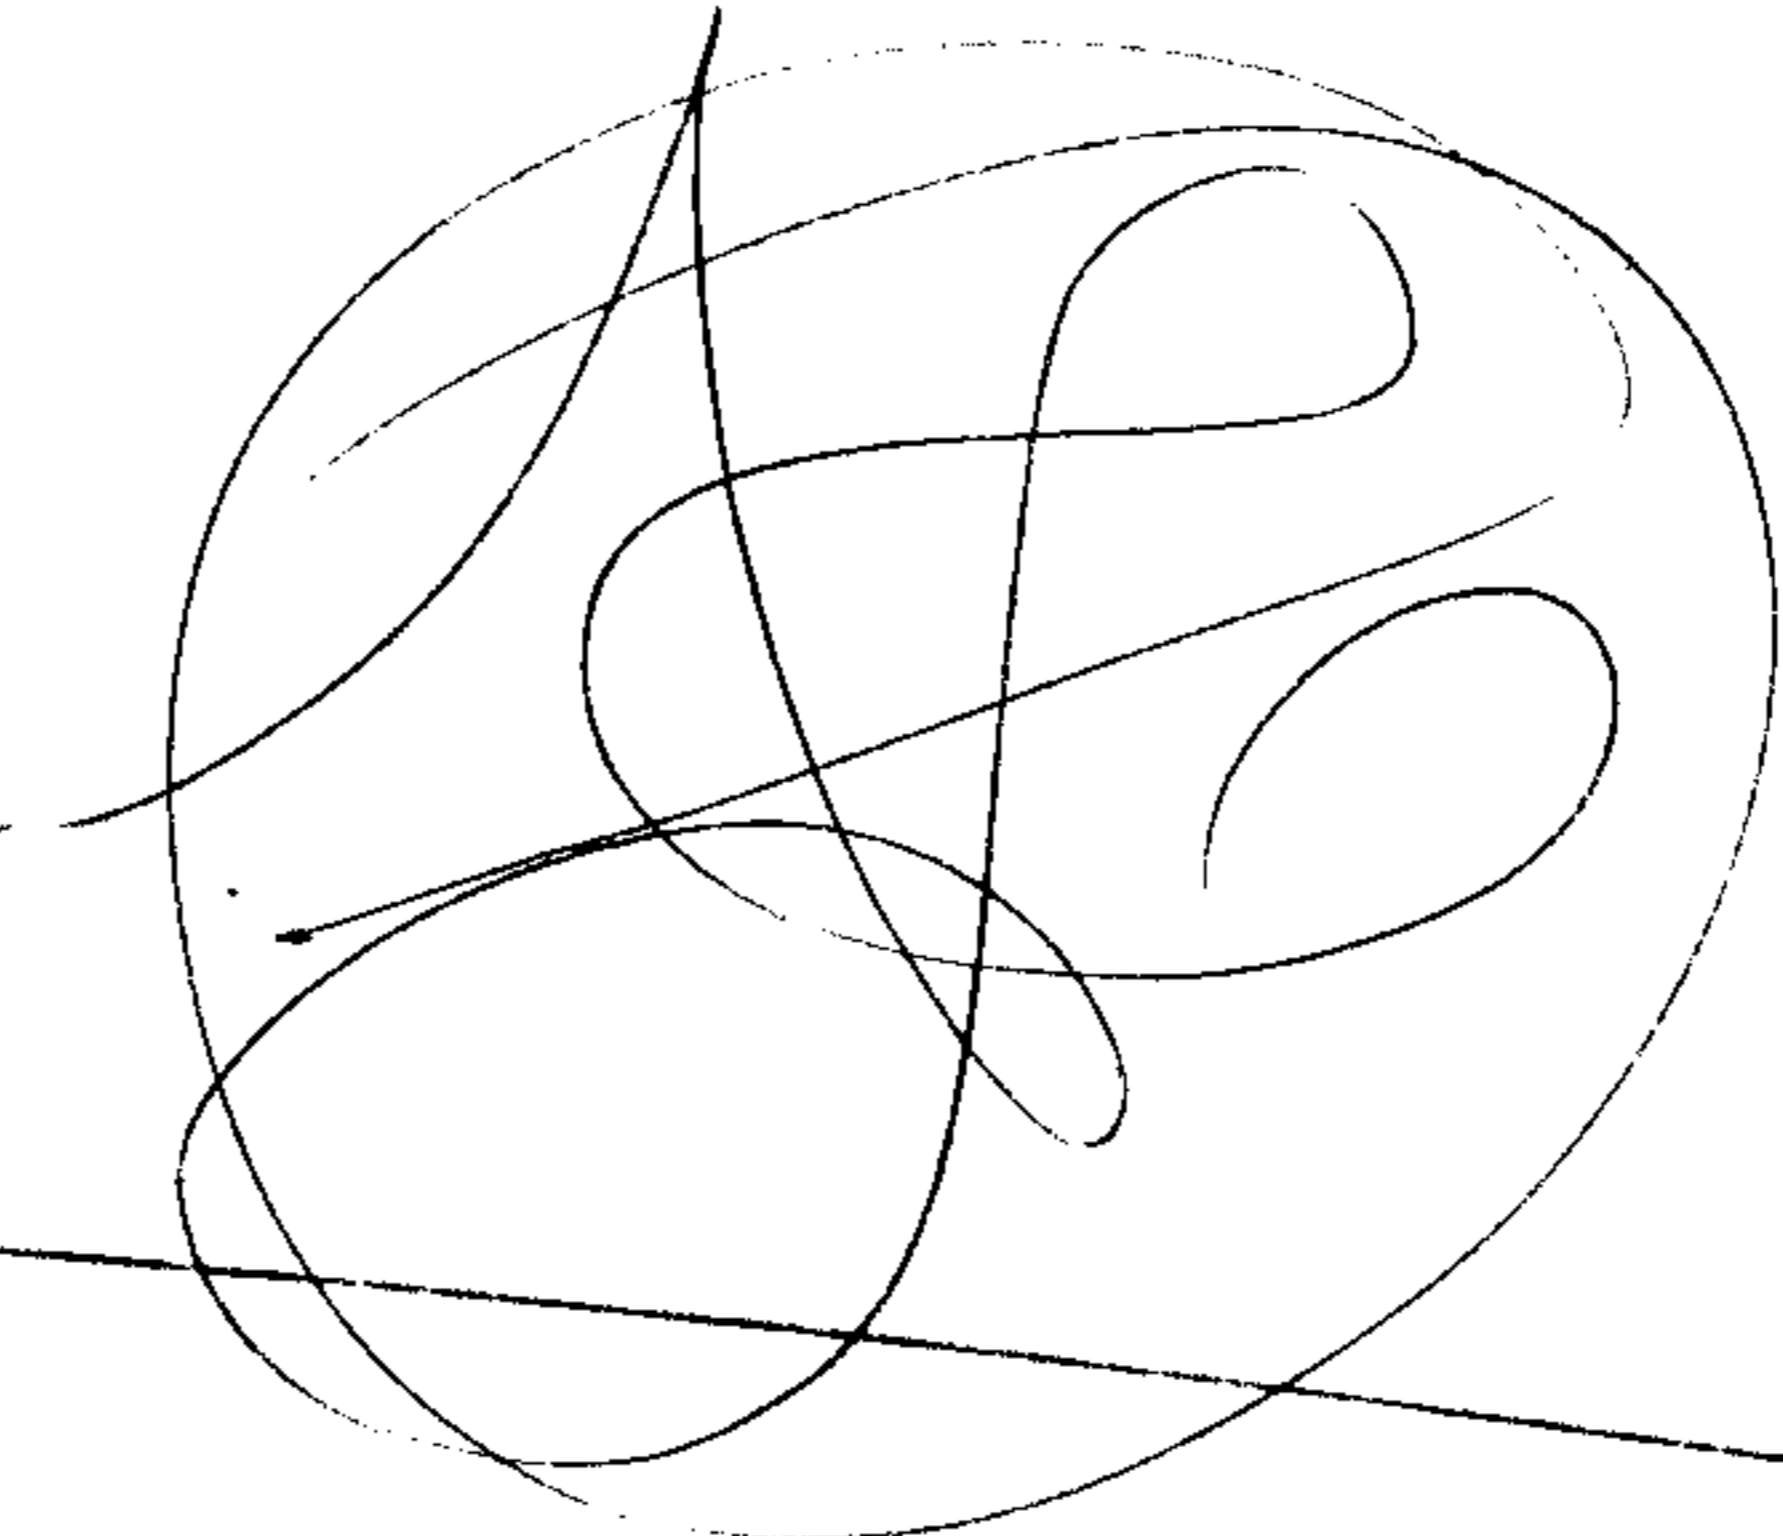

↑
2179
↓

↑
↓

584.62

STER PARK

83.37

3526
60

01-00-024-004

587.63
587.99

.47A

588.30
588.84

PT 01-00-026-000-015

PT 3.39 A.

RD

881.41



see Page - 026 B, etc 2179 - 024-11.70