


5503

APPROVED
LORAIN CO.
MAP DEPT.
DATE 12-27-71
7-00-047-C
BY <i>Holler</i>

7-18-86 L.L.

MAR 17 ENT'D

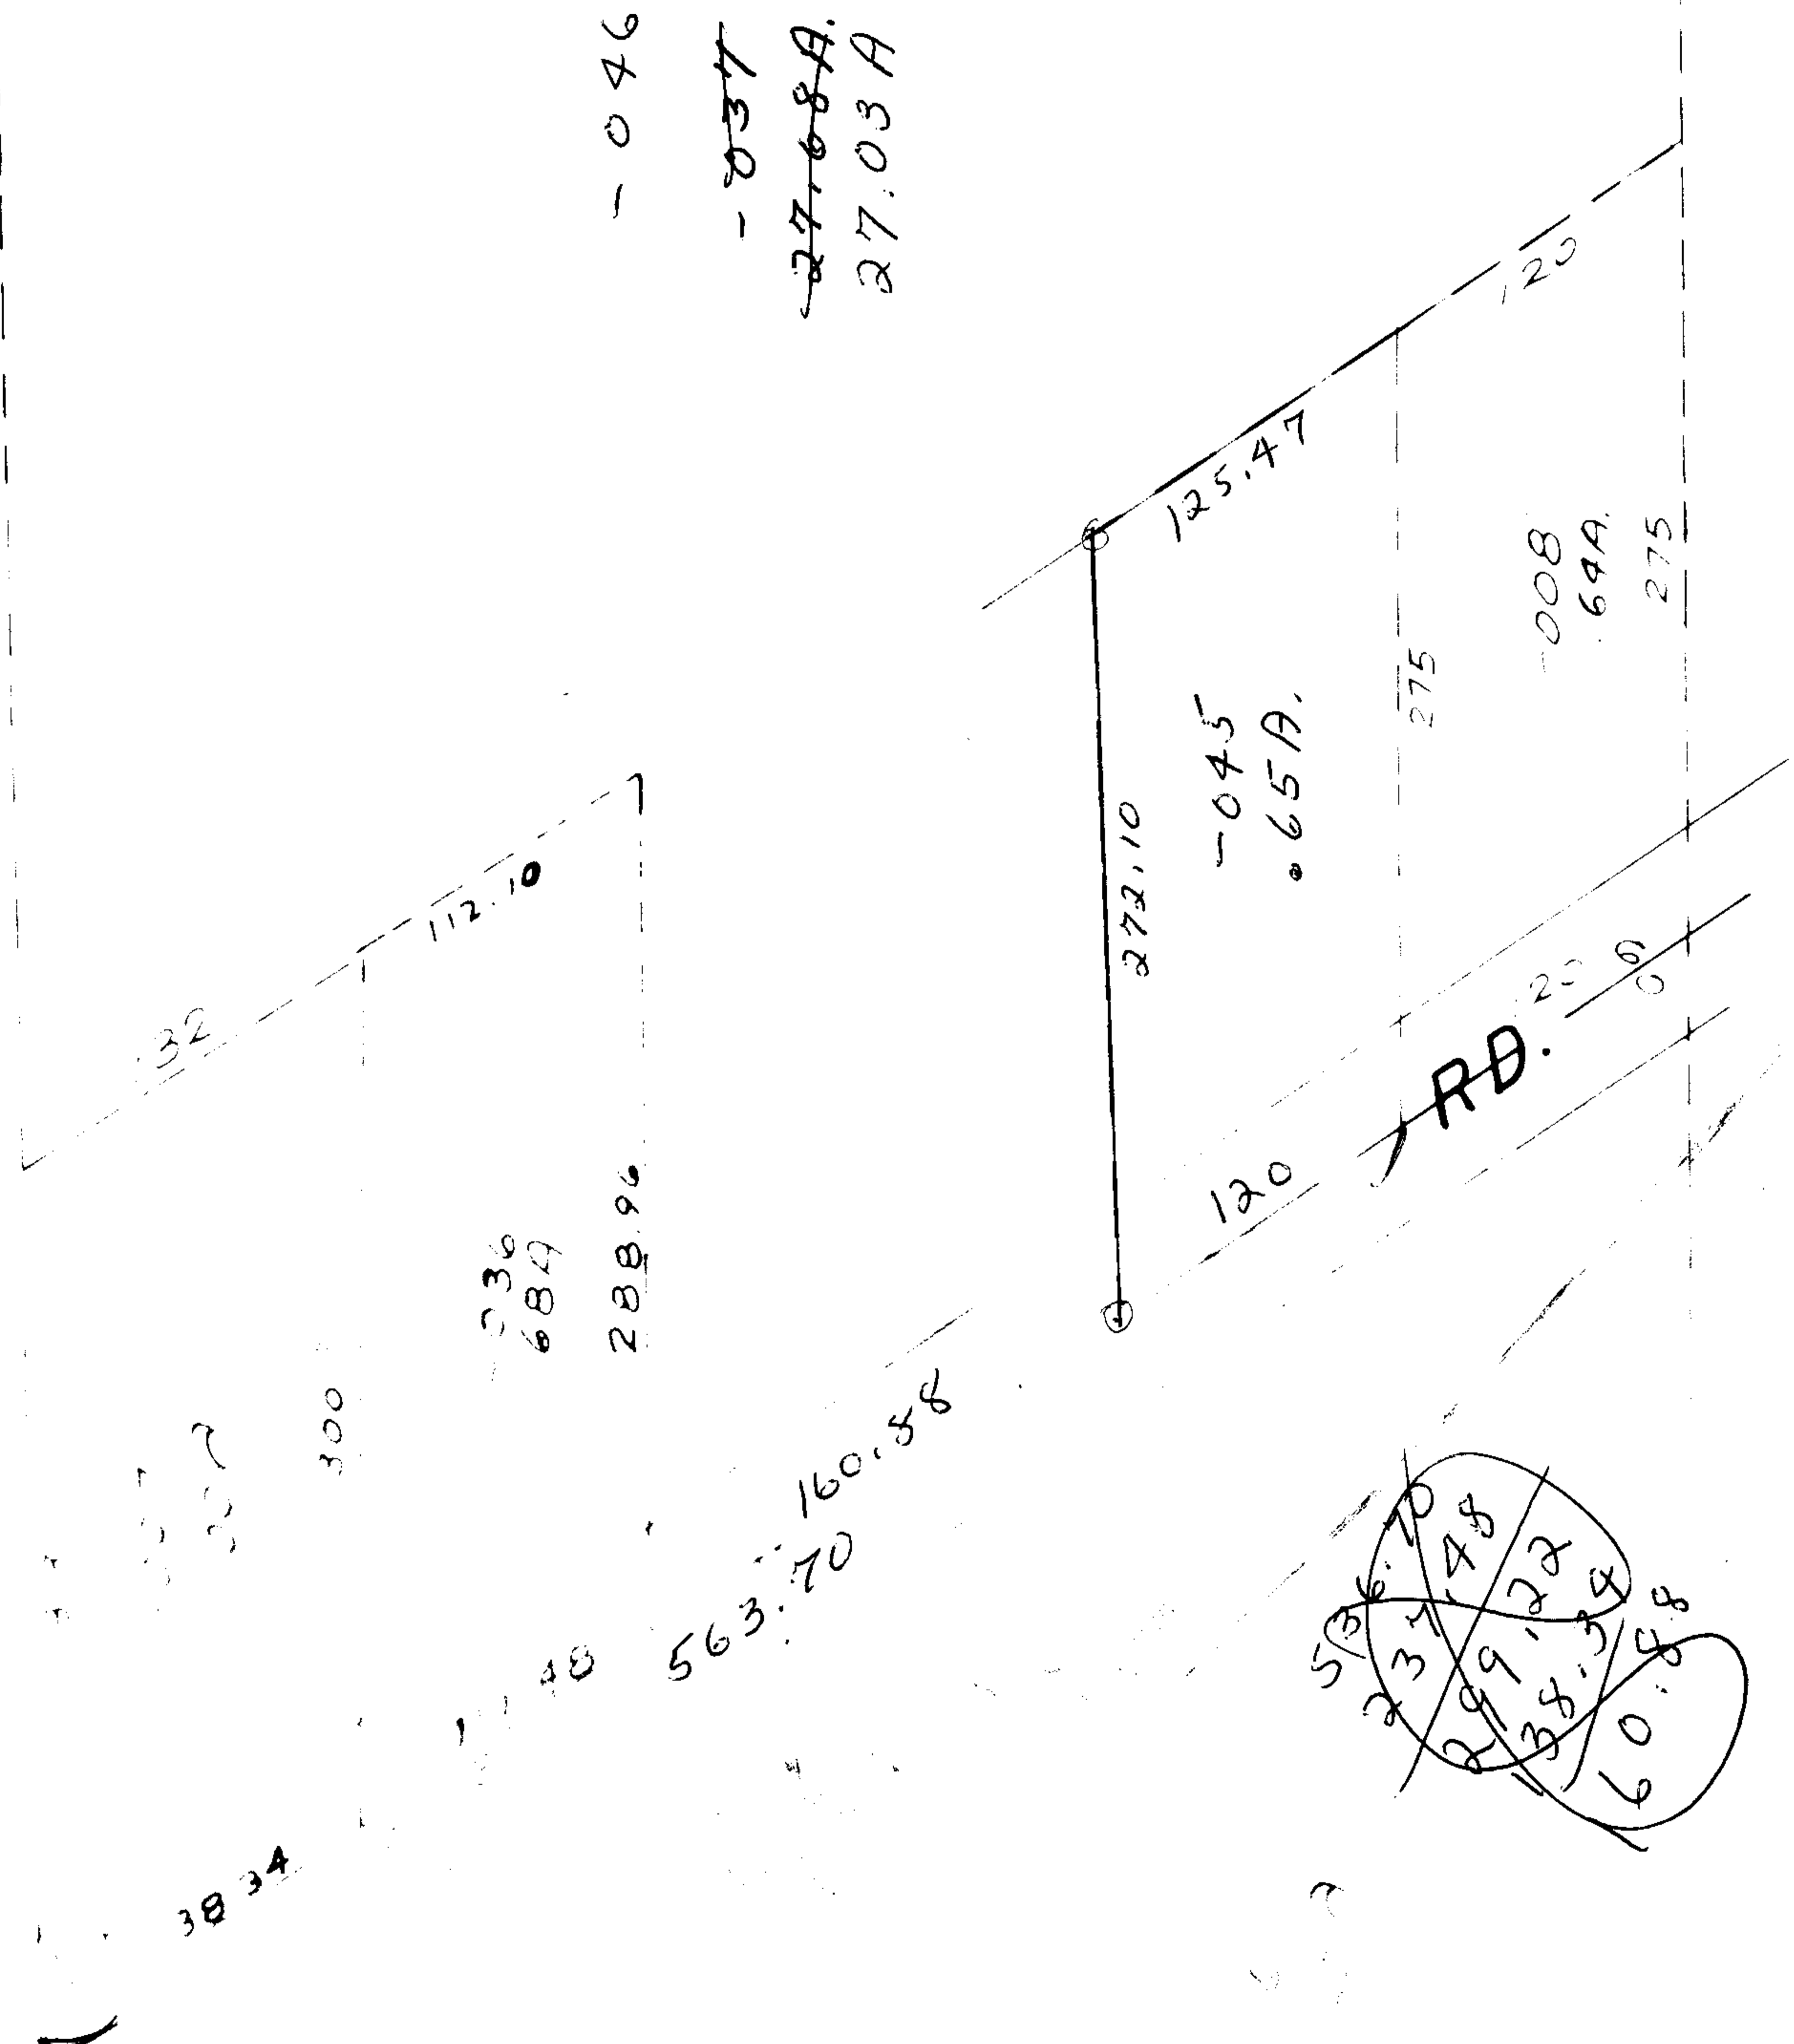

-046
~~27.68A.~~
 27.03A

5503