


16-00-073-000-008
017

Map Correction 16-H.

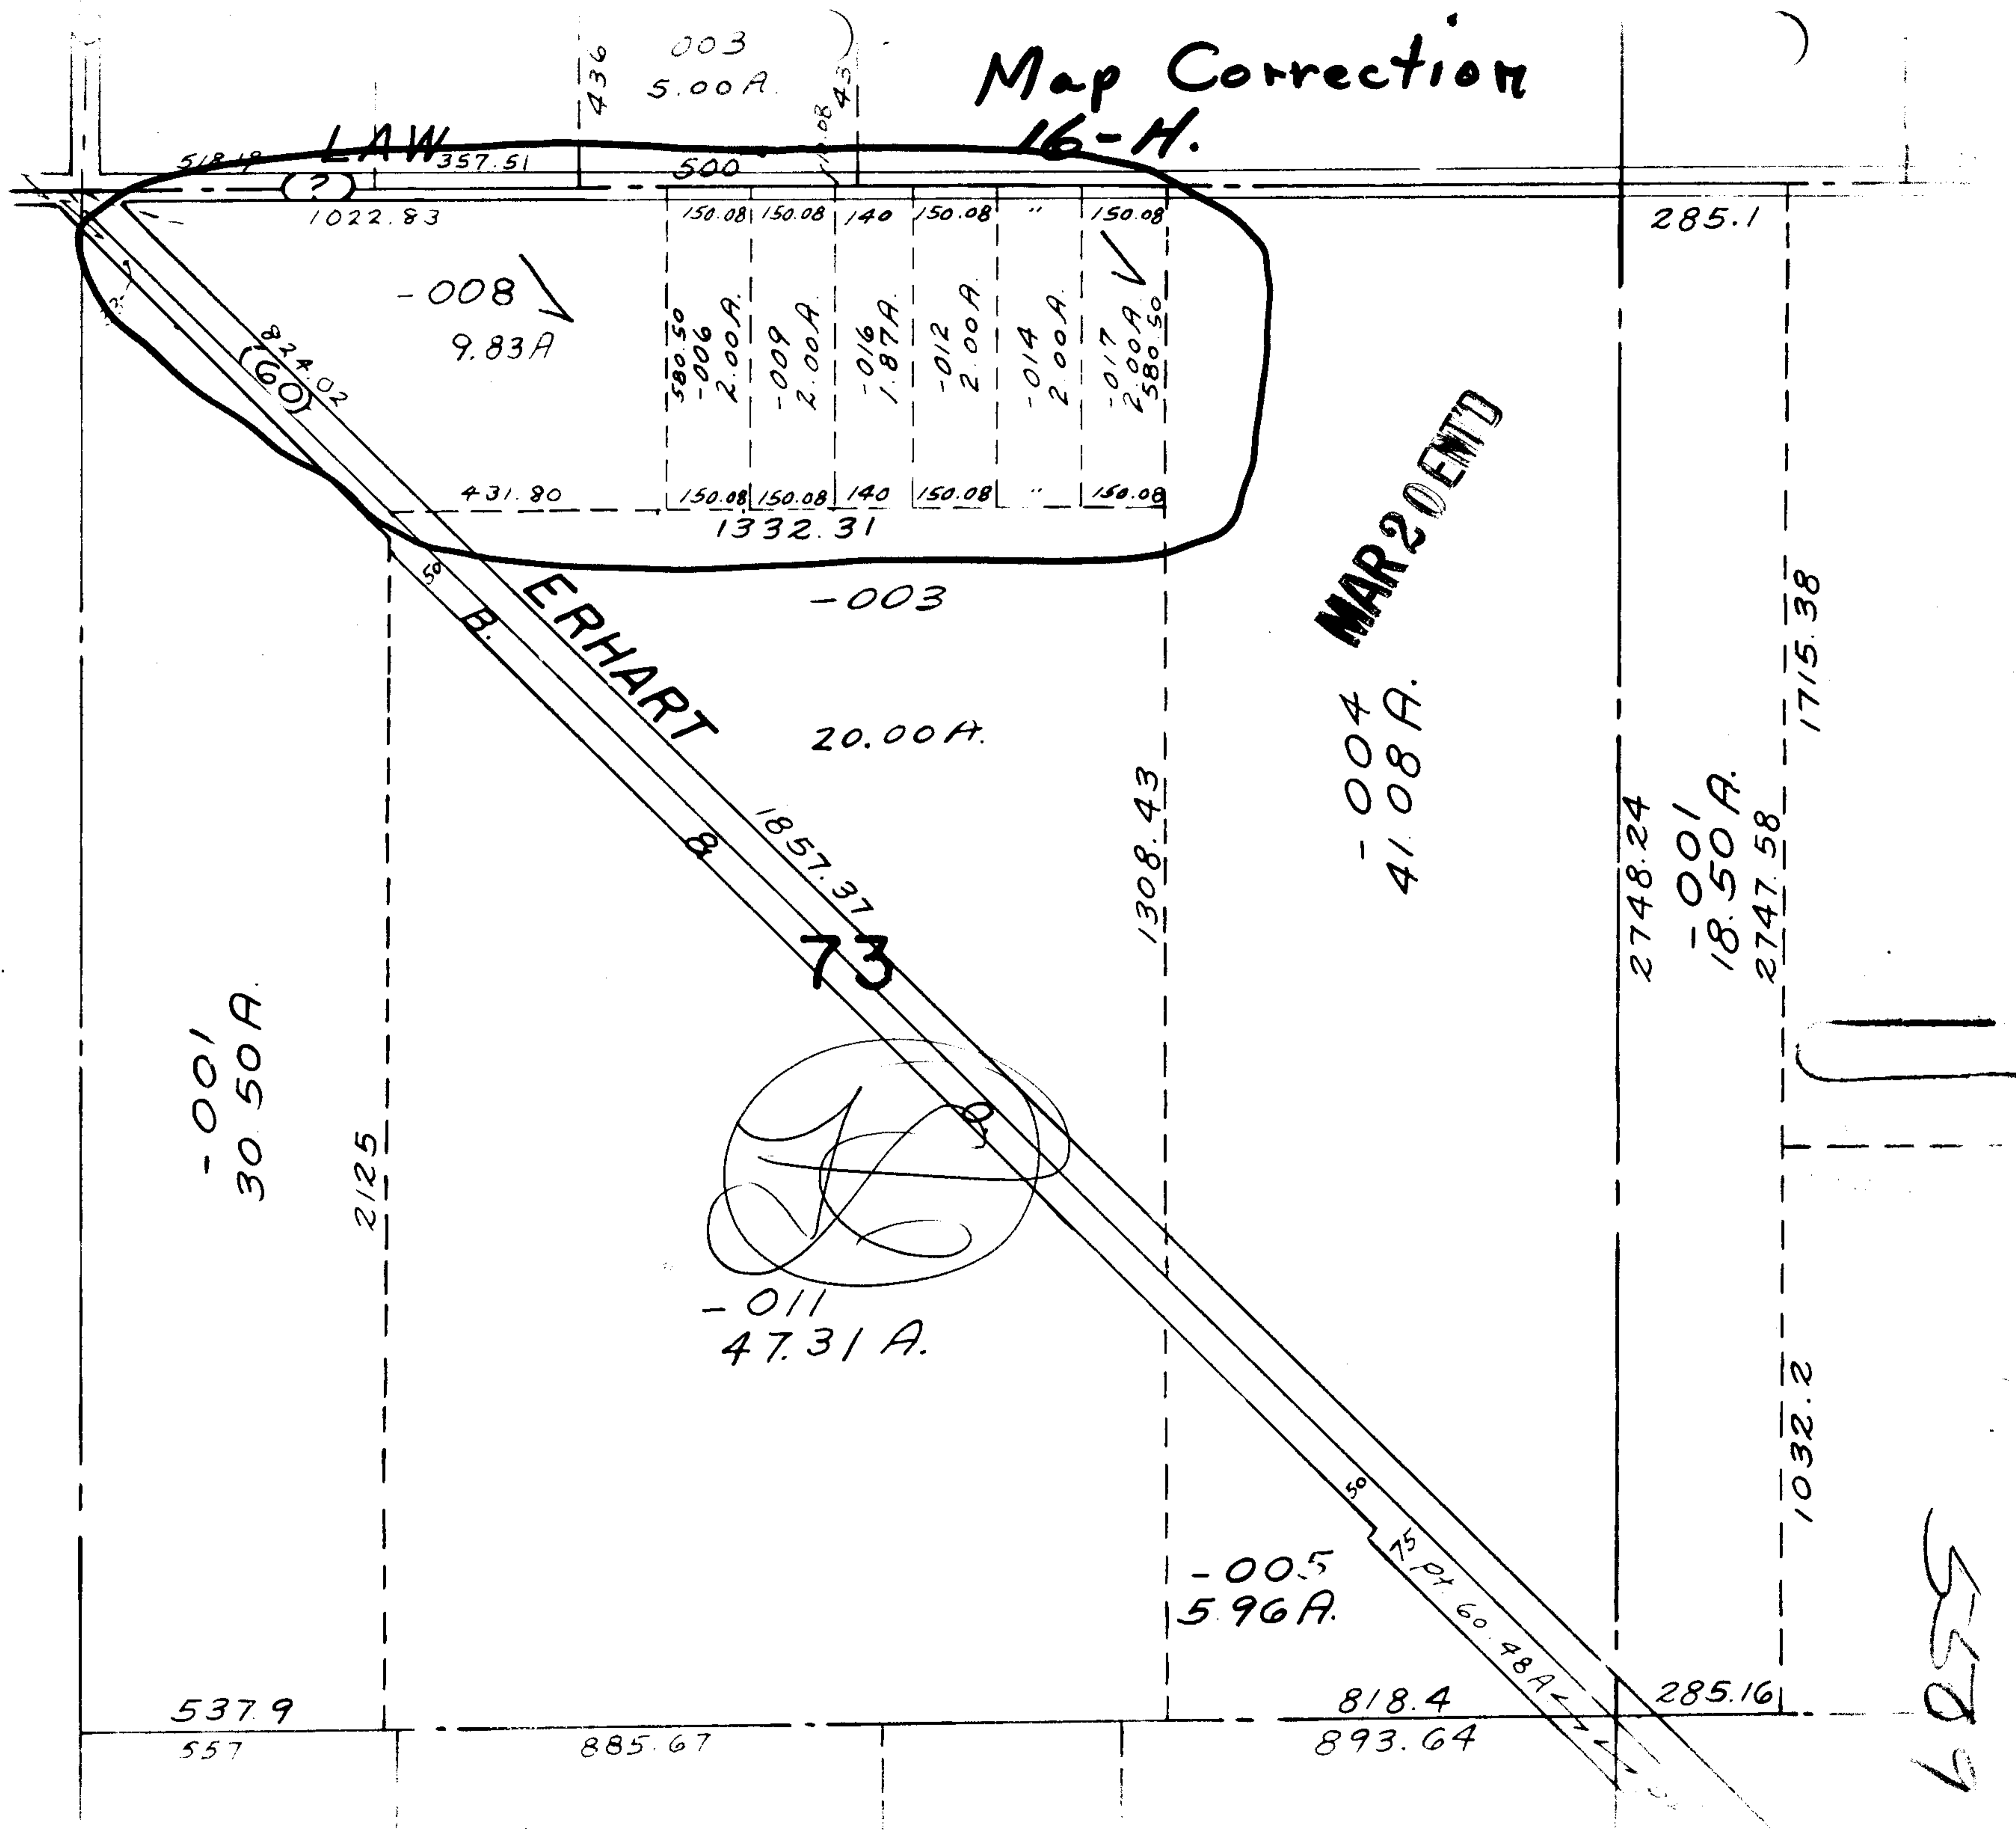

6255