



5513

SEE 11-00-046-A

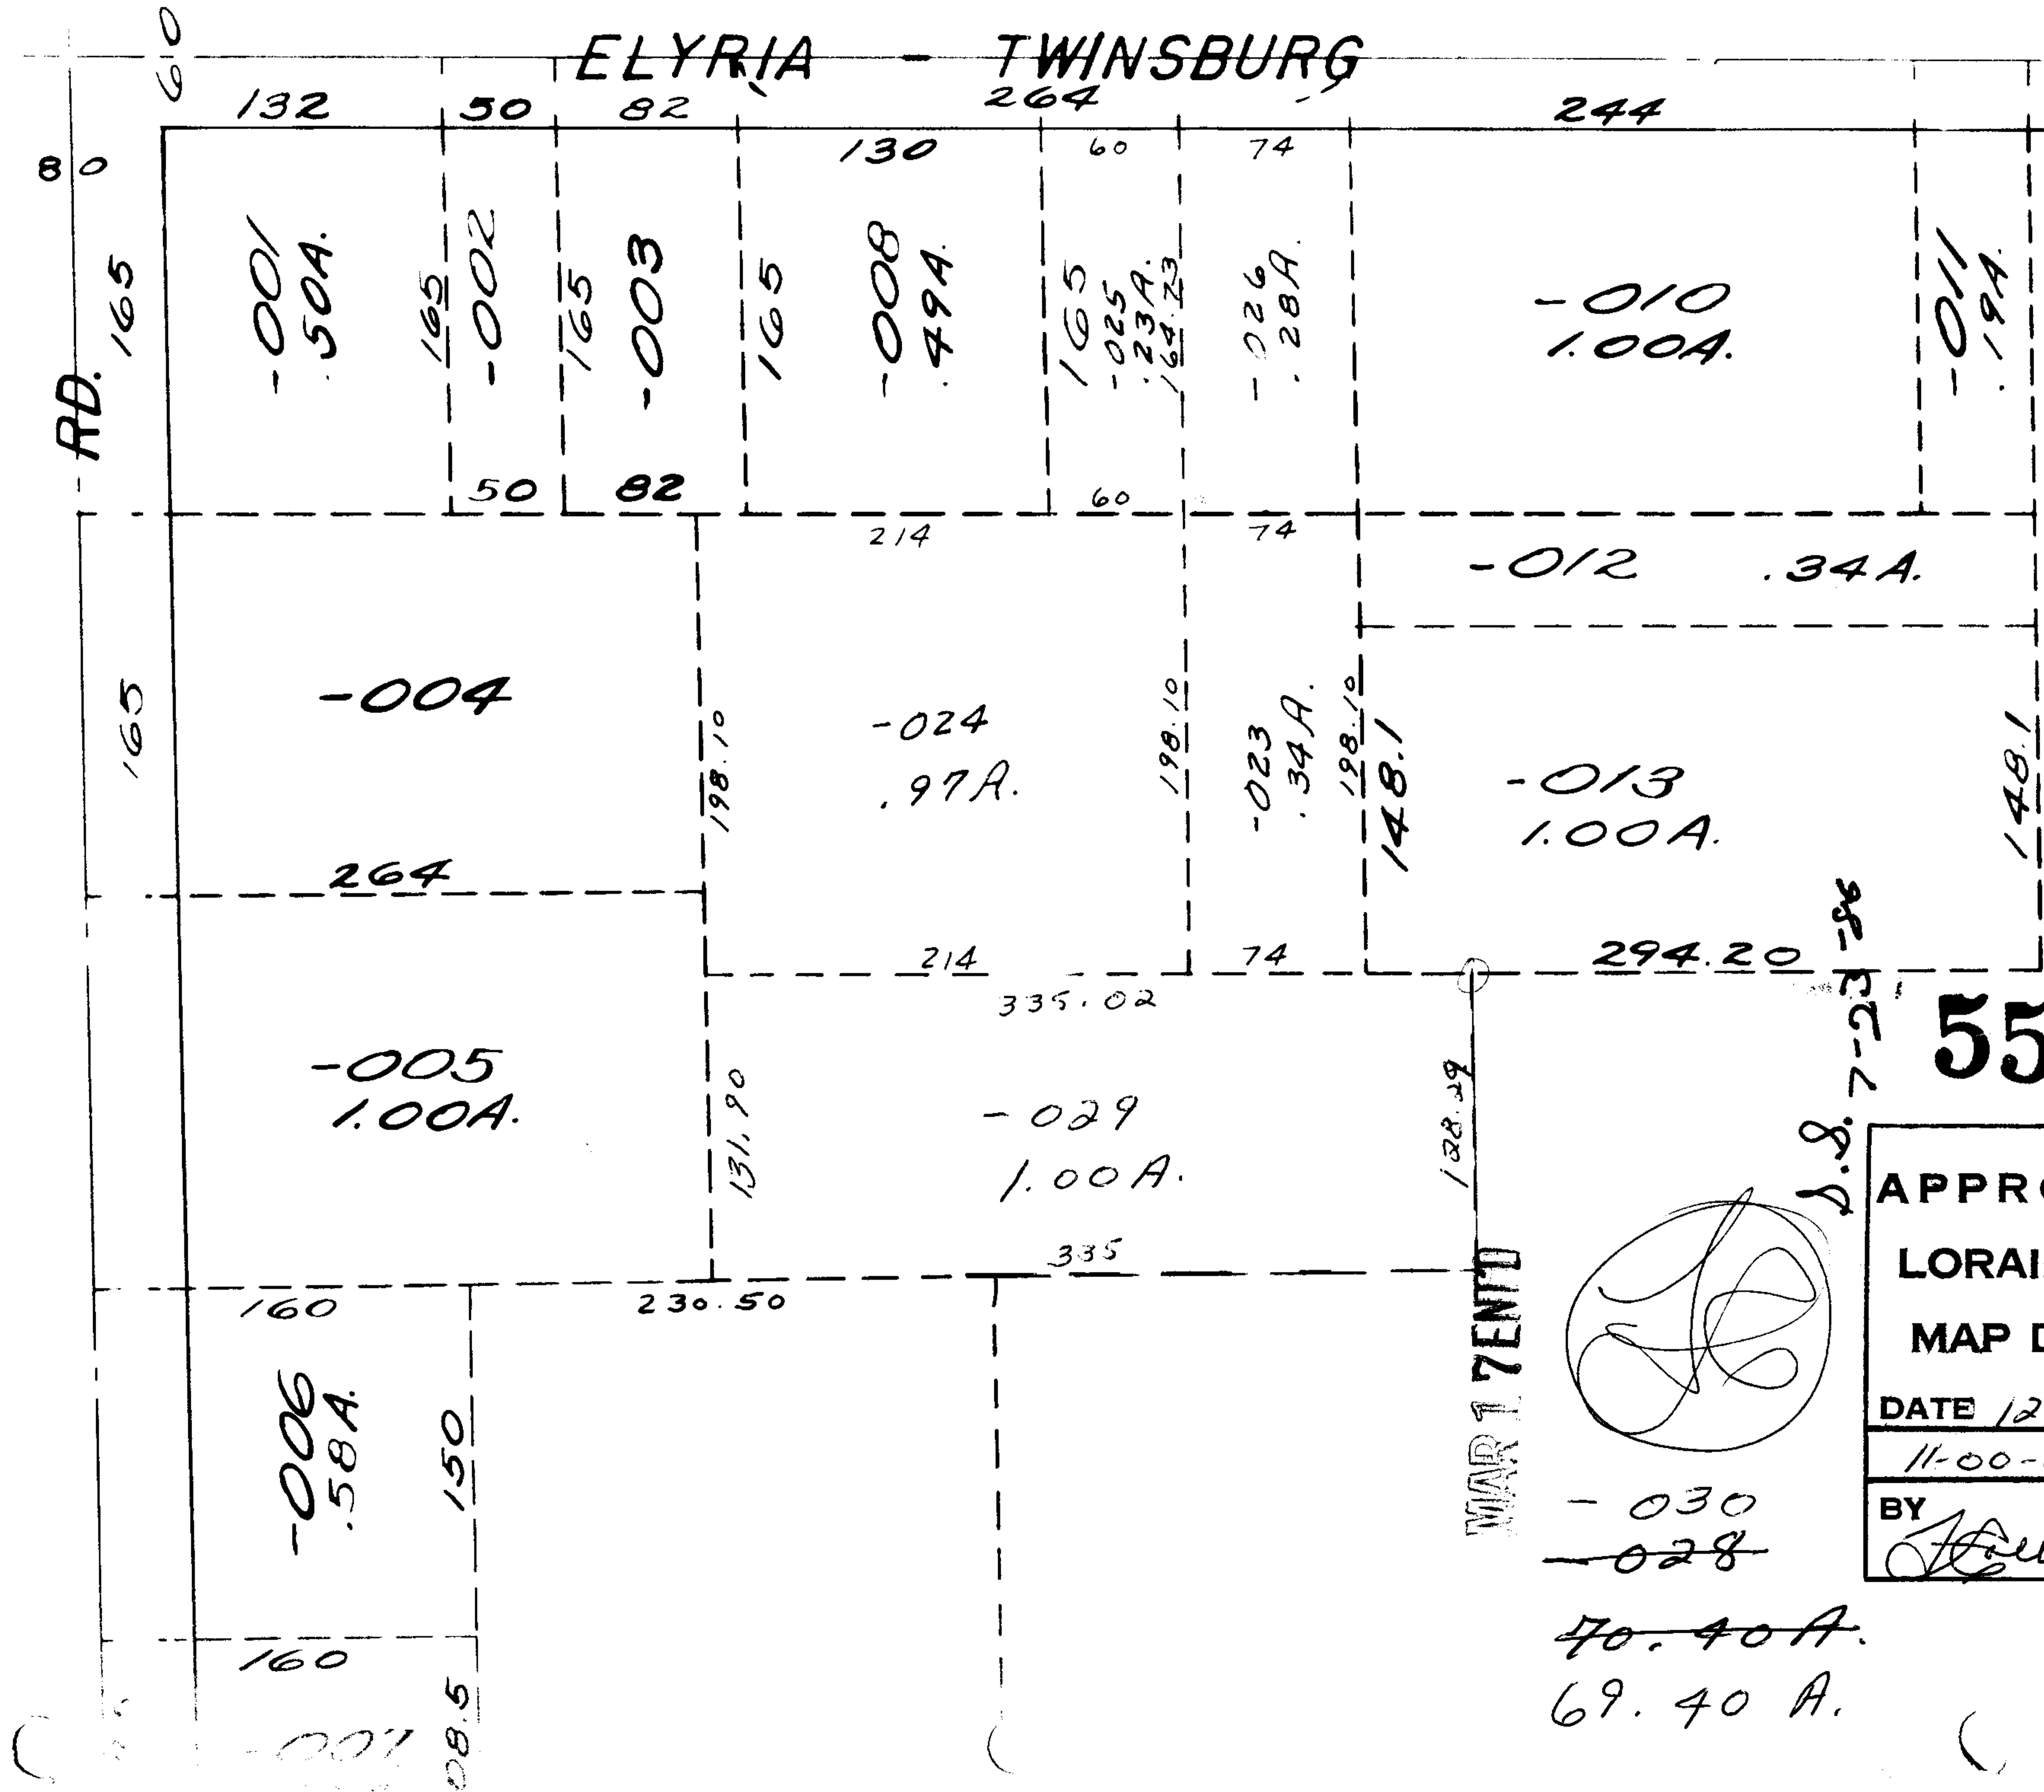

5513

APPROVED  
 LORAIN CO.  
 MAP DEPT.  
 DATE 12-29-71  
 11-00-045-A  
 BY *[Signature]*

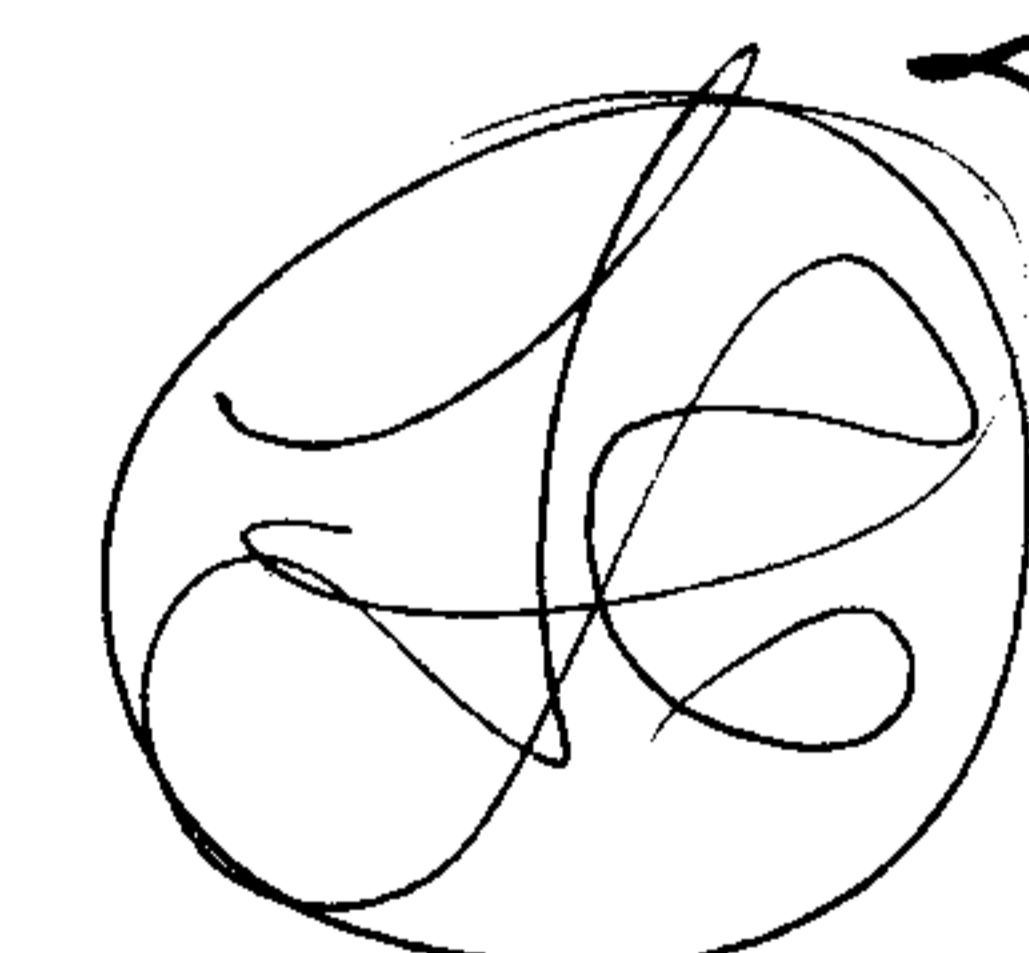

~~-028~~  
~~-030~~  
 70.40A.  
 69.40A.

D.S. 7-23-86