

5524

-001
6.35 A.

-008
~~-002~~
40.25 A.
38.66

RD.

192
-003
.86 A.
195
-007
1.59 A.
356.76

8


22

~~002~~
~~67.47 A.~~

996.78 (60)

350
-005
2.53 A.
308.56

T

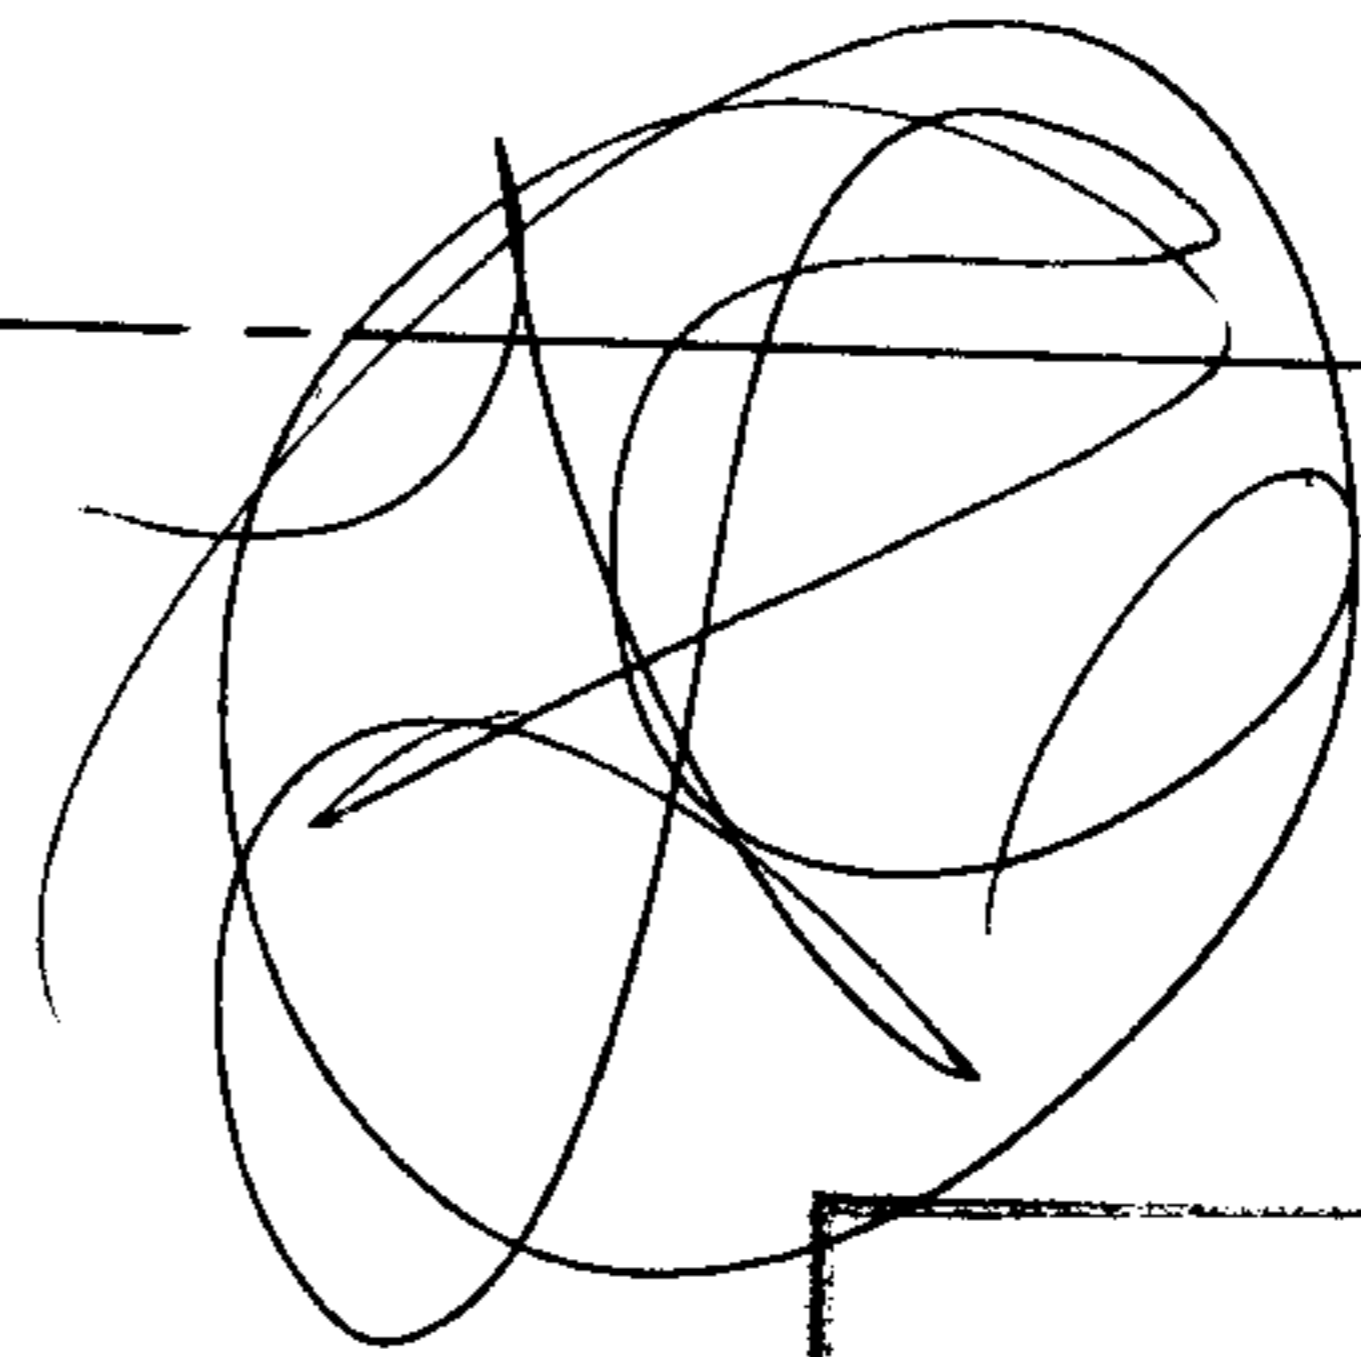

MAR 20 ENT'D

-001
60.00 A.

APPROVED
LORAIN CO.
MAP DEPT.
DATE 1/3/72
17-B
BY R.V. Ketting

7-28-81

N

C

A

27