

5535

544.89

40.44

454.81

-022

6.05 A.

430.54

-008

3.77 A.

430.54

502.96

398.25

362

-006

45.21 A.

949.07

435

22

522.71

-029

~~32~~

~~50.95~~

50.95

-028

4.23 A.

422.53

517.11

-026

5.00 A.

574.29

750.53

233

-015

188.8

133

100


MAR 17 ENT'D

-009

117.00 A

APPROVED  
 LORAIN CO.  
 MAP DEPT.  
 DATE 1/6/72  
 BY R. V. Kelling

PARSONS

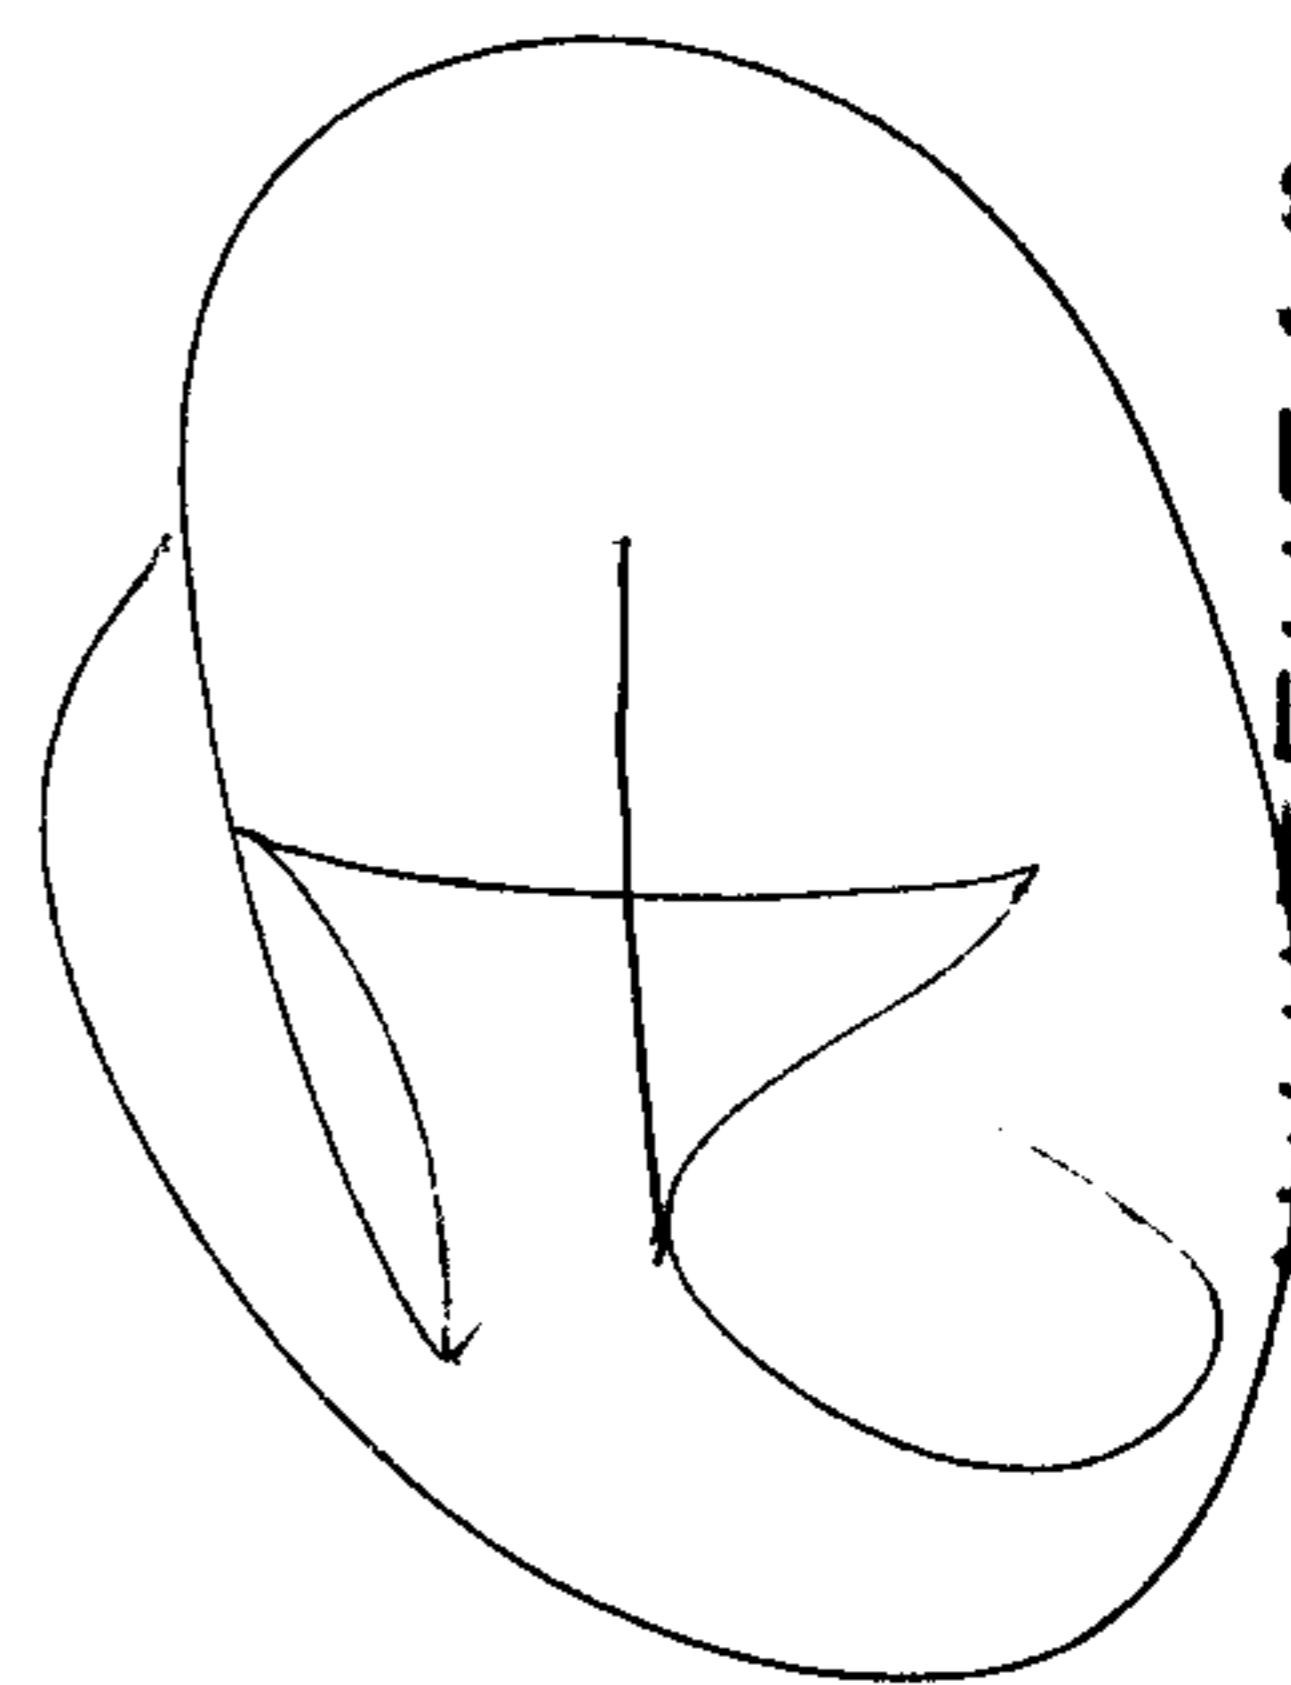

WHITEHEAD

95.0

-0

Q