

5568

5569

St. Louis
St. Louis

211.78

241.78

435

101

-022

17.17A

2706.95

~~34.34 A~~

17.17A

-023

-017

37.71A

2702.90

-005

36.97A

2700.00

23 ELYRIA

LATTASBURG


271.81 271.80

CARLISLE TWP

MAR 17 ENT'D

APPROVED
LORAIN CO.
MAP DEPT.
DATE 1/20/72
12-F
BY Pat. Kelling

1972
1-19-72

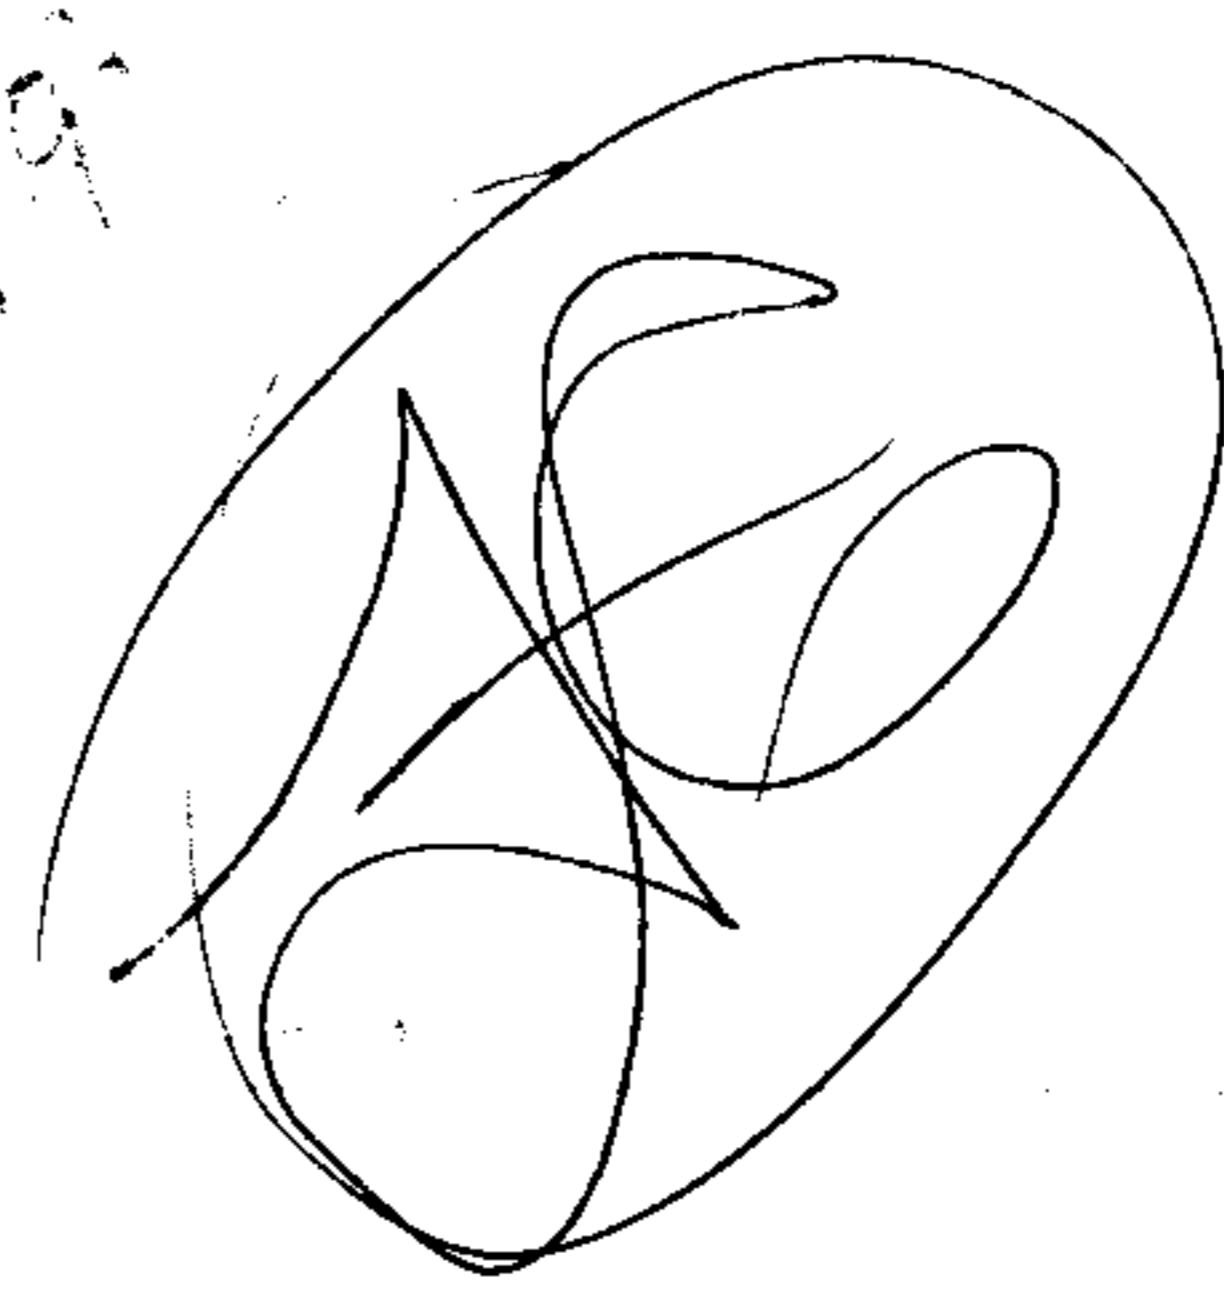

2401.0

RD.

Copyright