


5593

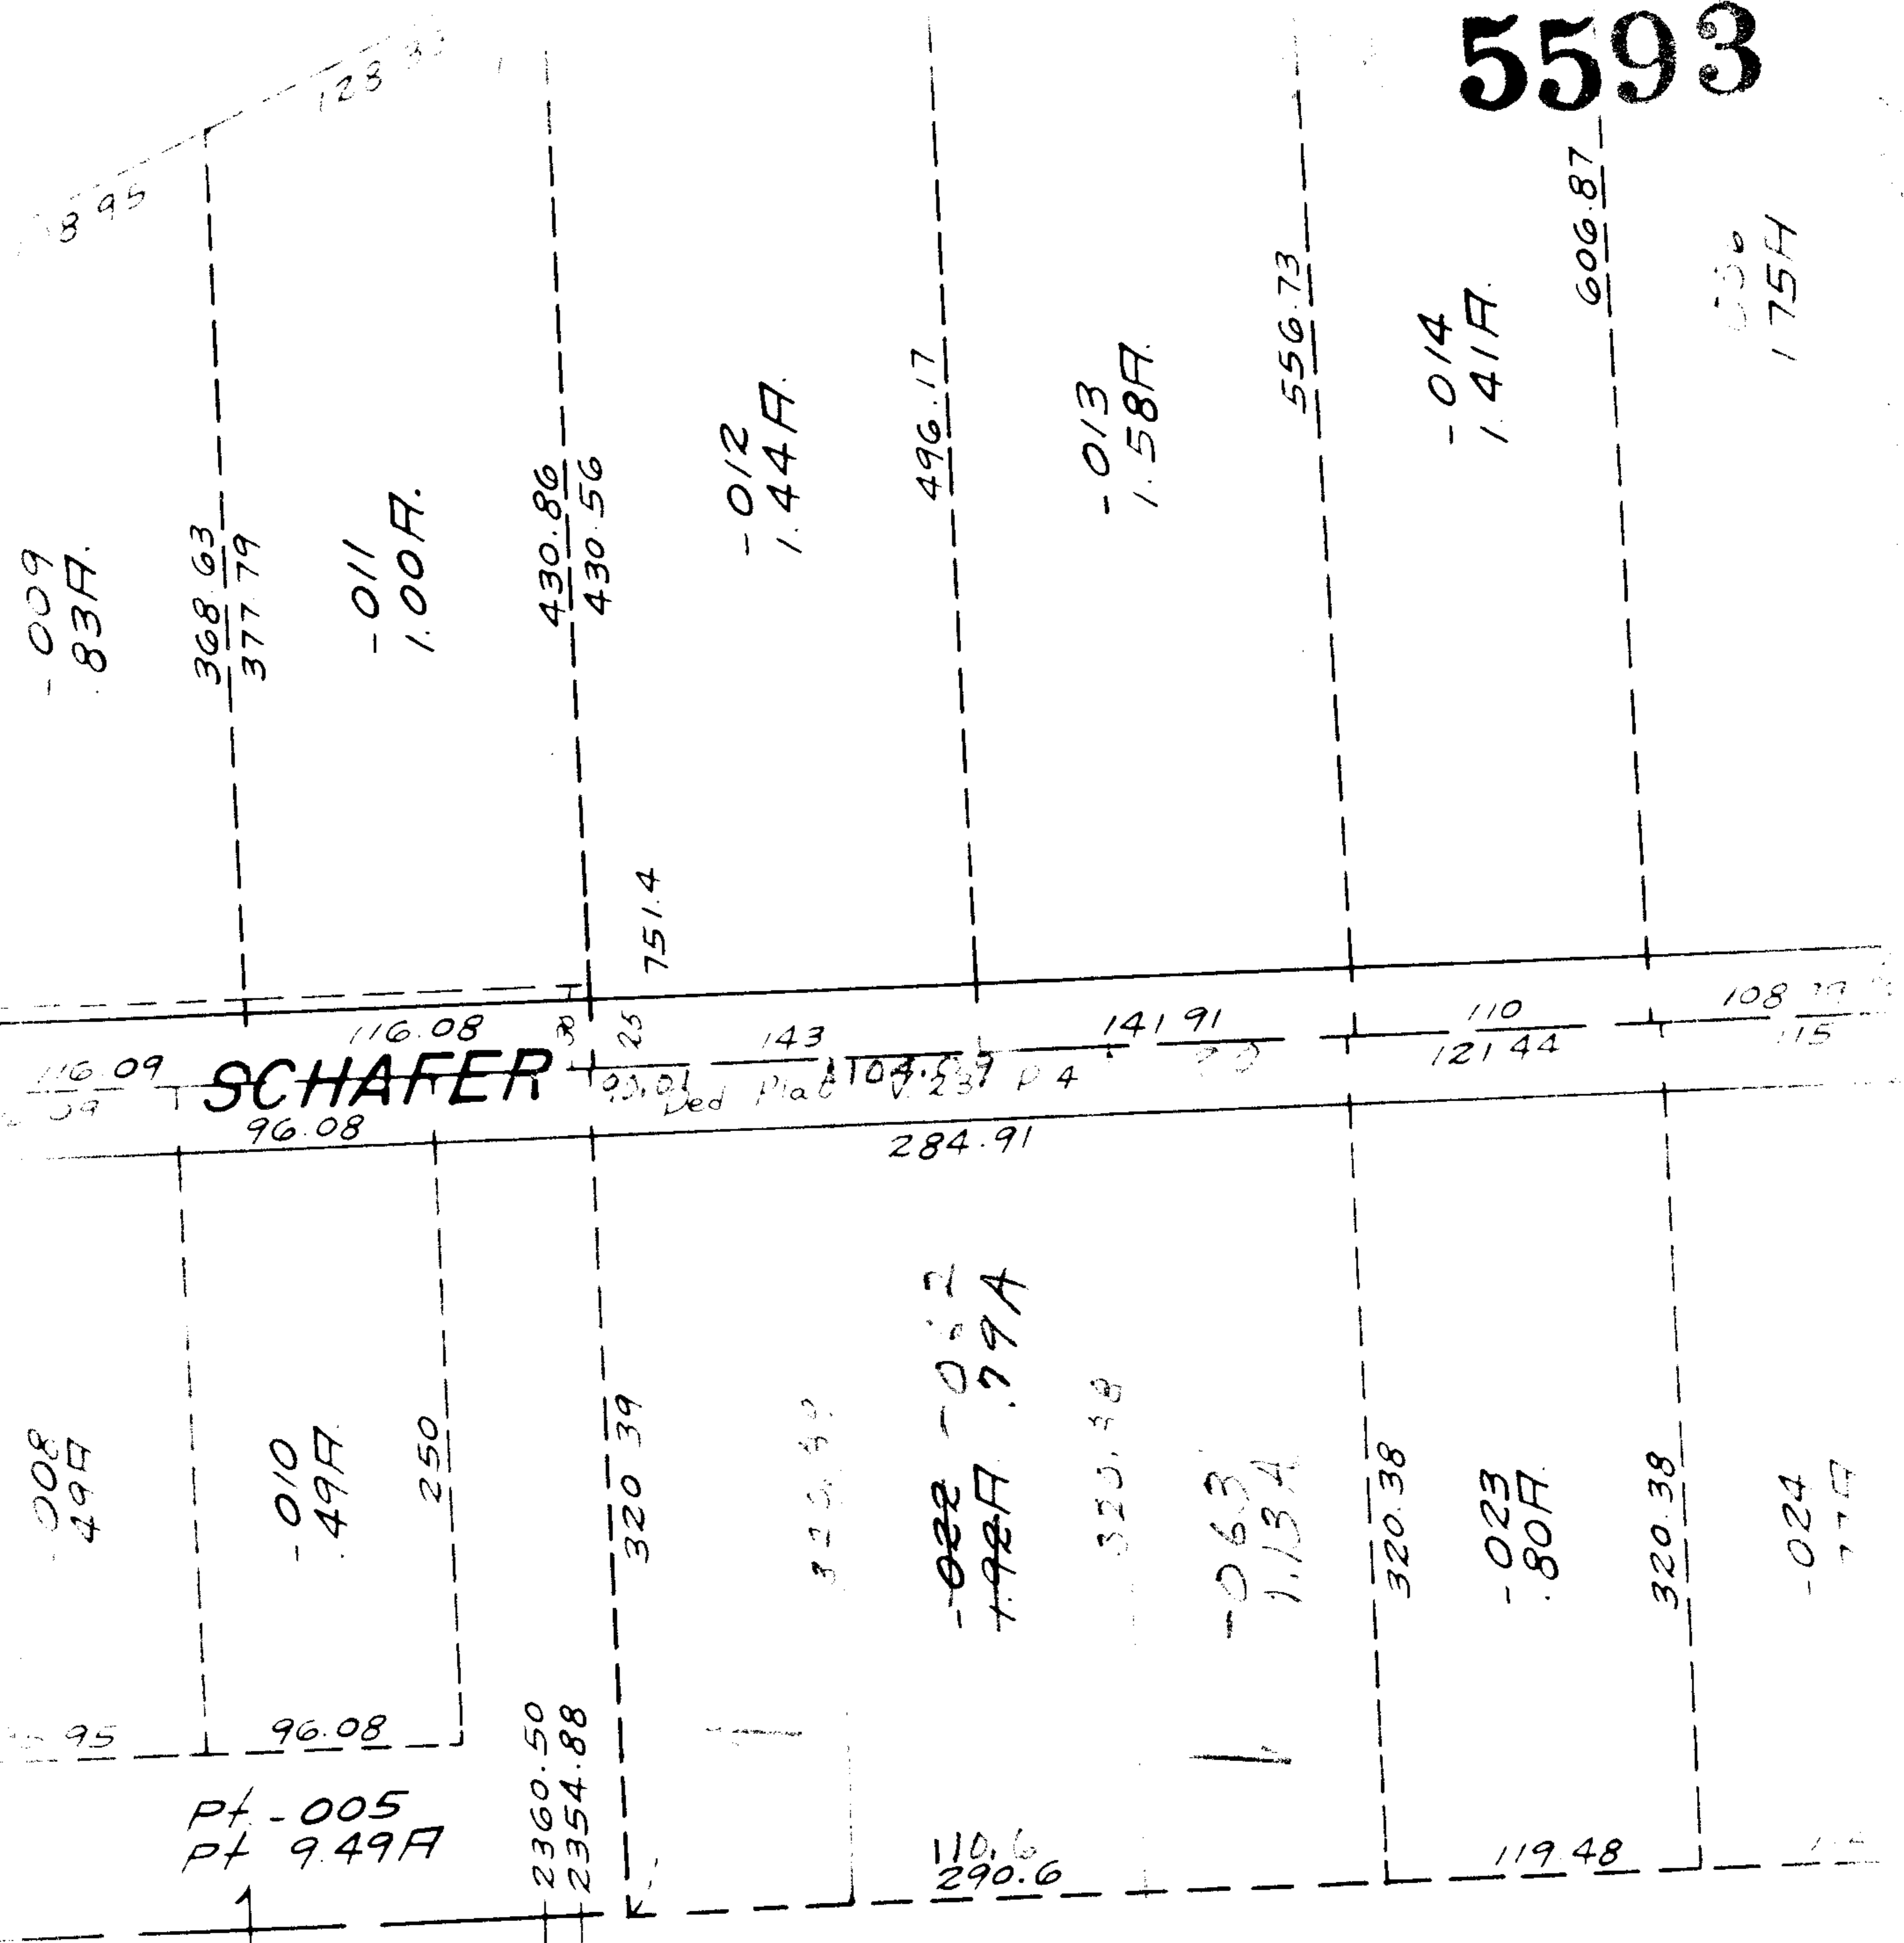

SEE 7-00-028-C

MAR 17 1972

APPROVED
 LORAIN CO.
 MAP DEPT.
 DATE 1/27/72
 7-00-028-A
 BY R. K. King

RIDGEVILLE TWP